



SEE SHEET 4 FOR PROFILES
OF CROSS-COUNTRY SEWER
AND STORM-DRAIN LINES

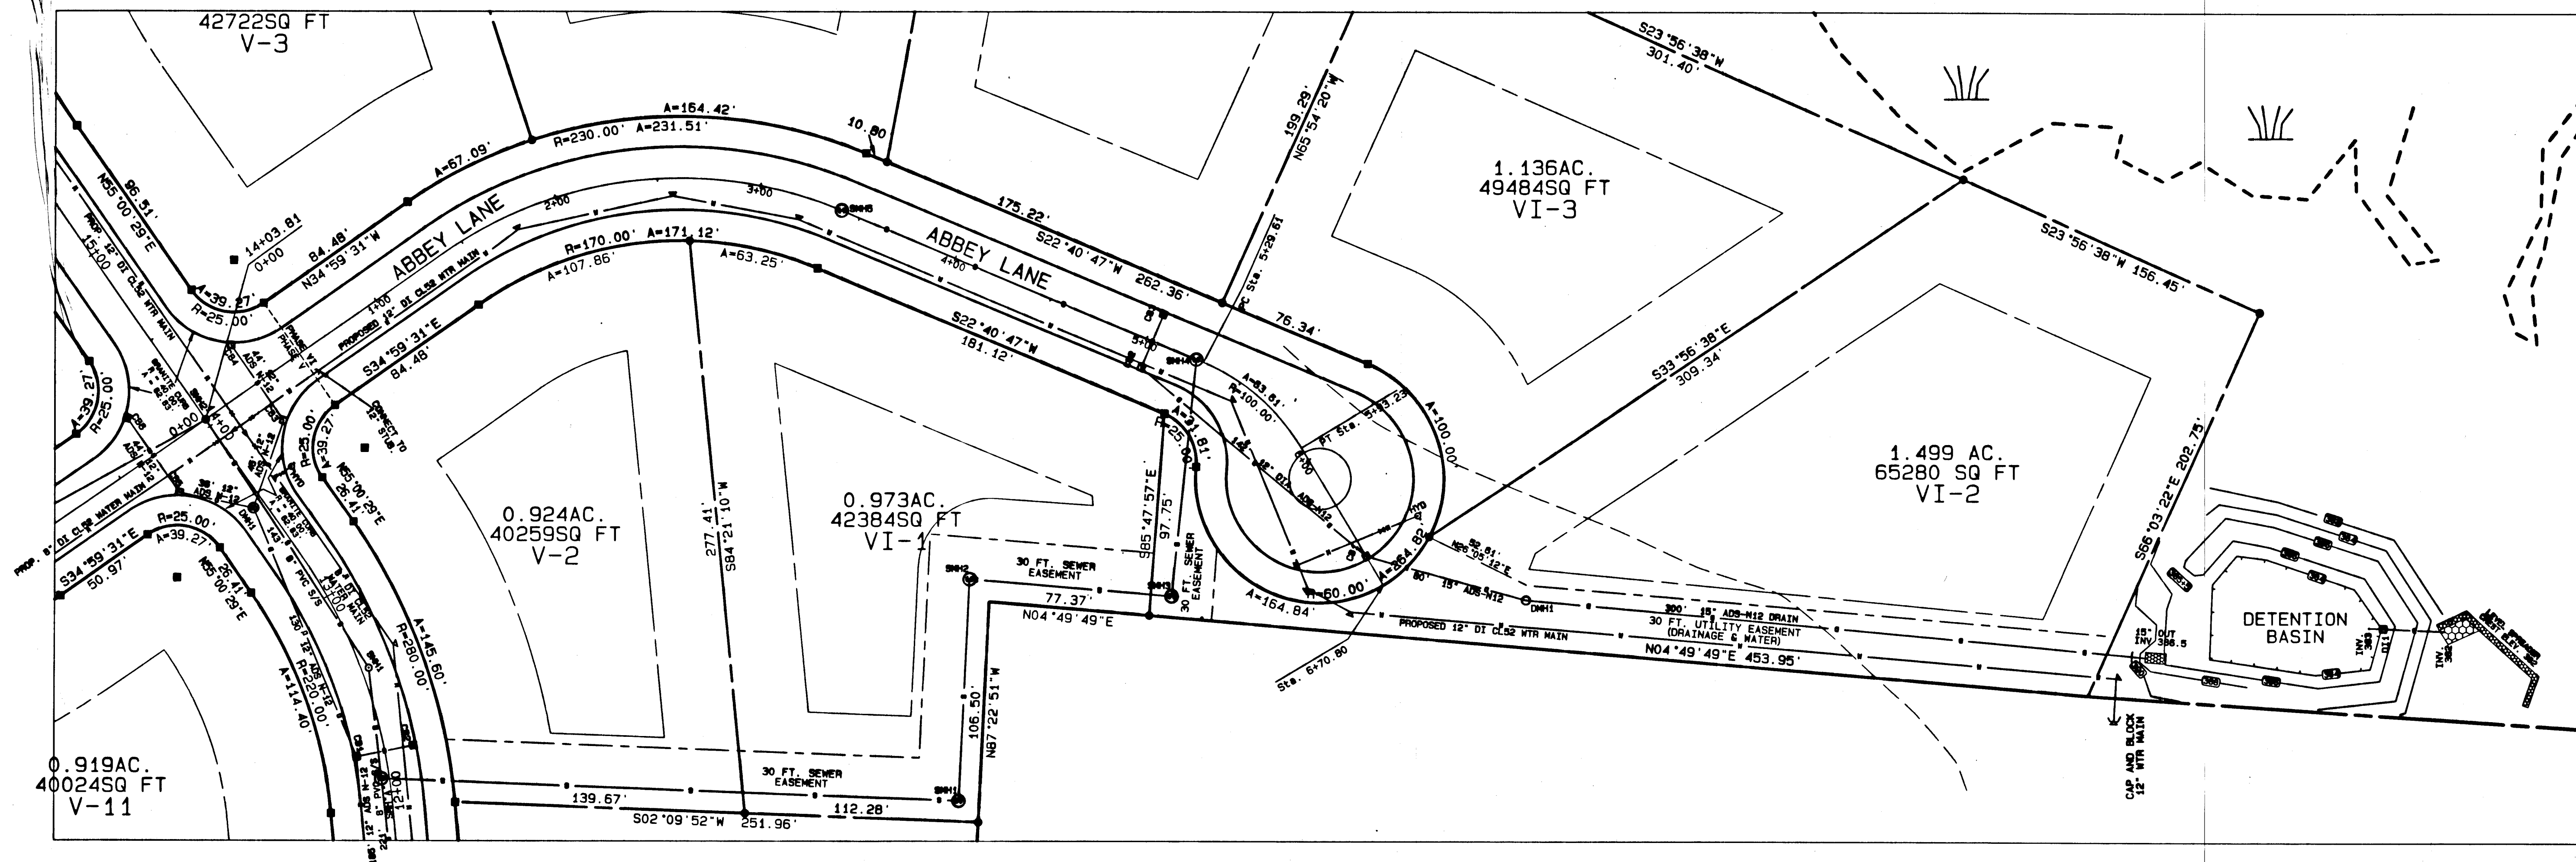

- LEGEND**
- 100 — EXISTING CONTOURS
 - - - 100 - - - PROPOSED CONTOURS
 - - - WETLAND EDGE
 - - - 100 FT. BUFFER ZONE
 - - - SILT FENCE
 - - - HAYBALE BARRIER
 - - - PROPERTY/LOT LINE
 - - - PROP. STORM DRAIN
 - - - PROP. SANITARY SEWER

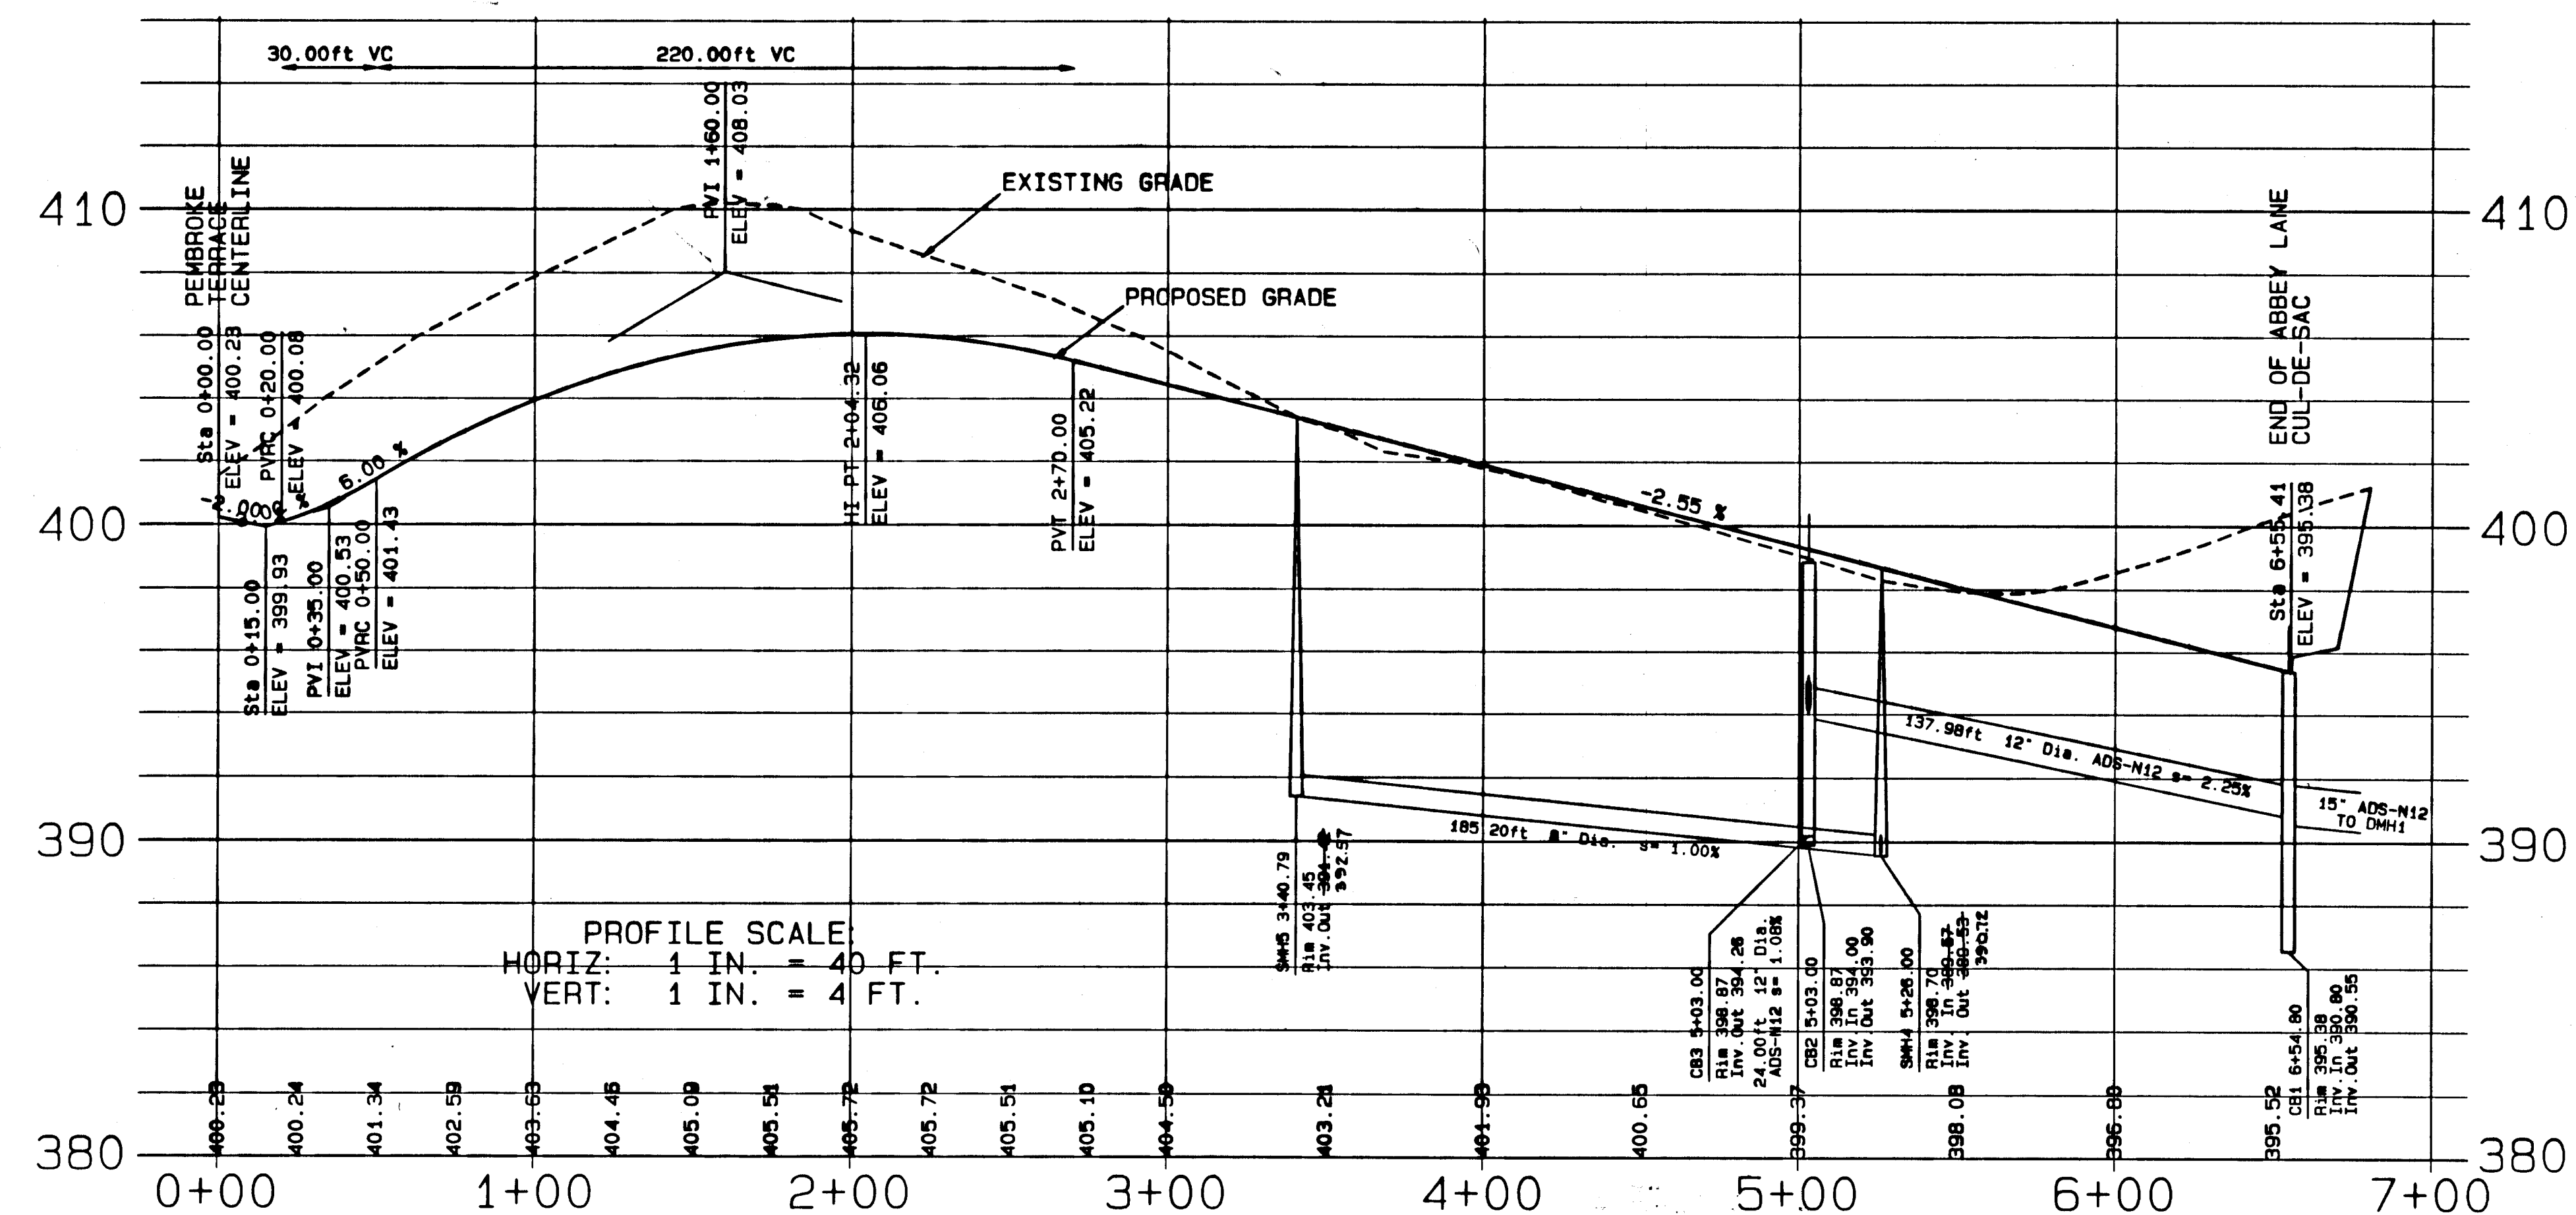

**PLAN & PROFILE
ABBEY LANE**
GREAT WOODS SUBDIVISION, PHASE VI
EAST LONGMEADOW, MASS

OWNED BY
SIVAD NOMINEE TRUST
PREPARED FOR
DAN ROULIER & ASSOCIATES

INVERTS CORRECTED 10-8-03
DATE: 6/2/03

**SMITH ASSOCIATES
SURVEYORS, INC.**

185 SHAKER RD., EAST LONGMEADOW, MASS. 01028

APPROVED BY THE EAST LONGMEADOW PLANNING BOARD
DATE: 11-04-03
Sam Starks
CHAIRMAN