



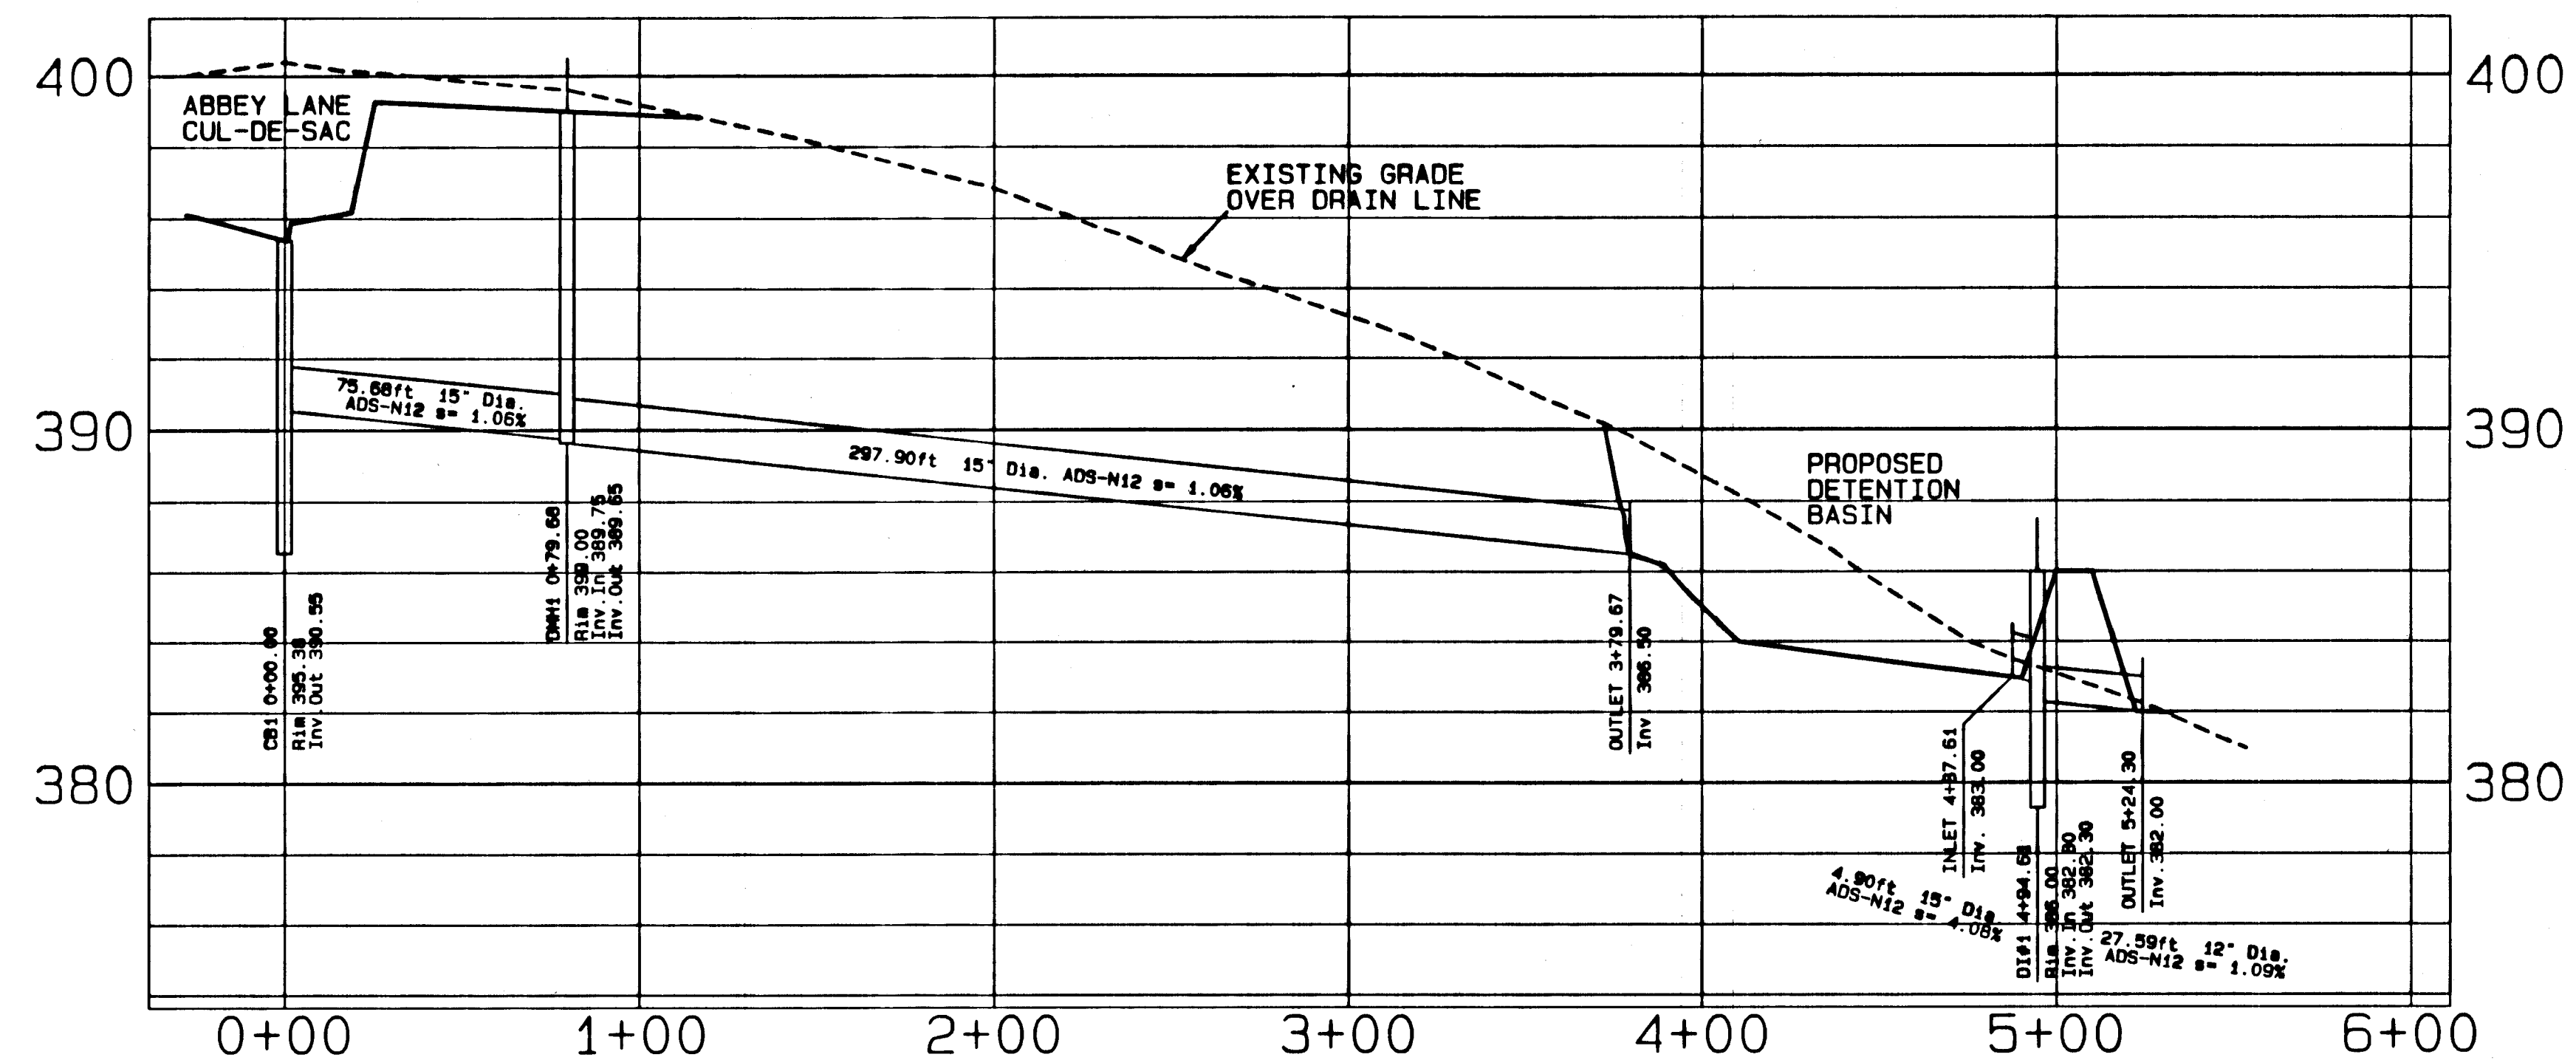

STORM DRAIN PROFILE - ABBEY LANE CUL-DE-SAC TO DETENTION BASIN

PROFILE SCALE:
HORIZ: 1 IN. = 40 FT.
VERT: 1 IN. = 4 FT.


SEE SHEETS 2 & 3 FOR ALIGNMENT
OF CROSS-COUNTRY SEWER
AND STORM-RAIN LINES

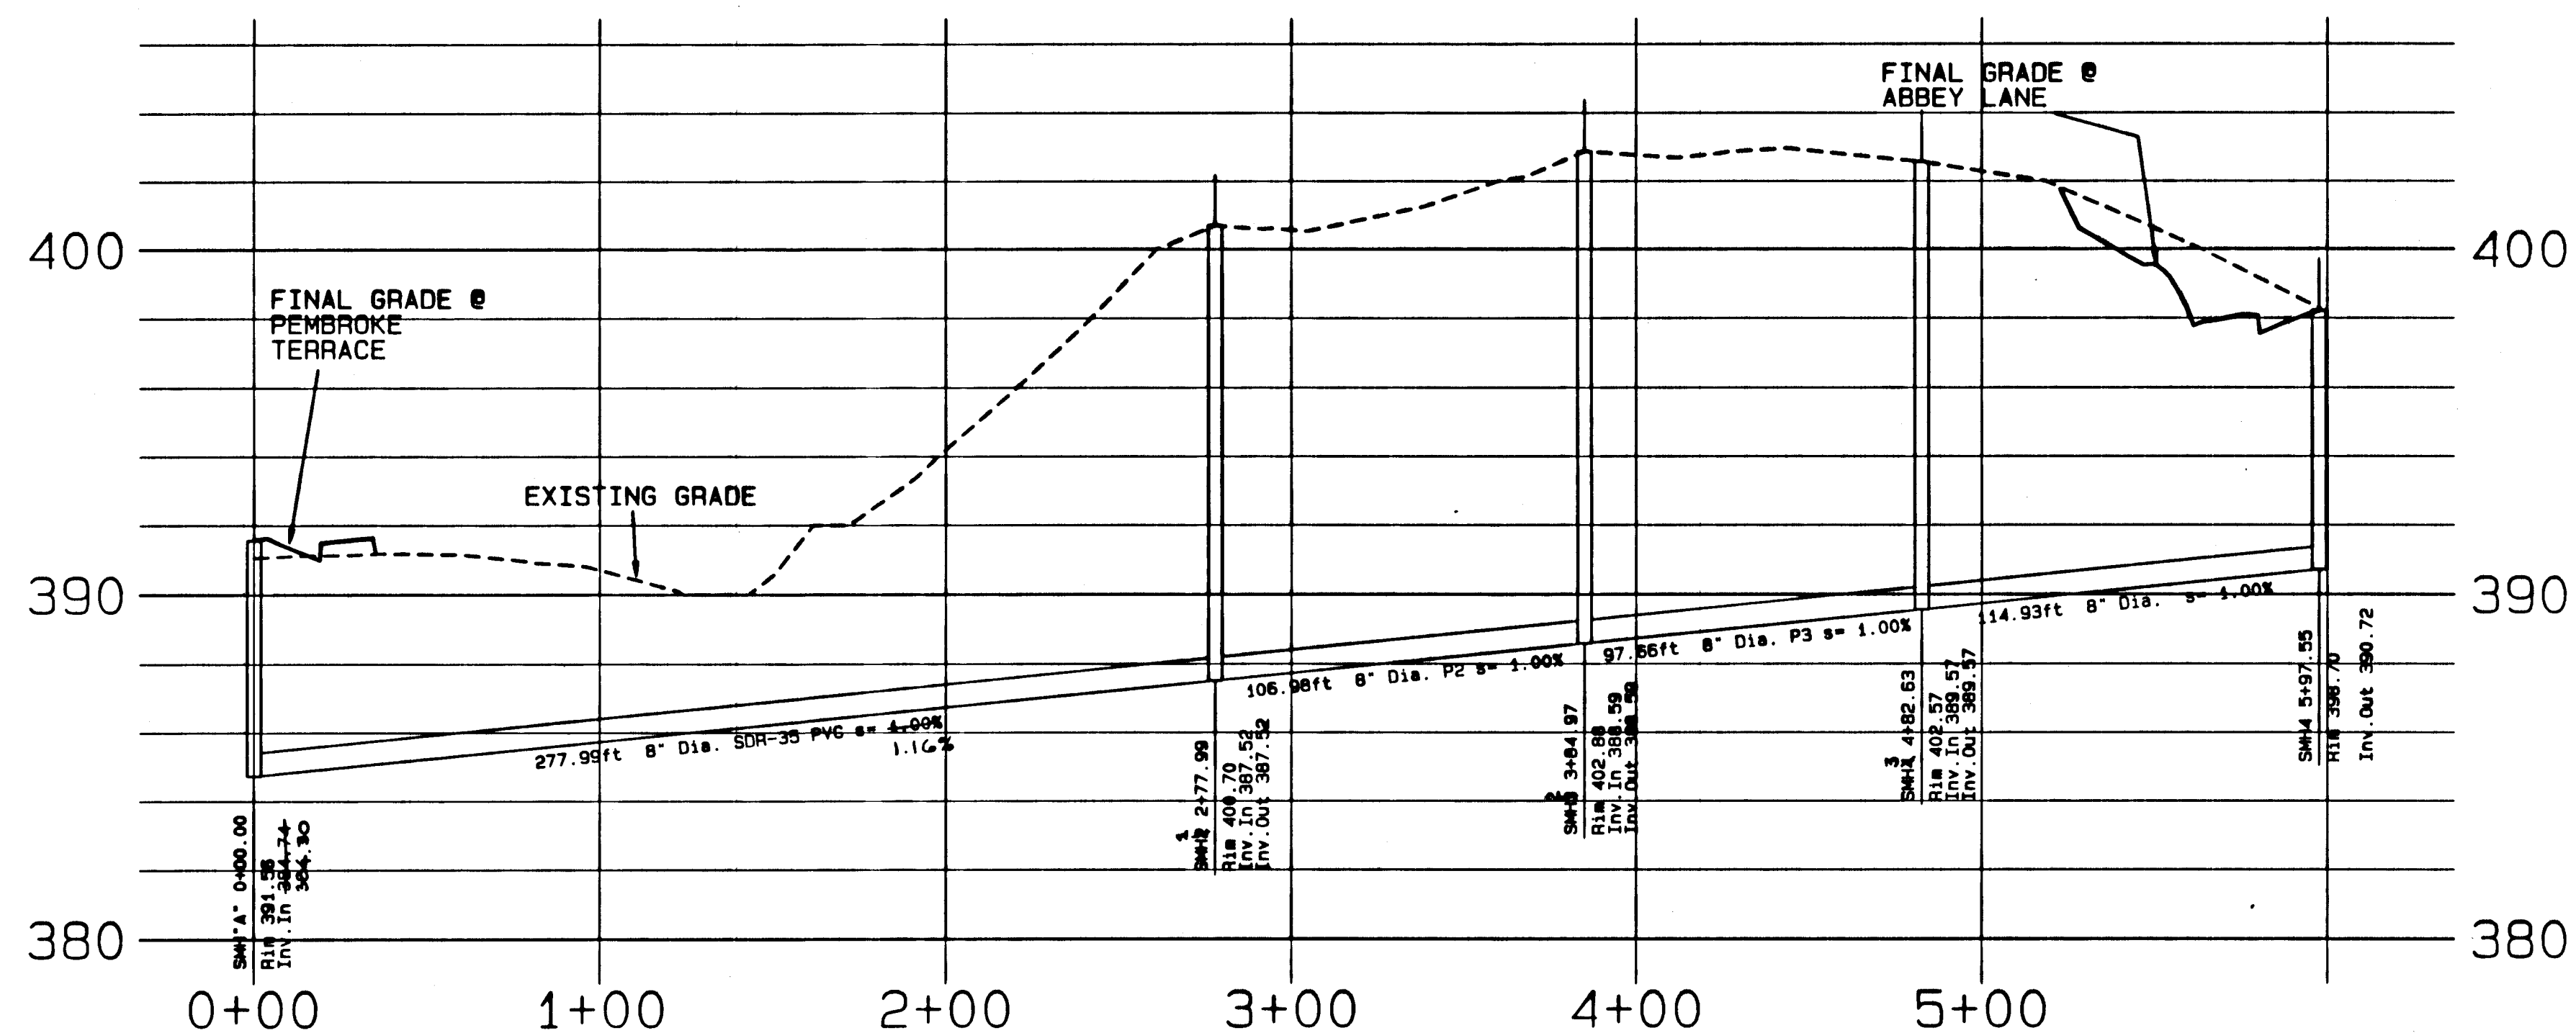

SANITARY SEWER PROFILE - PEMBROKE TERRACE TO ABBEY LANE CUL-DE-SAC

CROSS-COUNTRY PROFILES
SANITARY SEWER
& STORM DRAIN
FOR ABBEY LANE
GREAT WOODS SUBDIVISION, PHASE VI
EAST LONGMEADOW, MASS

OWNED BY
SIVAD NOMINEE TRUST
PREPARED FOR
DAN ROULIER & ASSOCIATES

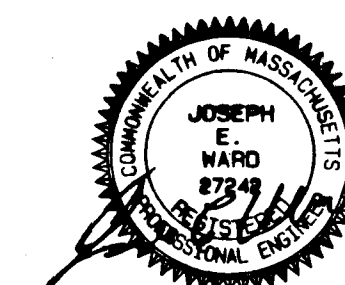

INVERTS CORRECTED 10-8-03

DATE: 6/2/03

SHEET 4

SMITH ASSOCIATES
SURVEYORS, INC.

165 SHAKER RD., EAST LONGMEADOW, MASS. 01026

APPROVED BY THE EAST LONGMEADOW PLANNING BOARD

DATE: 11-04-03

Si M. Stank
CHAIRMAN