


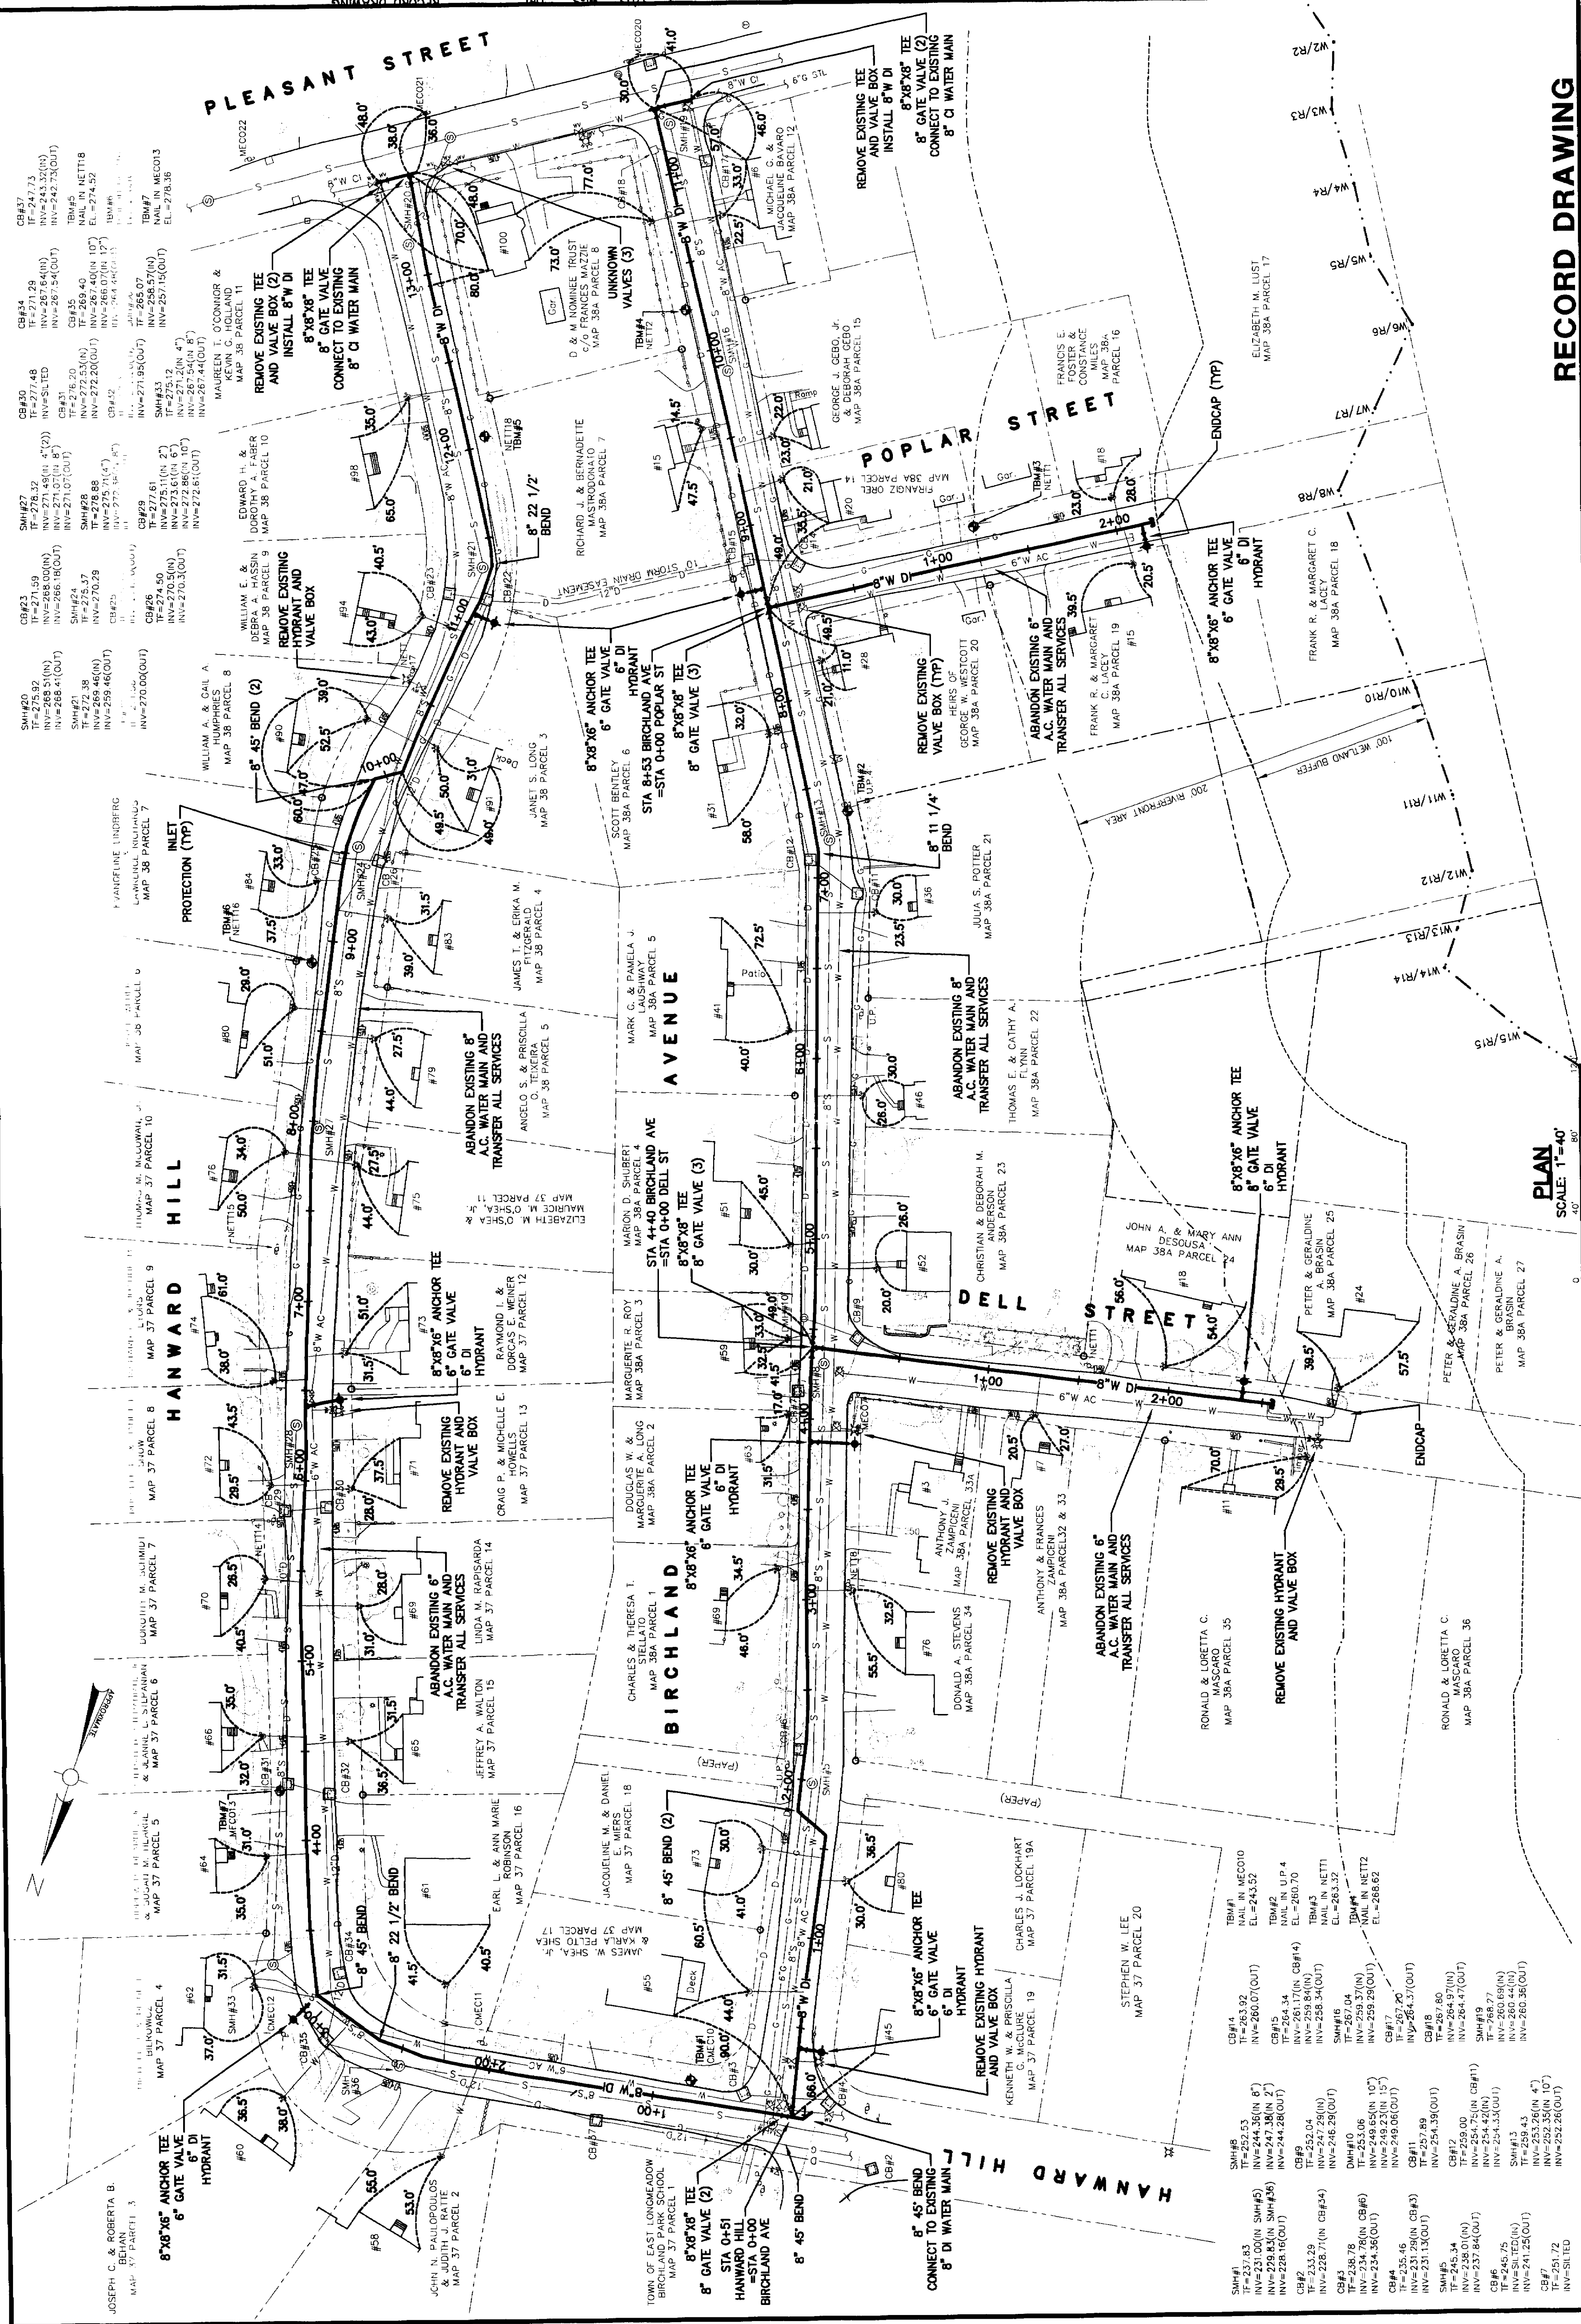

RECORD DRAWING

PLAN