


RECORD DRAWING

PLAN
SCALE: 1"=40'



PLAN
SCALE: 1"=40'

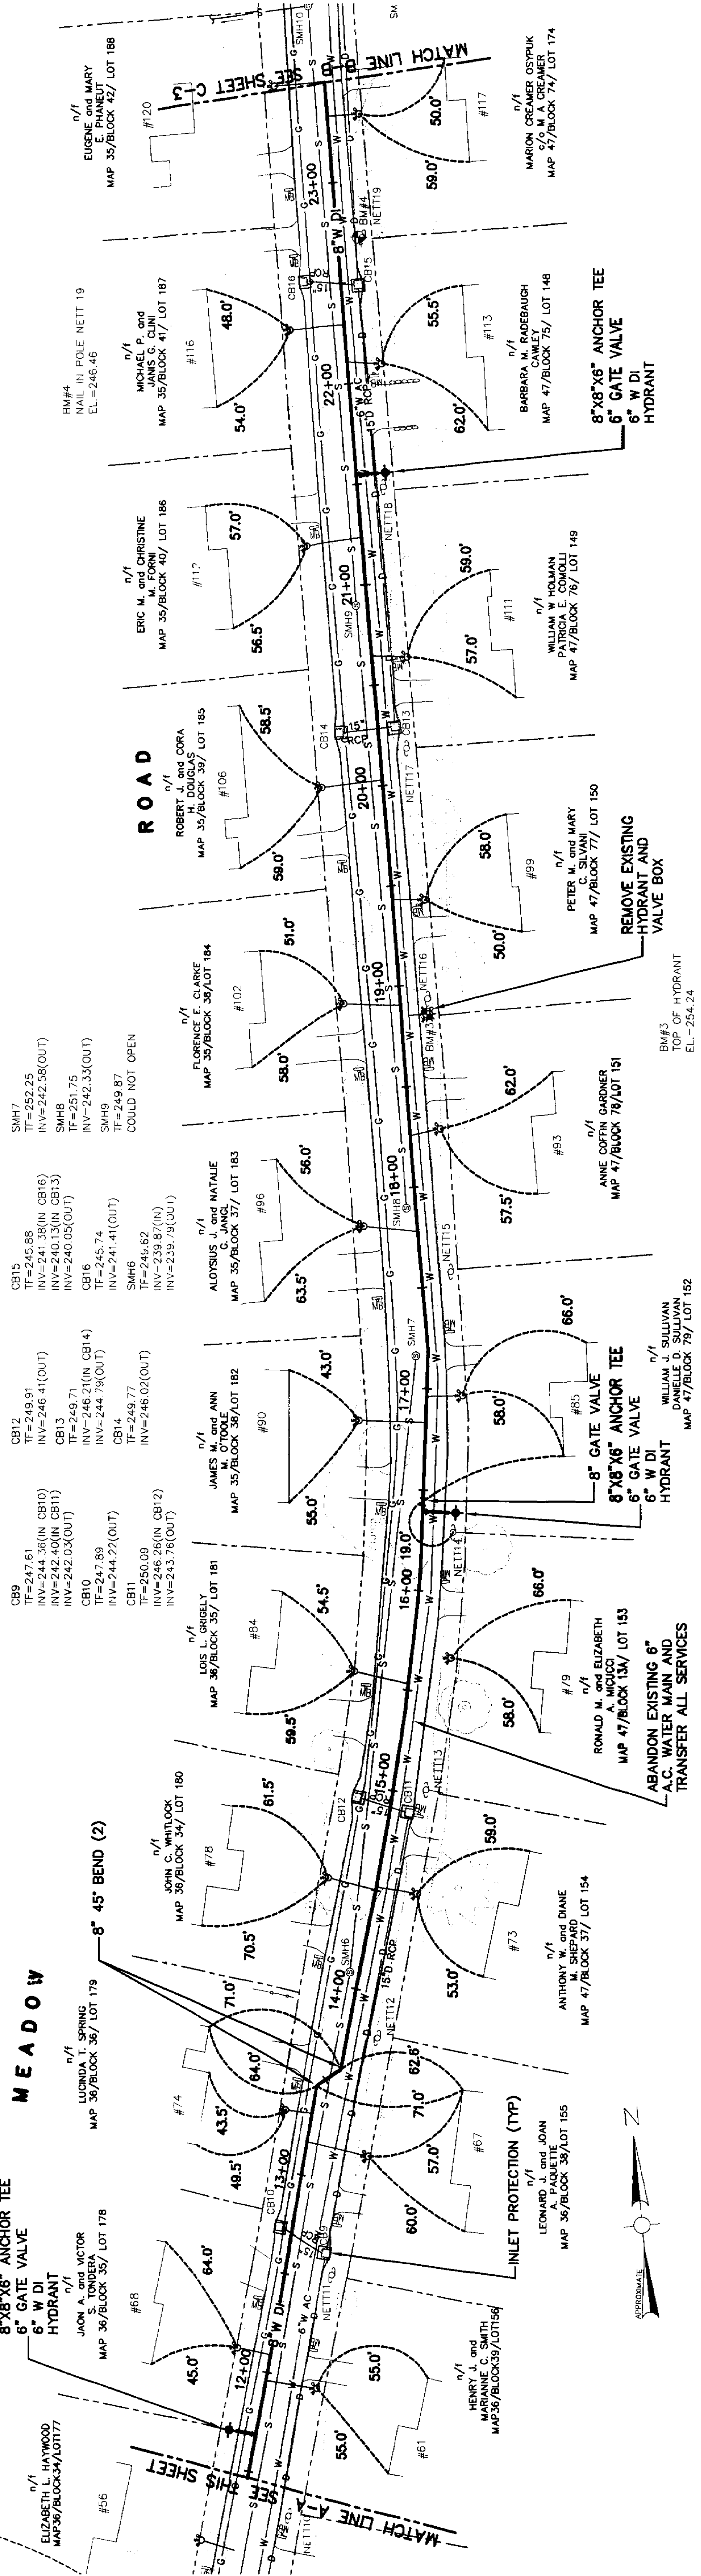