


	WESTON & SAMPSON ENGINEERS, INC.		DATE _____	
	REGISTERED PROFESSIONAL ENGINEER		_____	

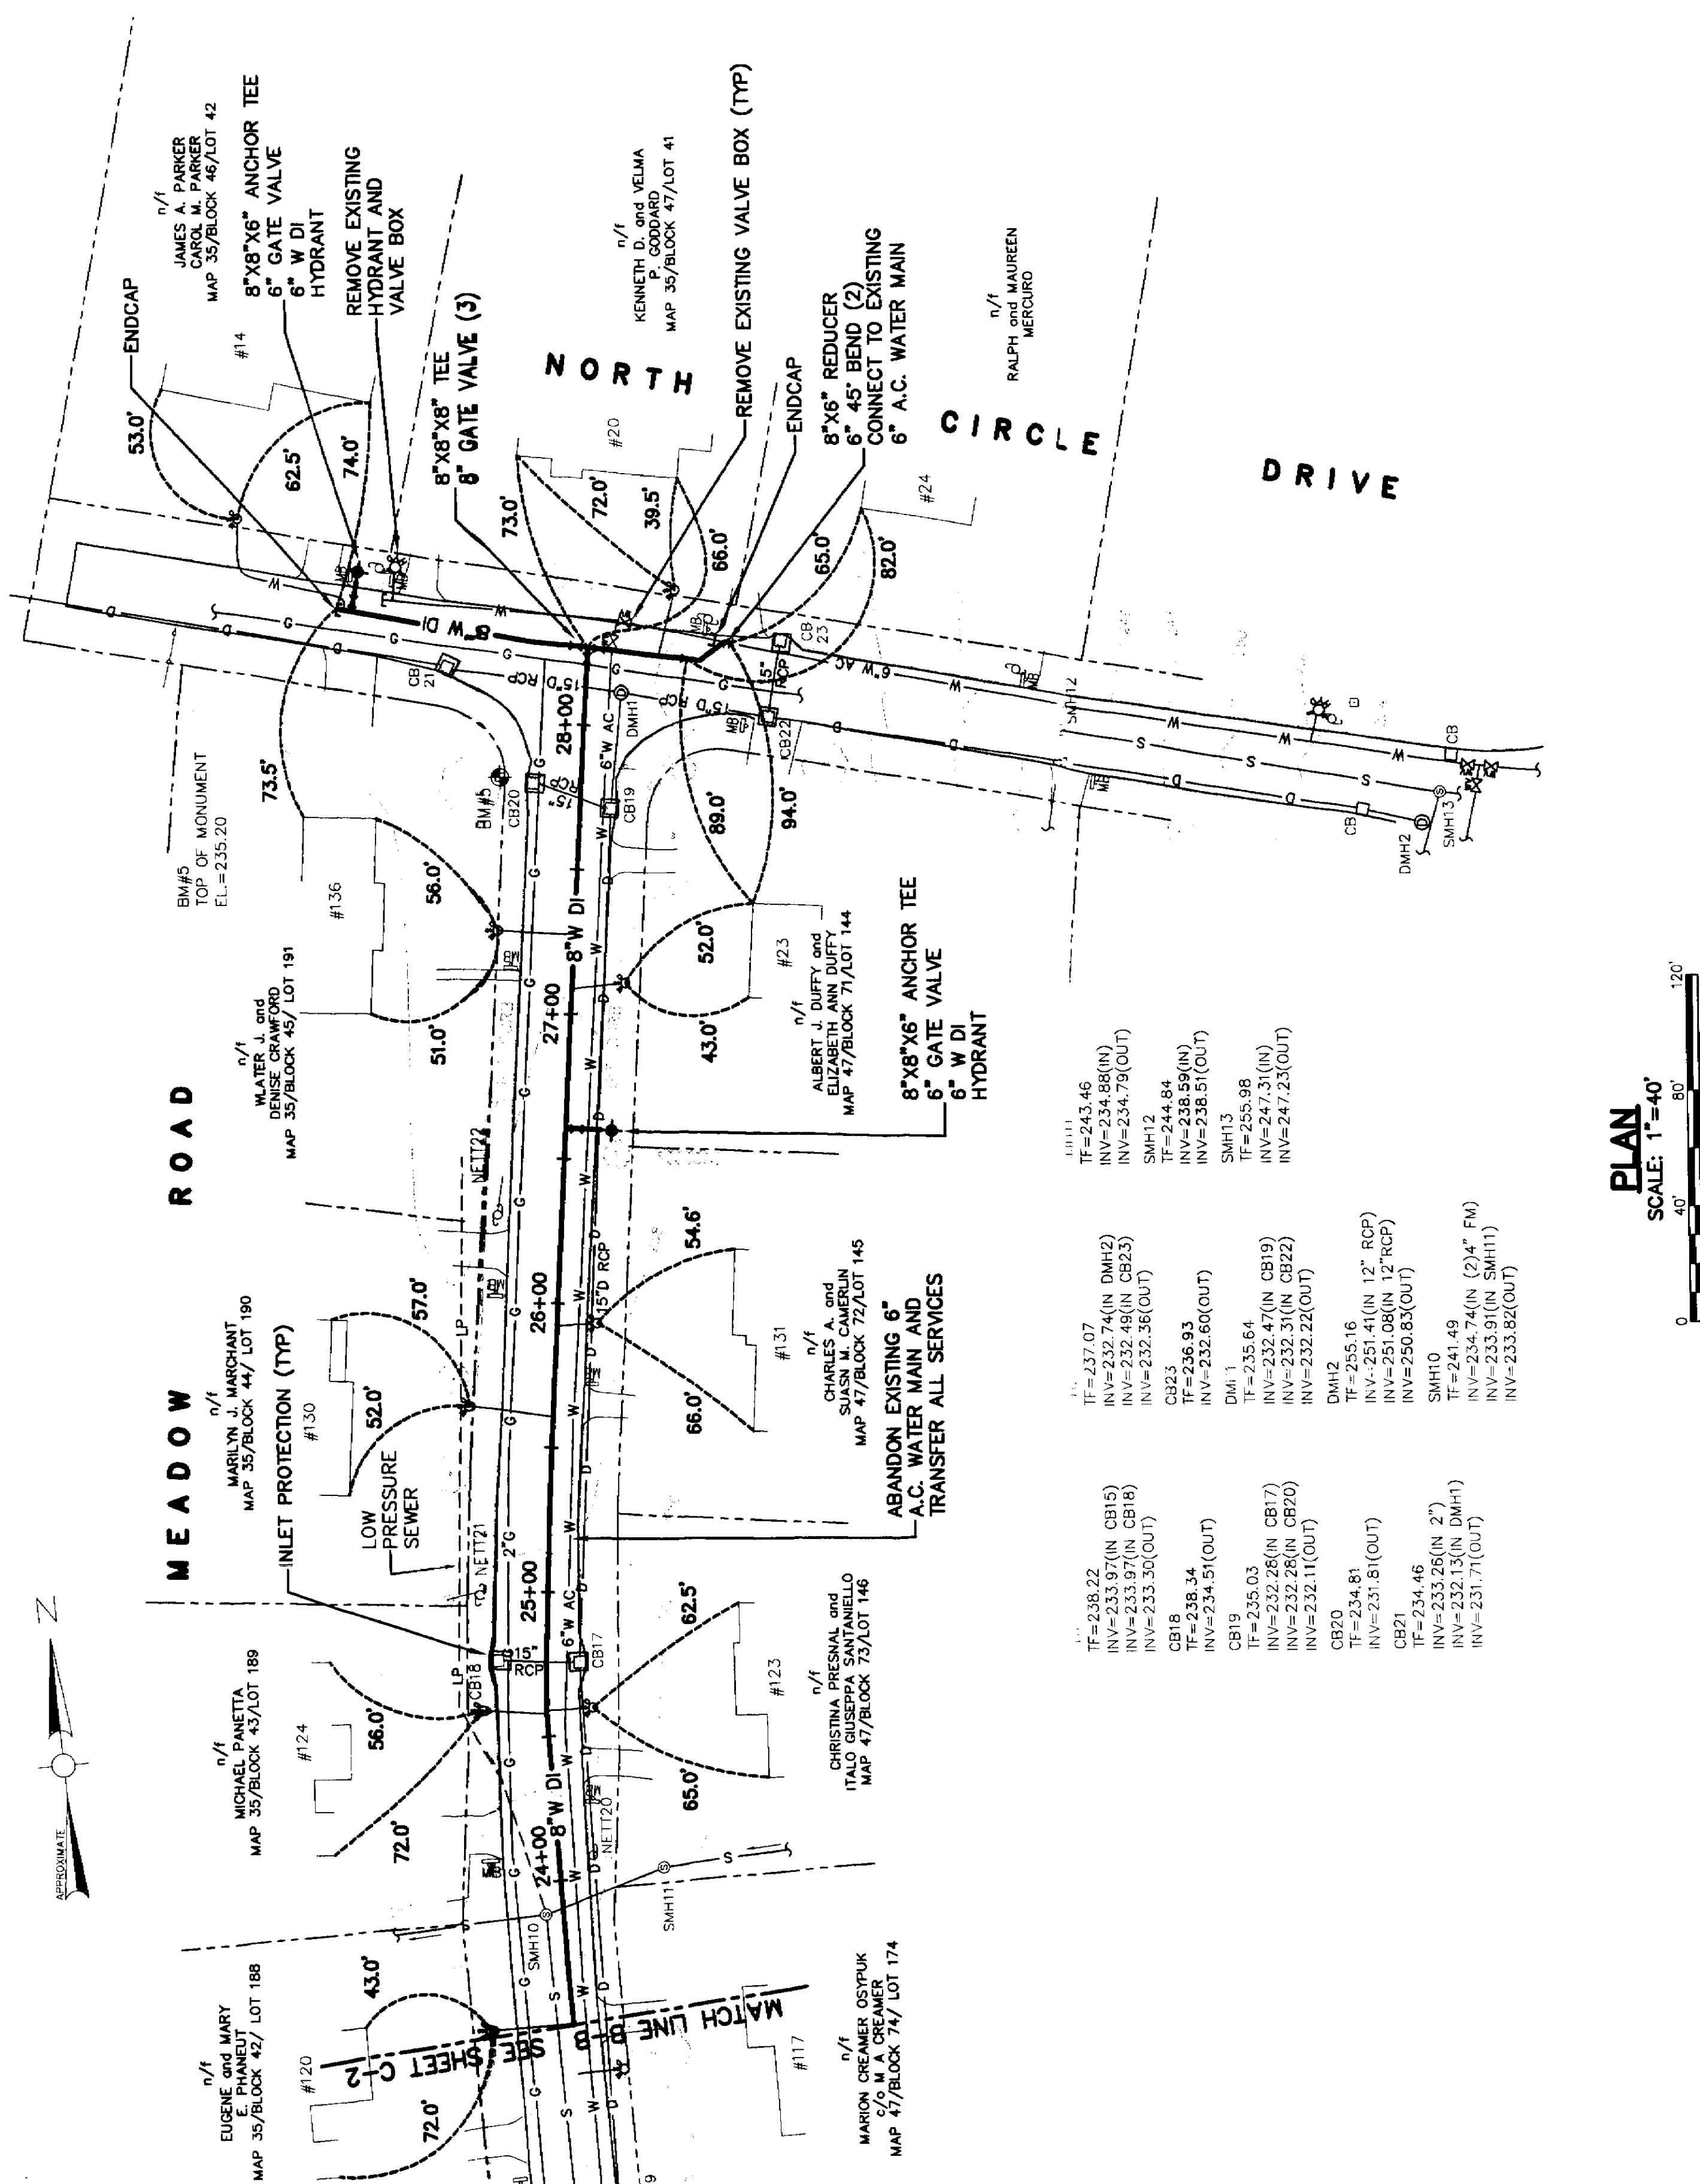

PLAN
SCALE: 1"=40'