
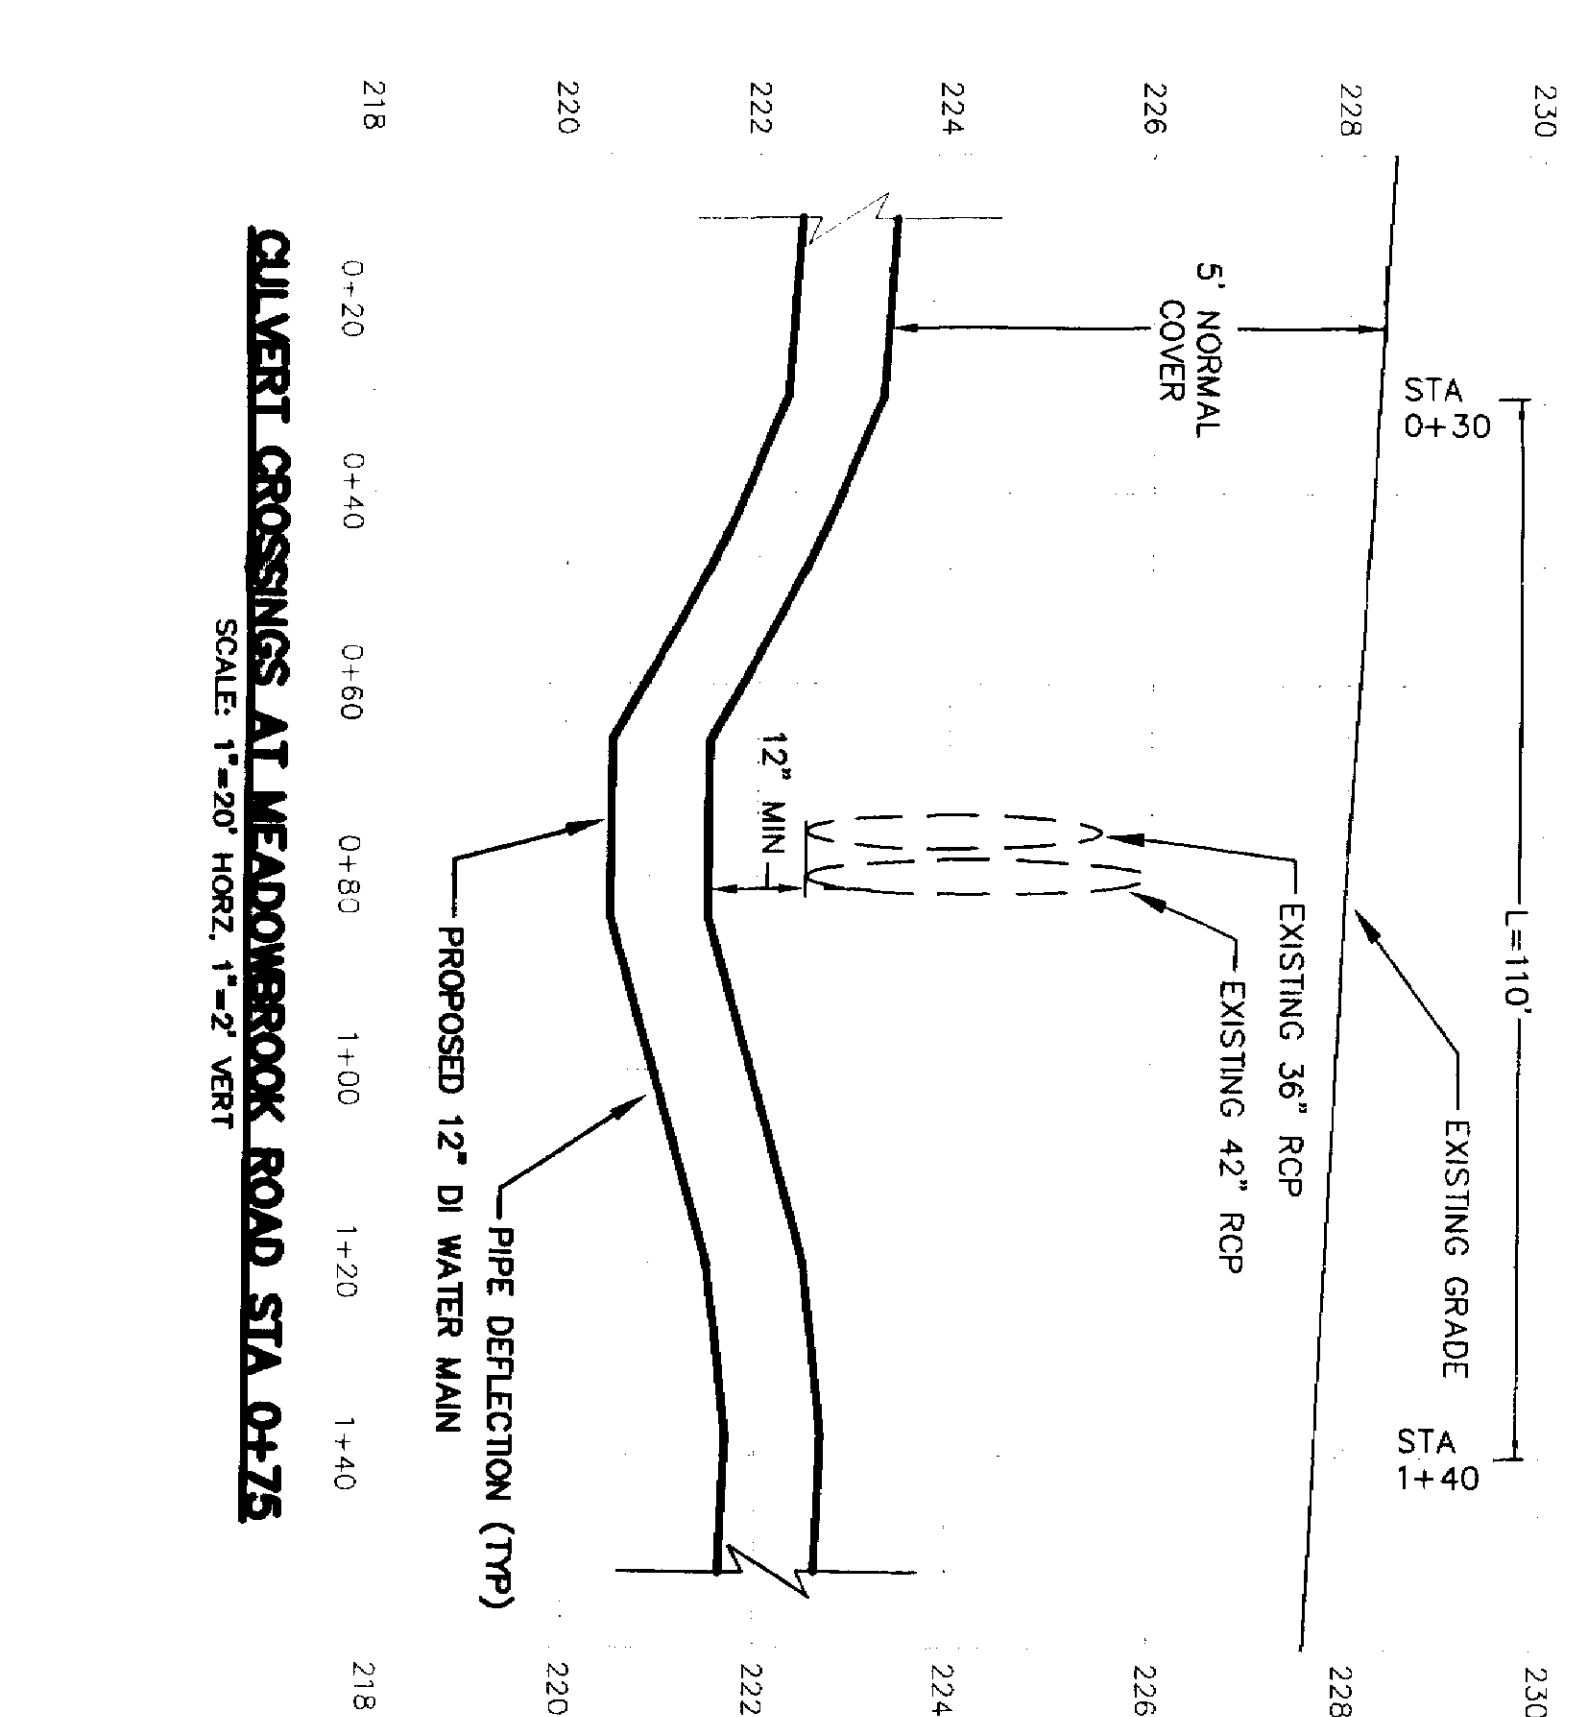
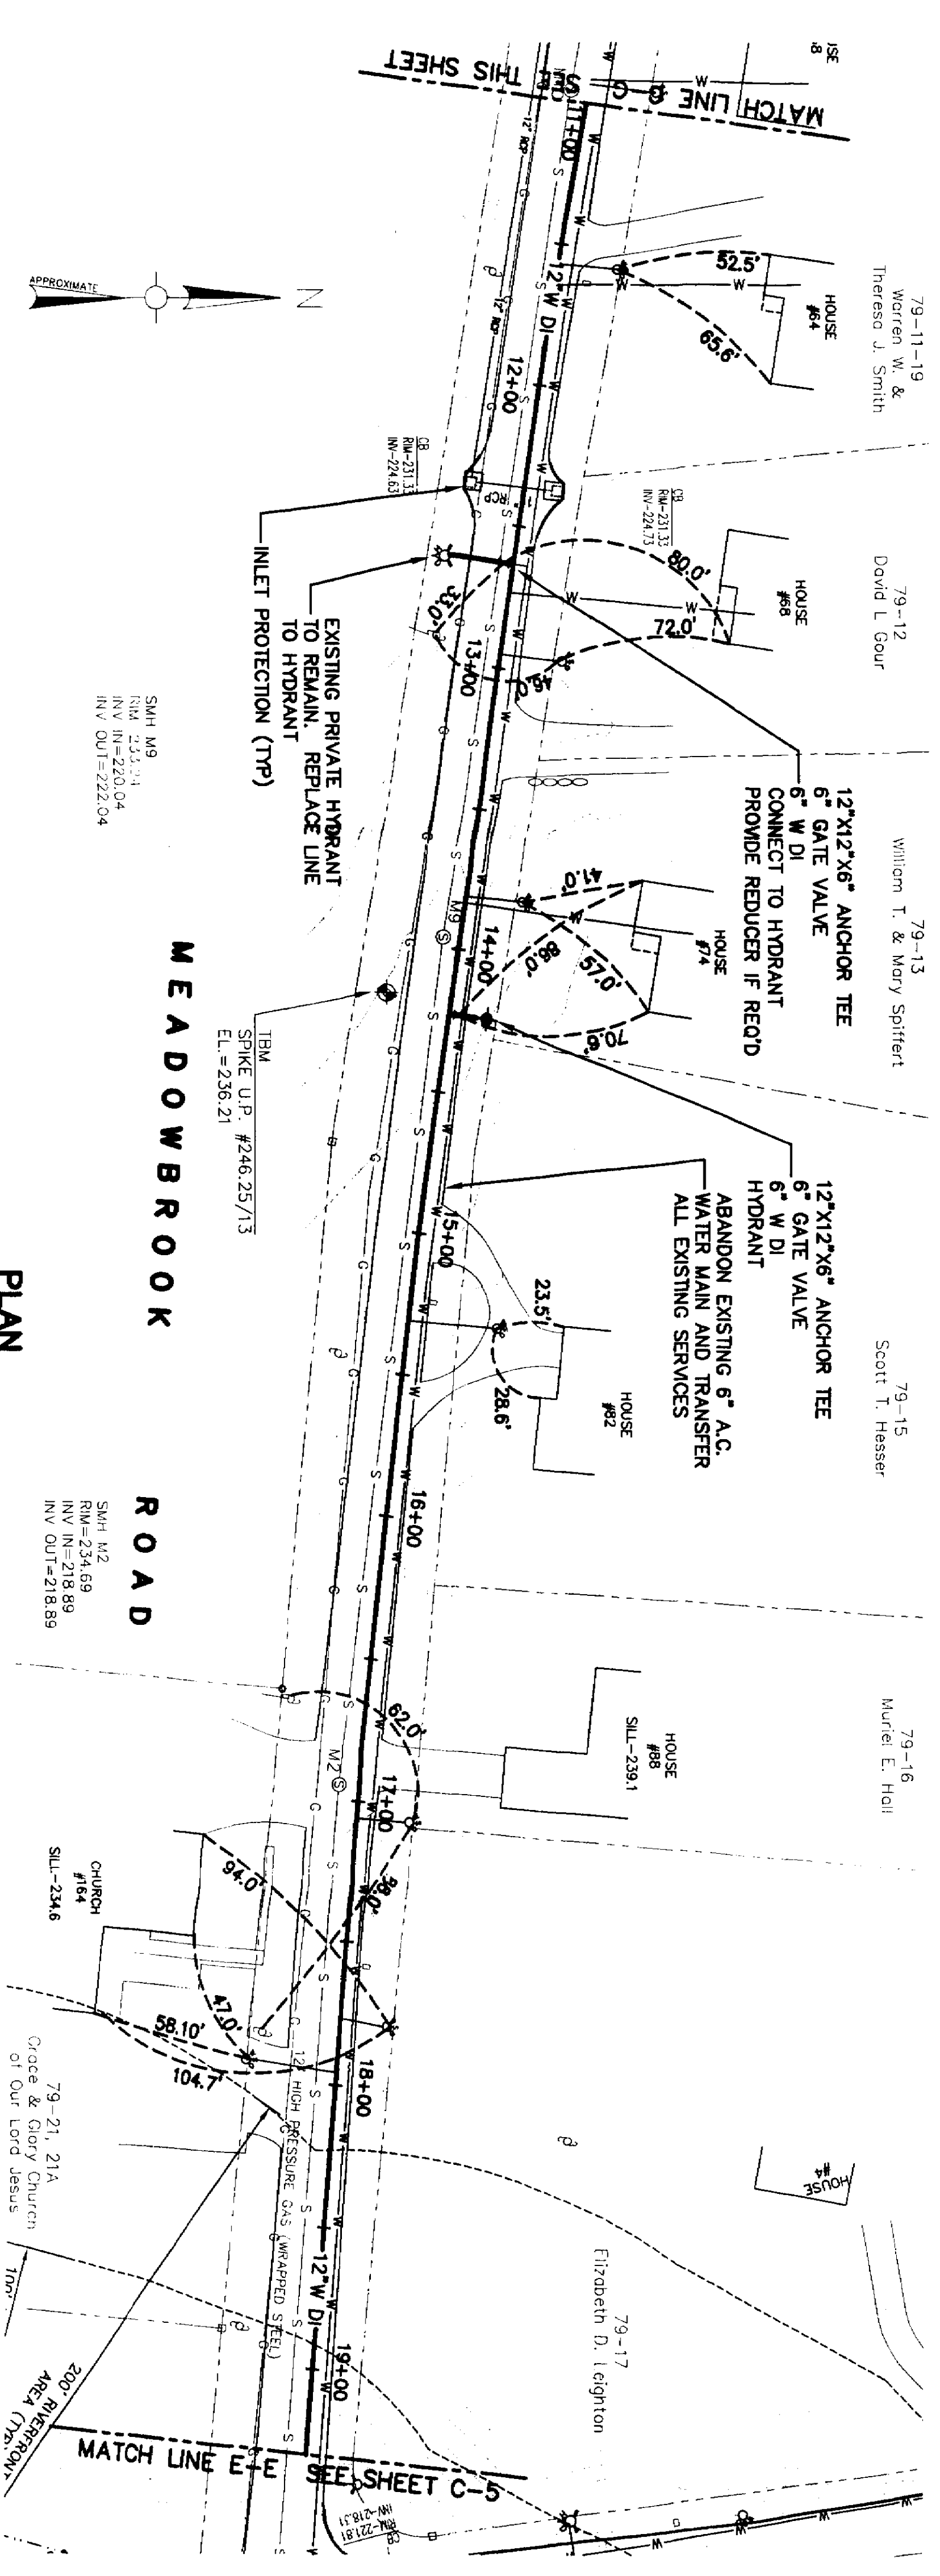


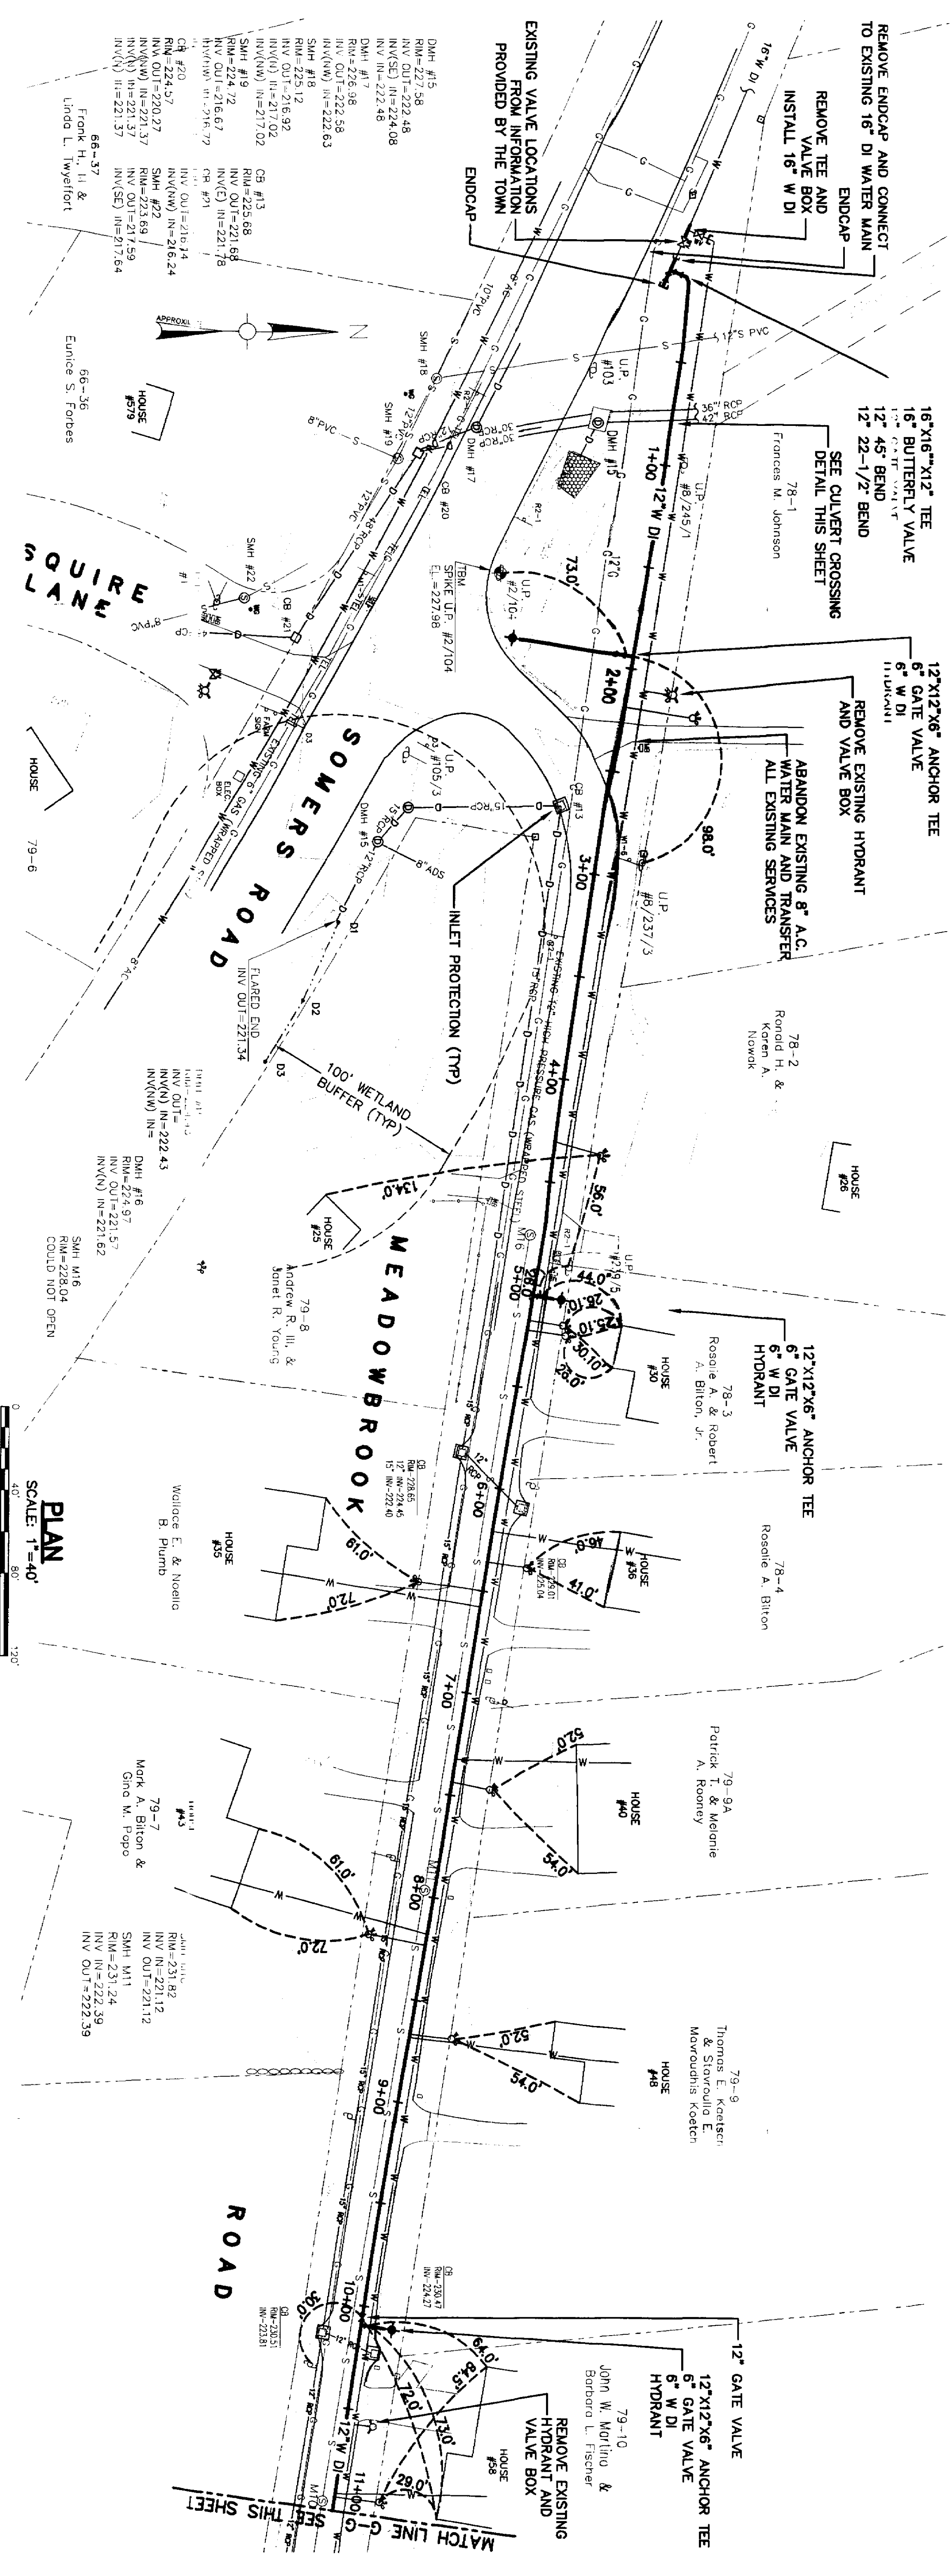

RECORD DRAWING

TOWN OF EAST LONGMEADOW BOARD OF PUBLIC WORKS									
WATER MAIN IMPROVEMENTS PROJECT									
MEADOWBROOK ROAD STA 0+00 TO STA 19+30									
FILE NO.	CADD NO.	SCALE:	CONTRACT:	JOB NO.	DR. BY	DSN. BY	CHK. BY	APP. BY	
141-15	RPARKER	1"=40'		202038	WGS	WGS	DRL	PJC	

2/04				WGS				DRL				RECORD DRAWING			
o. Date				Dr. By				Ck. By				App. By			
A				P				P				R			
O				V				E				D			
REGISTERED PROFESSIONAL ENGINEER												DATE			

Weston & Sampson
ENGINEERS, INC.