
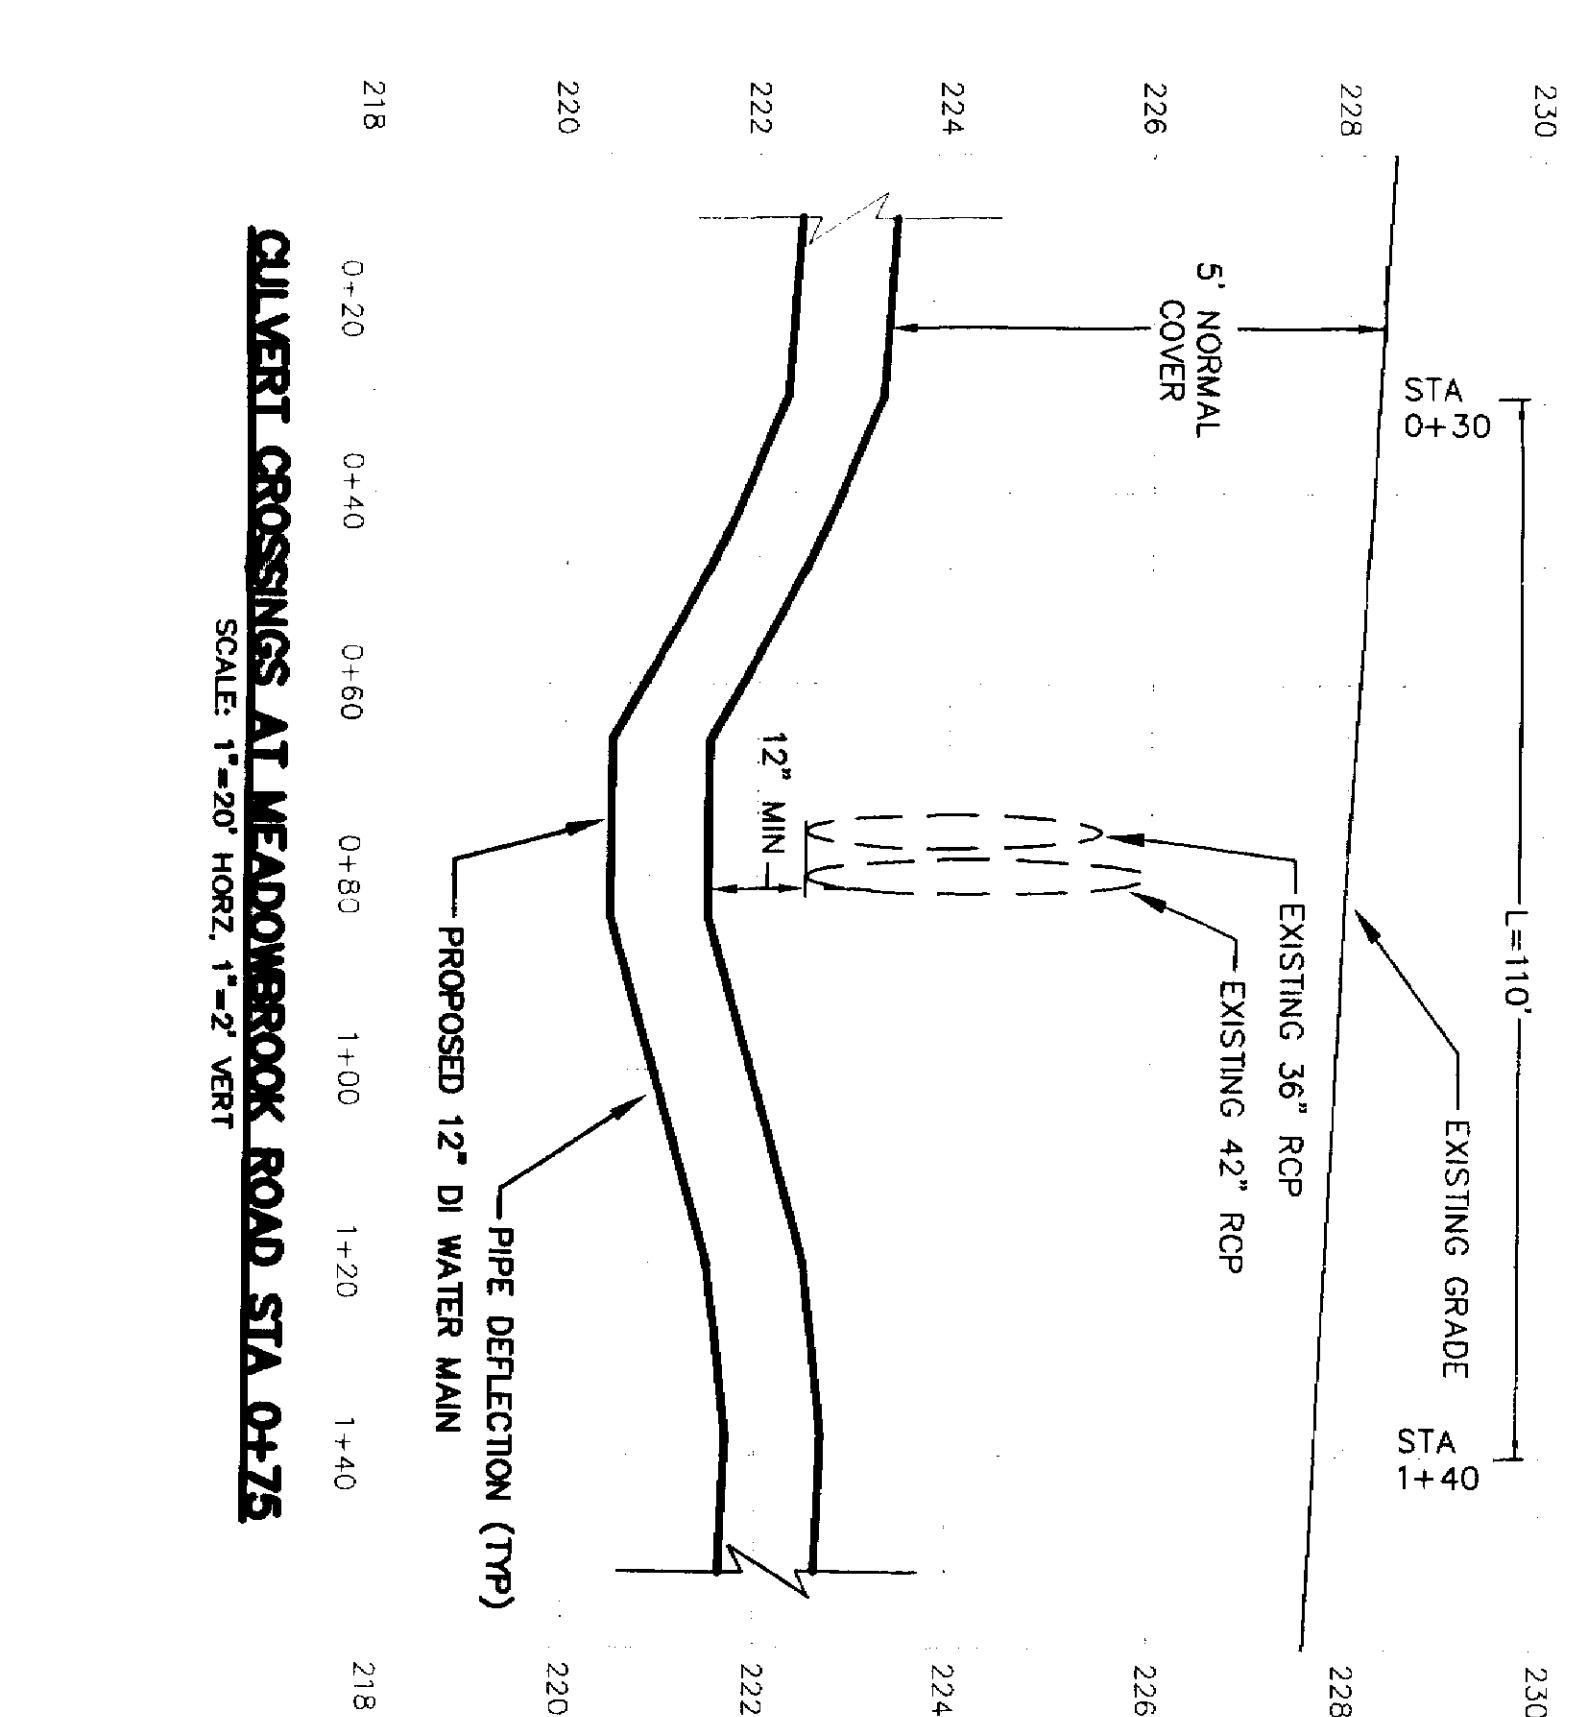
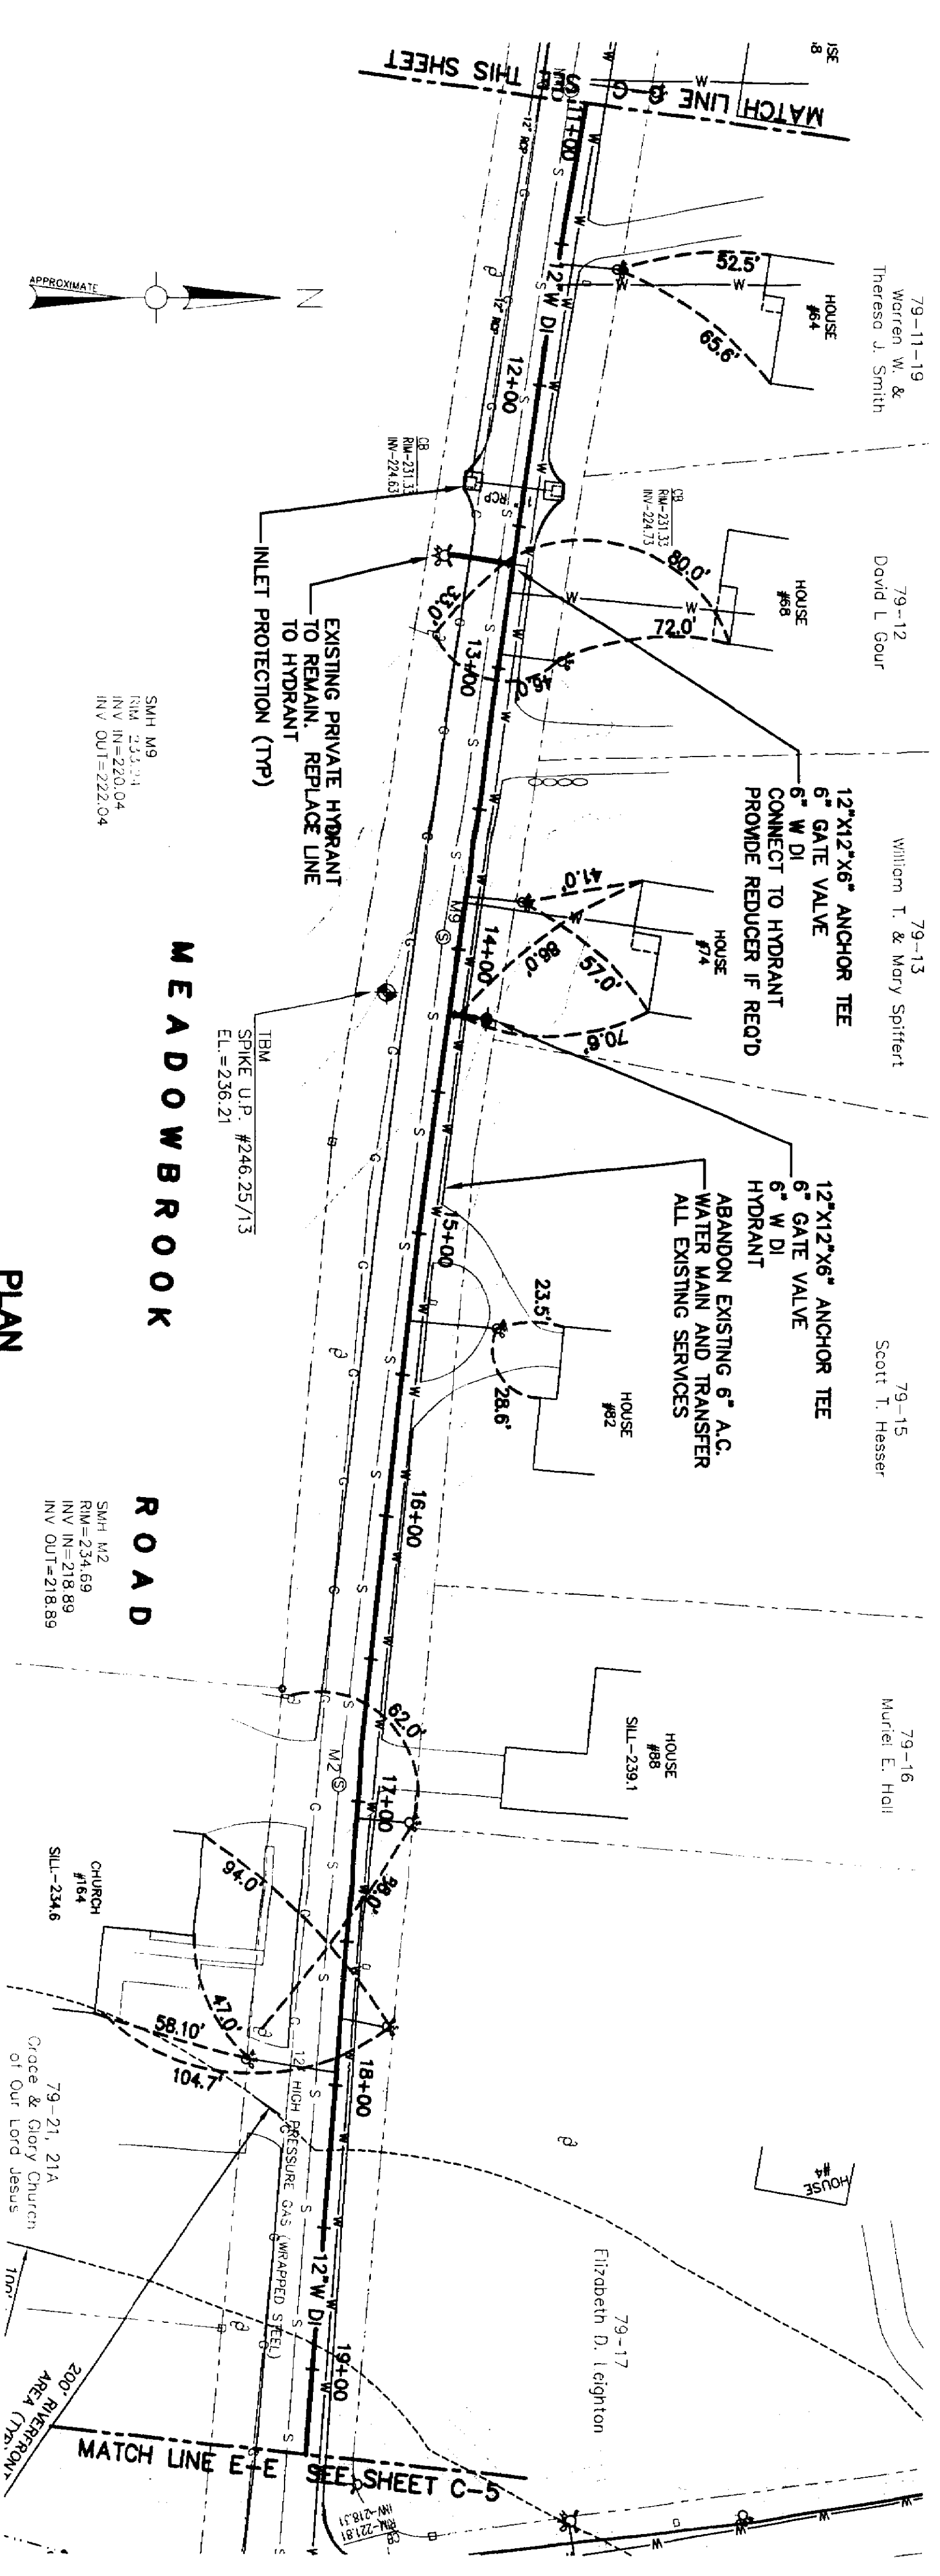


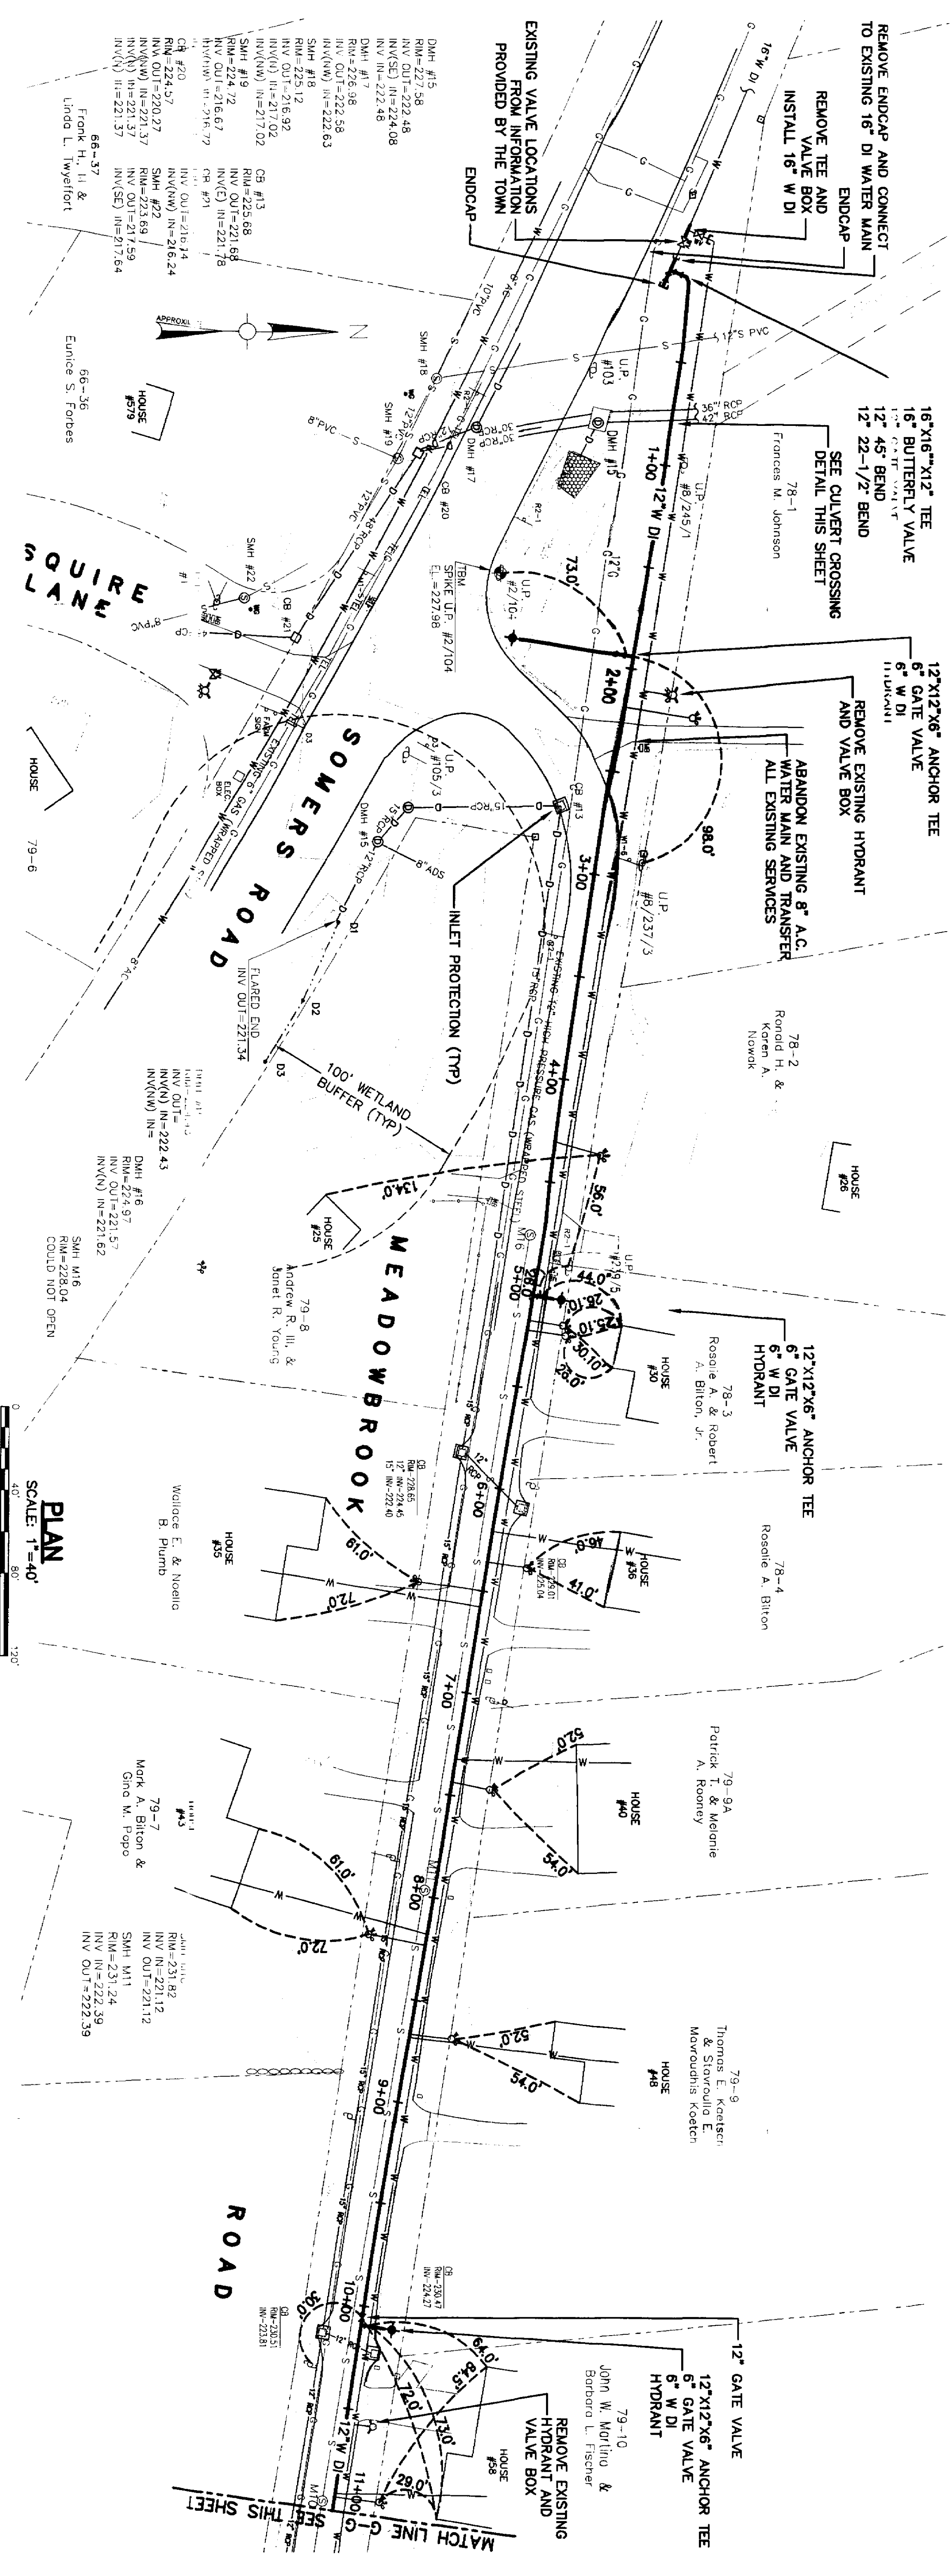

RECORD DRAWING

TOWN OF EAST LONGMEADOW BOARD OF PUBLIC WORKS WATER MAIN IMPROVEMENTS PROJECT MEADOWBROOK ROAD STA 0+00 TO STA 19+30										Weston & Sampson ENGINEERS, INC.	
FILE NO.	CADD NO.	SCALE:	CONTRACT:	JOB NO.	DR. BY	DSN. BY	CHK. BY	APP. BY	REGISTERED PROFESSIONAL ENGINEER		
141-15	RPARKER	1"=40'		202038	WGS	WGS	DRL	PJC	DATE		

1	2/04	WGS	DRL	RECORD DRAWING	
o.	Date	Dr. By	Ck. By	App. By	Description
		A	P	P	R O V E D