
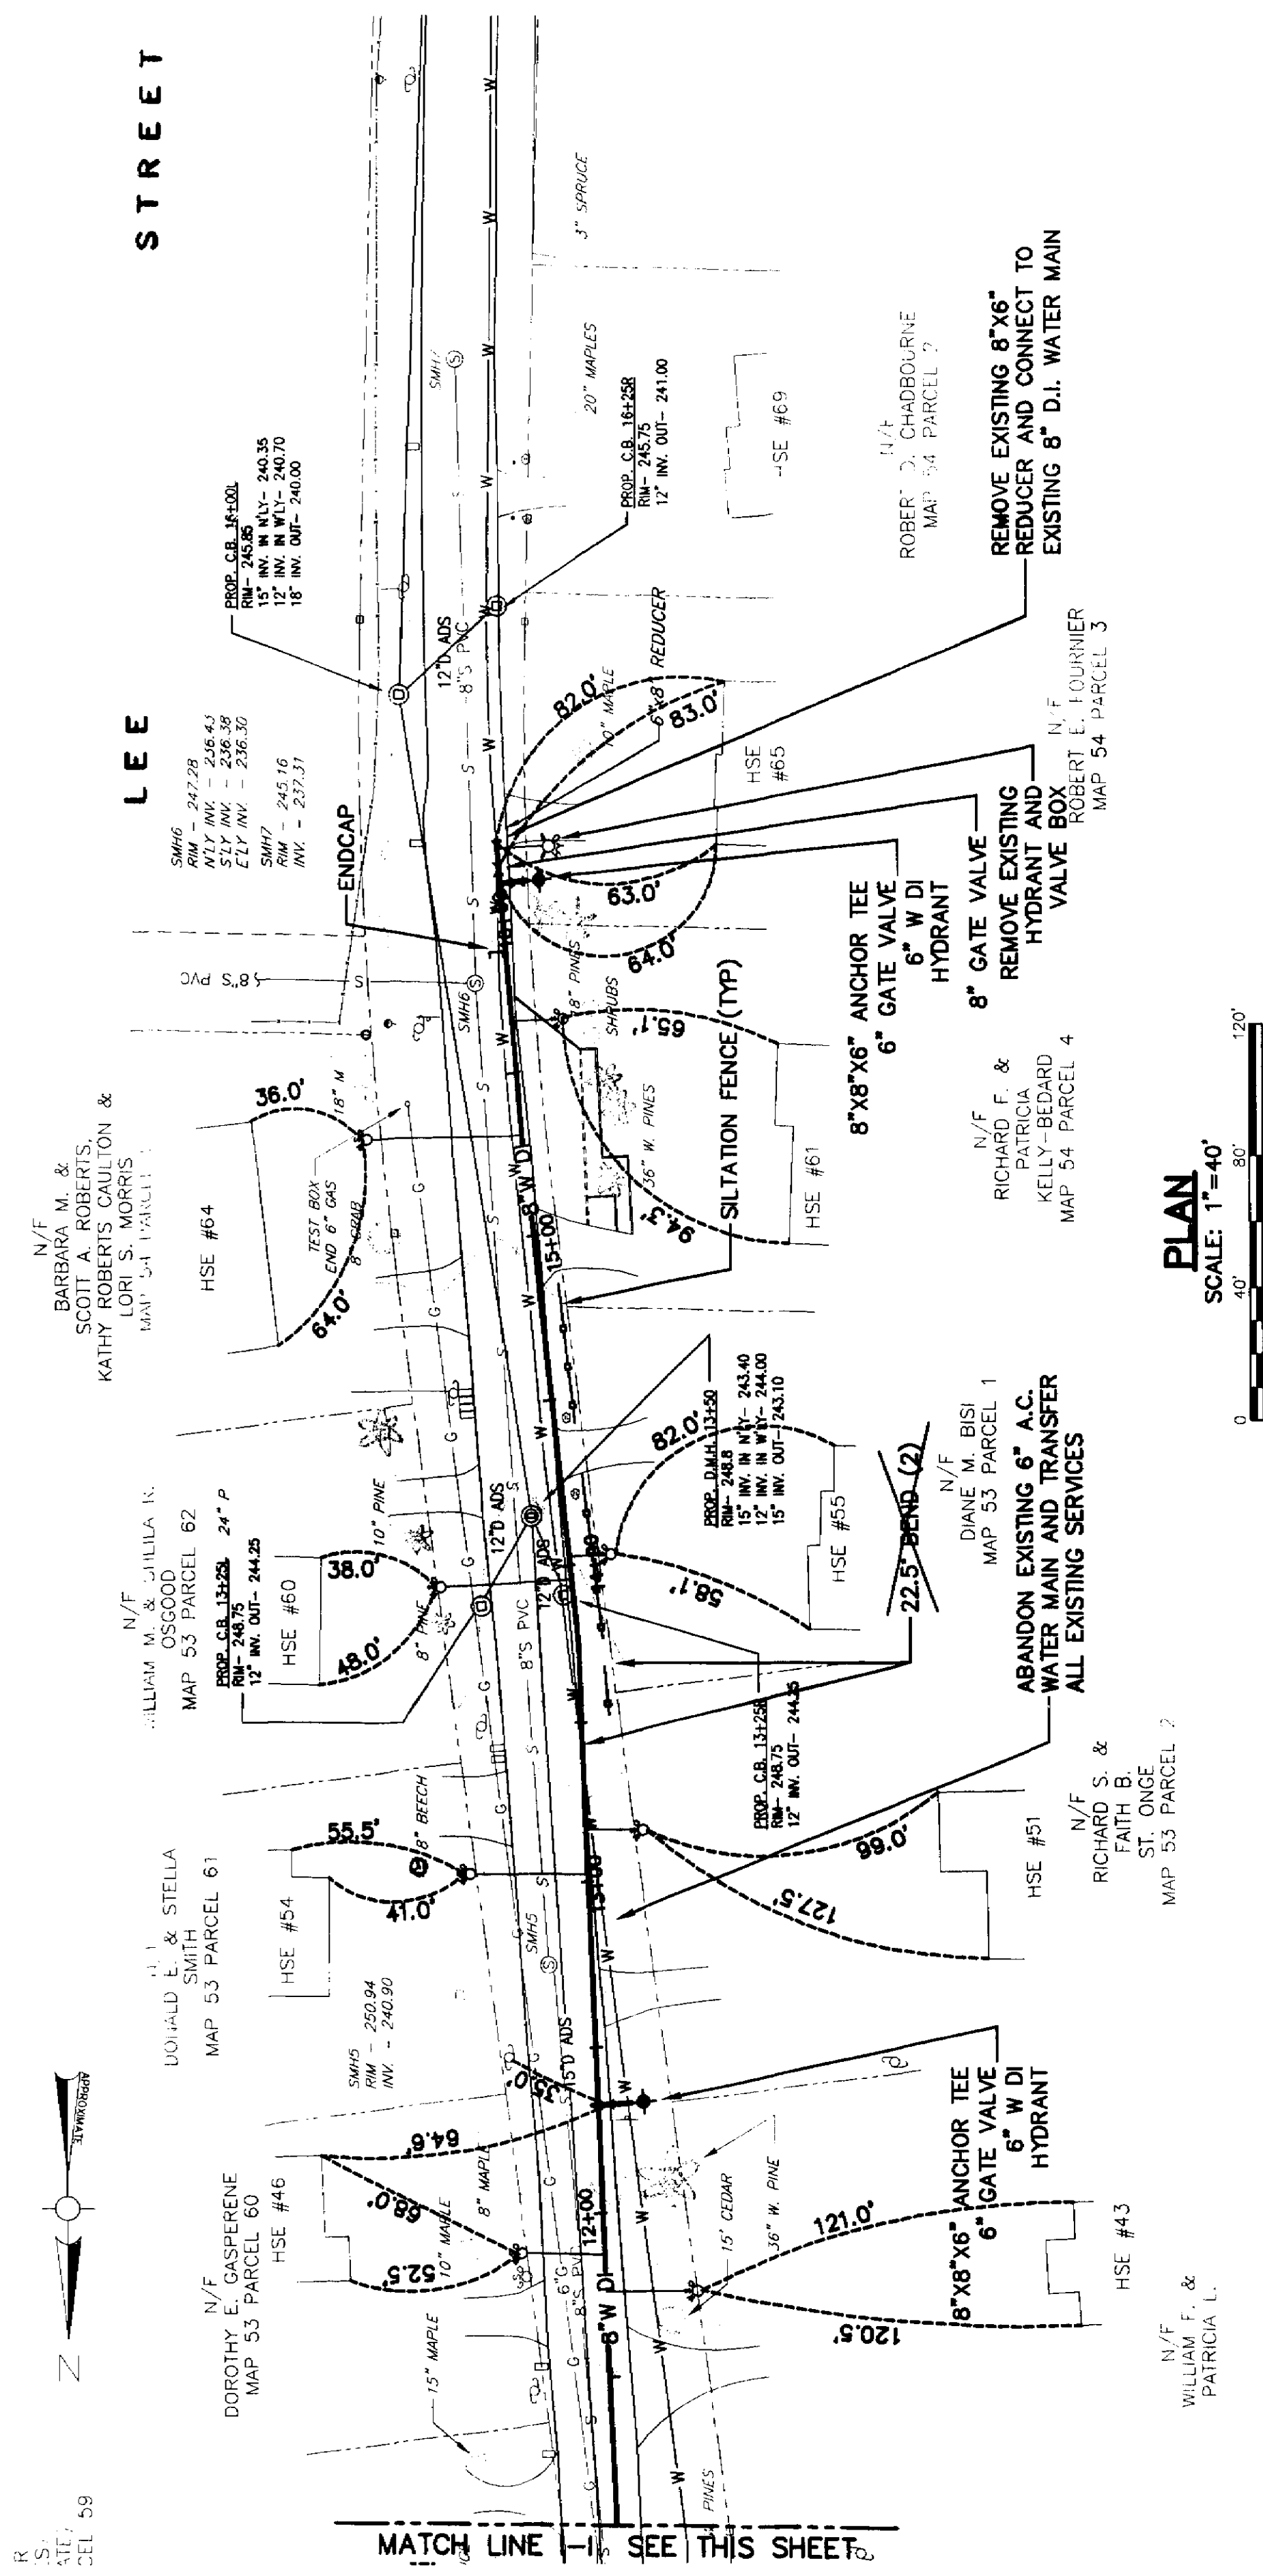


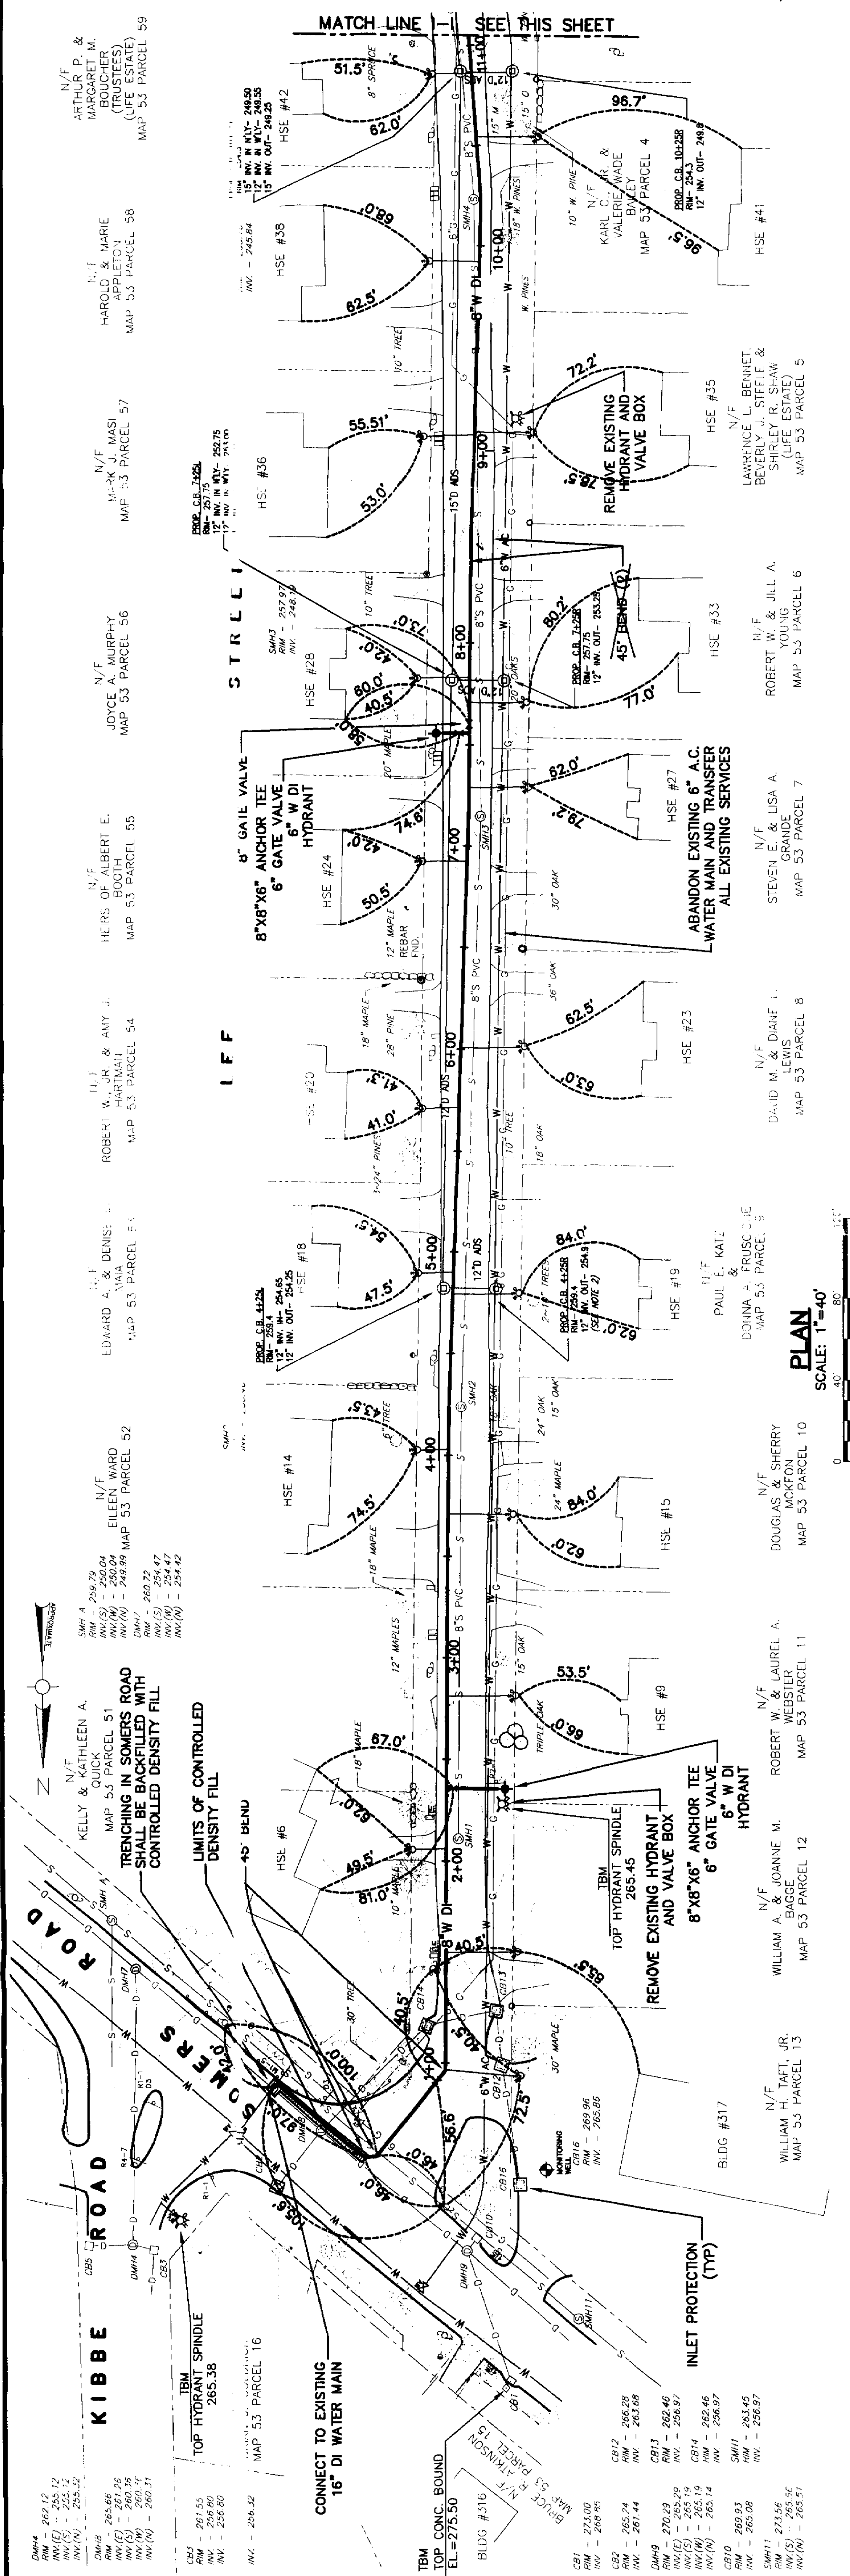

RECORD DRAWING

SHEET 10 OF 13