



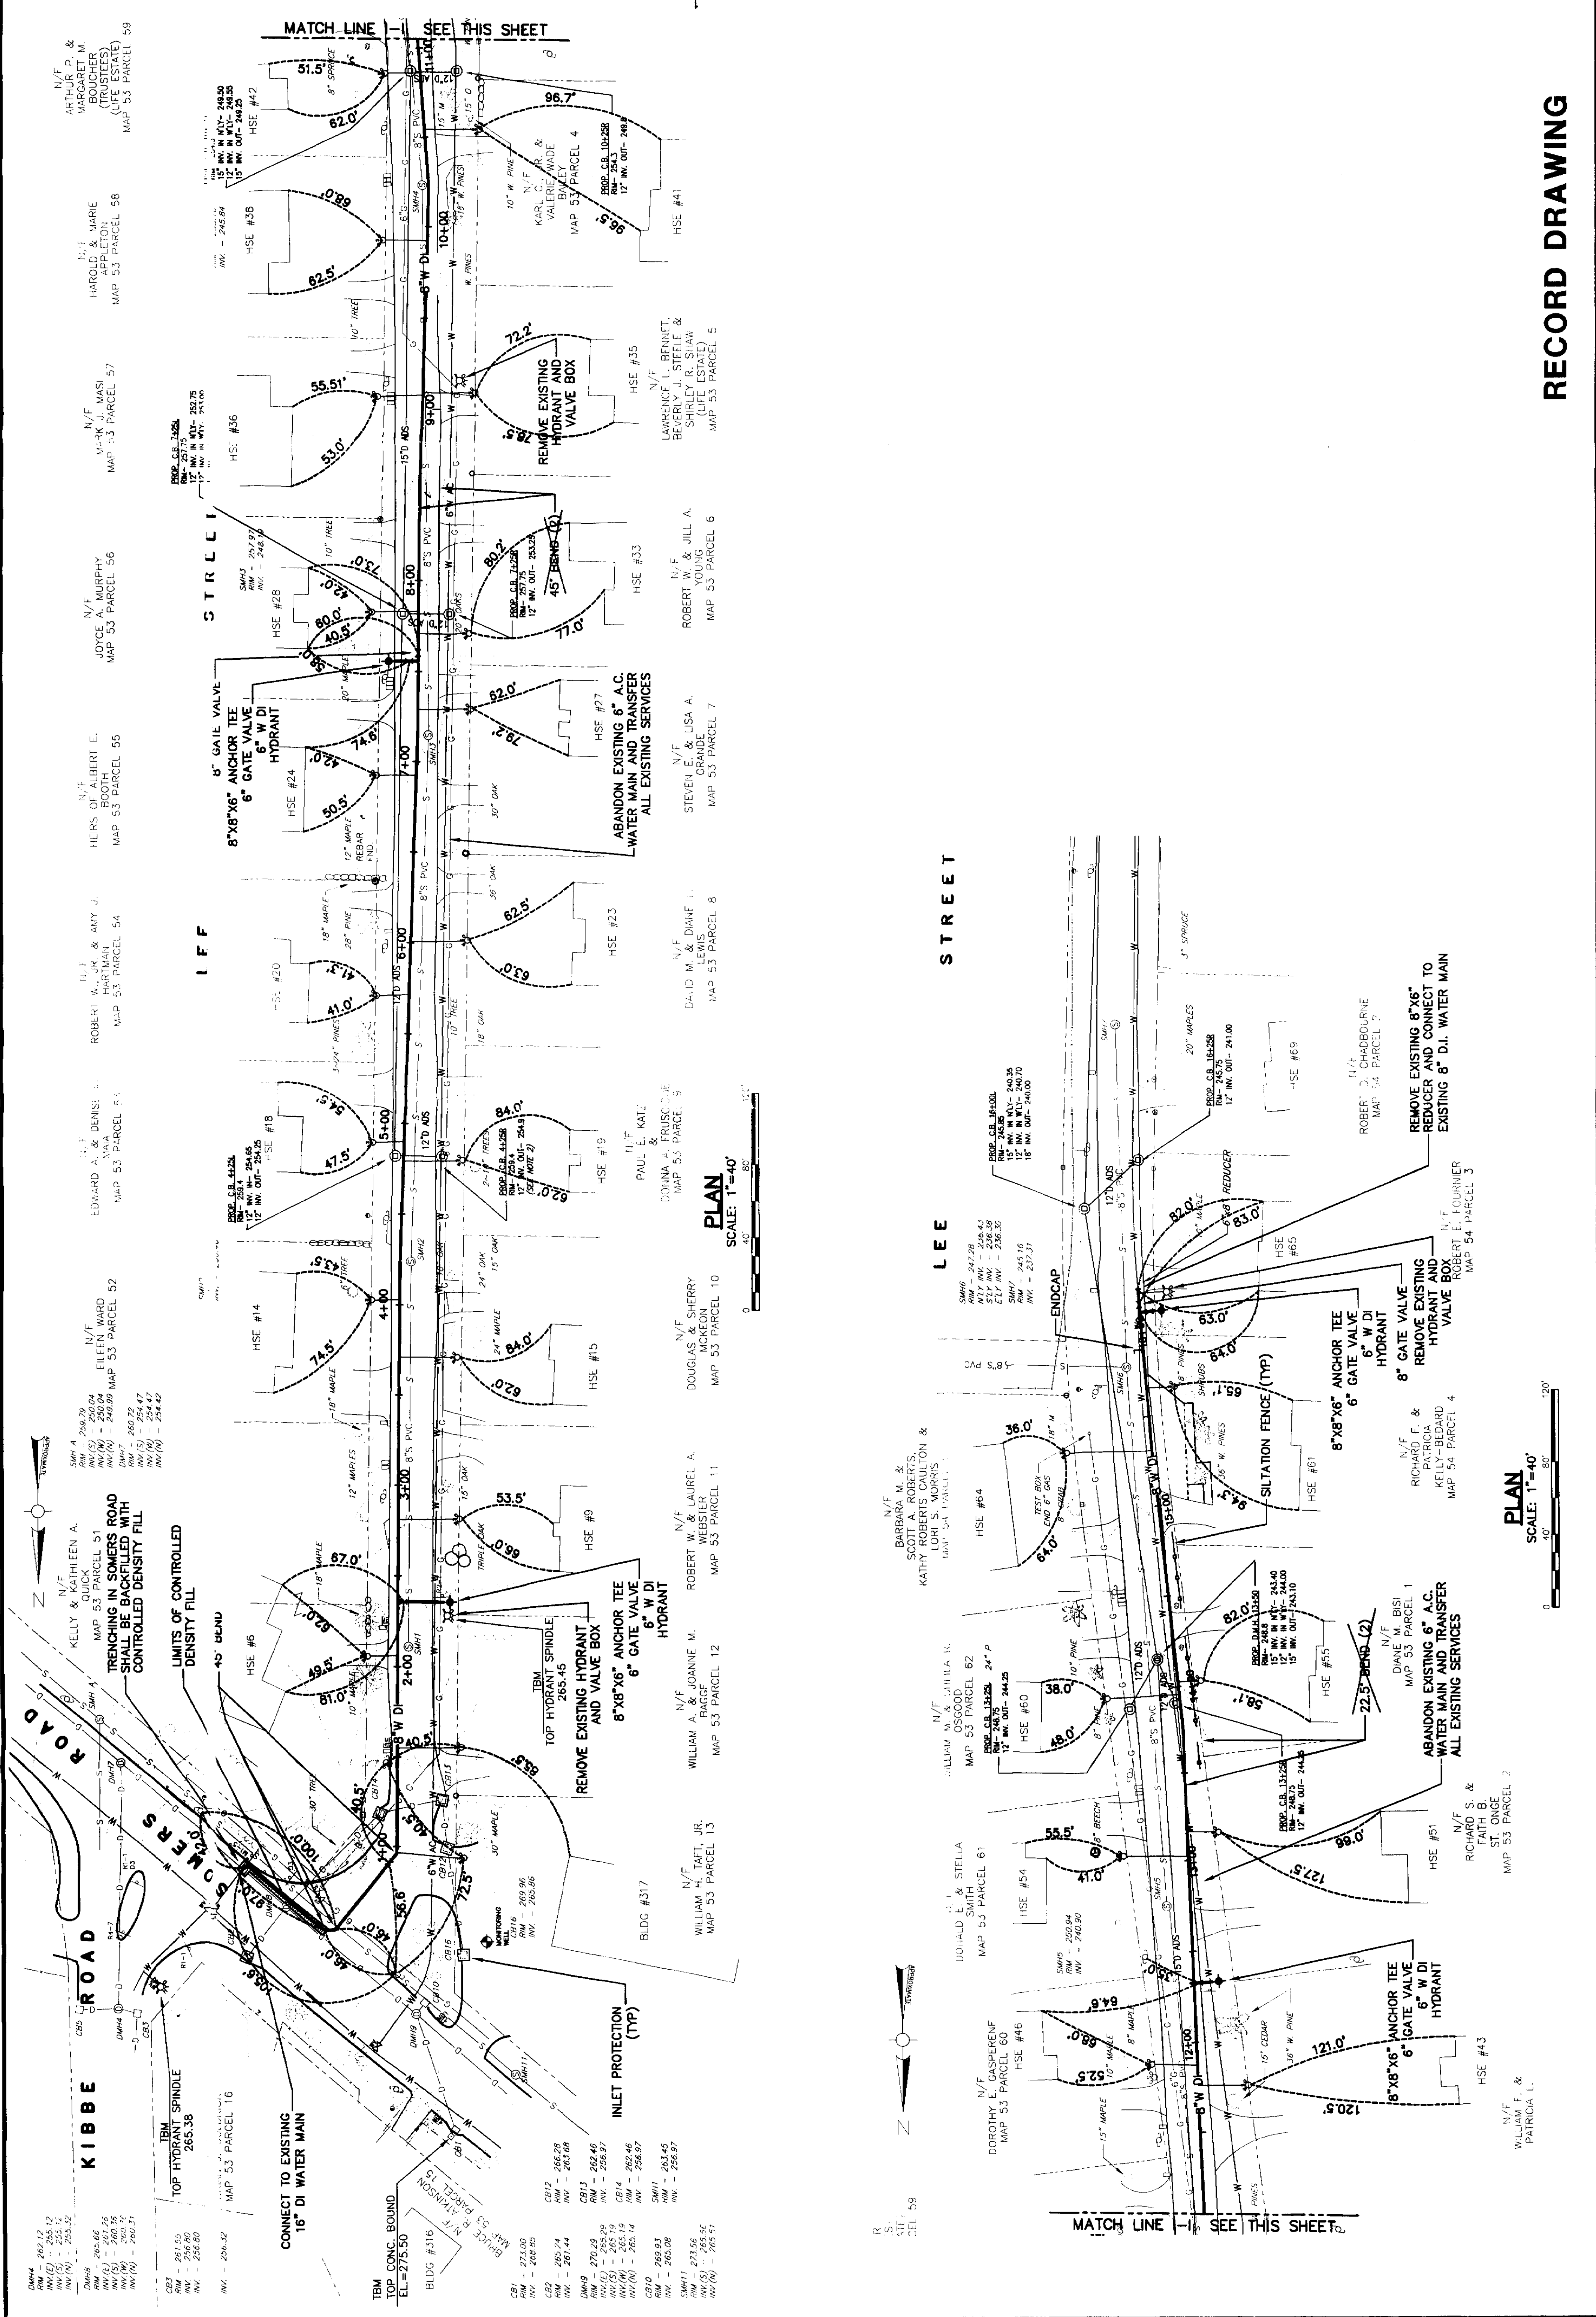

RECORD DRAWING

PLAN
SCALE: 1"=40'

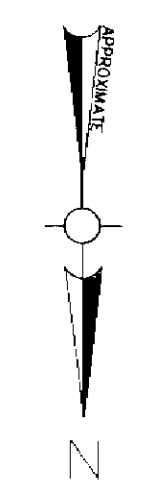

R. S. ATTEL
CEL 59