



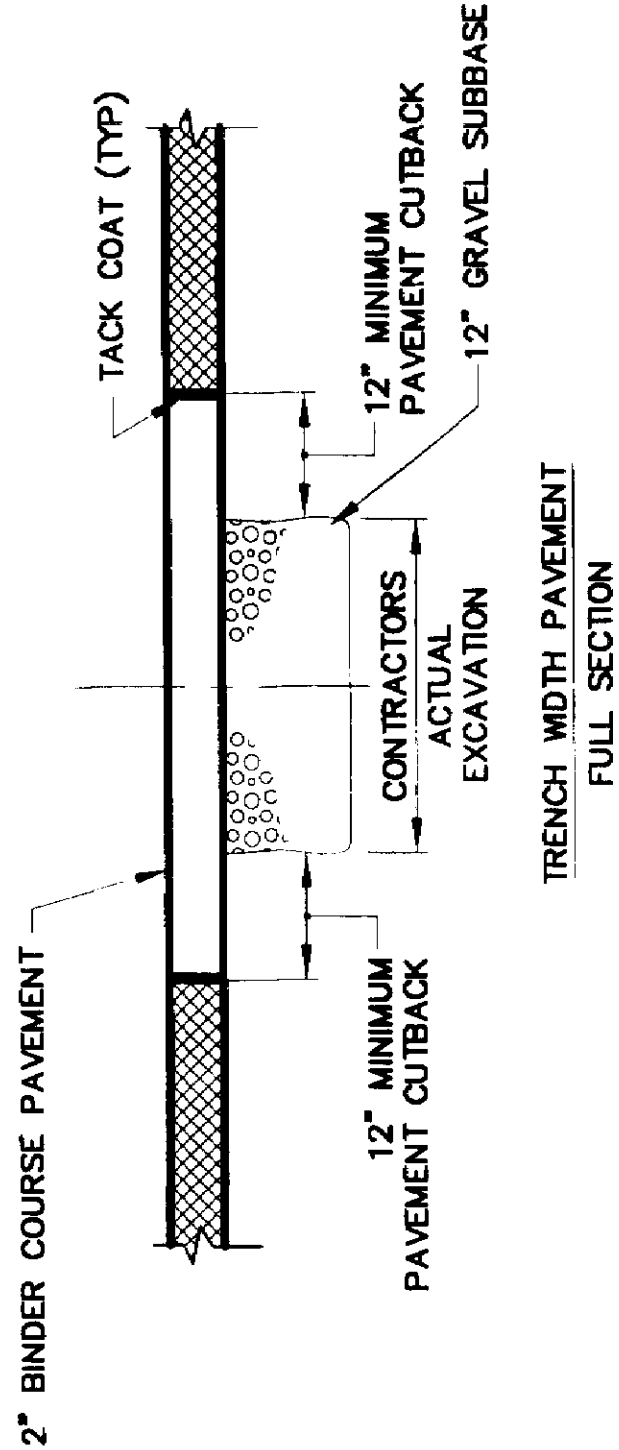

NOTES:
1. CONTRACTOR REQUIRED TO MAINTAIN TRENCH SURFACE THROUGHOUT THE PROJECT


TRENCH PAVEMENT REPLACEMENT DETAIL

N.T.S.

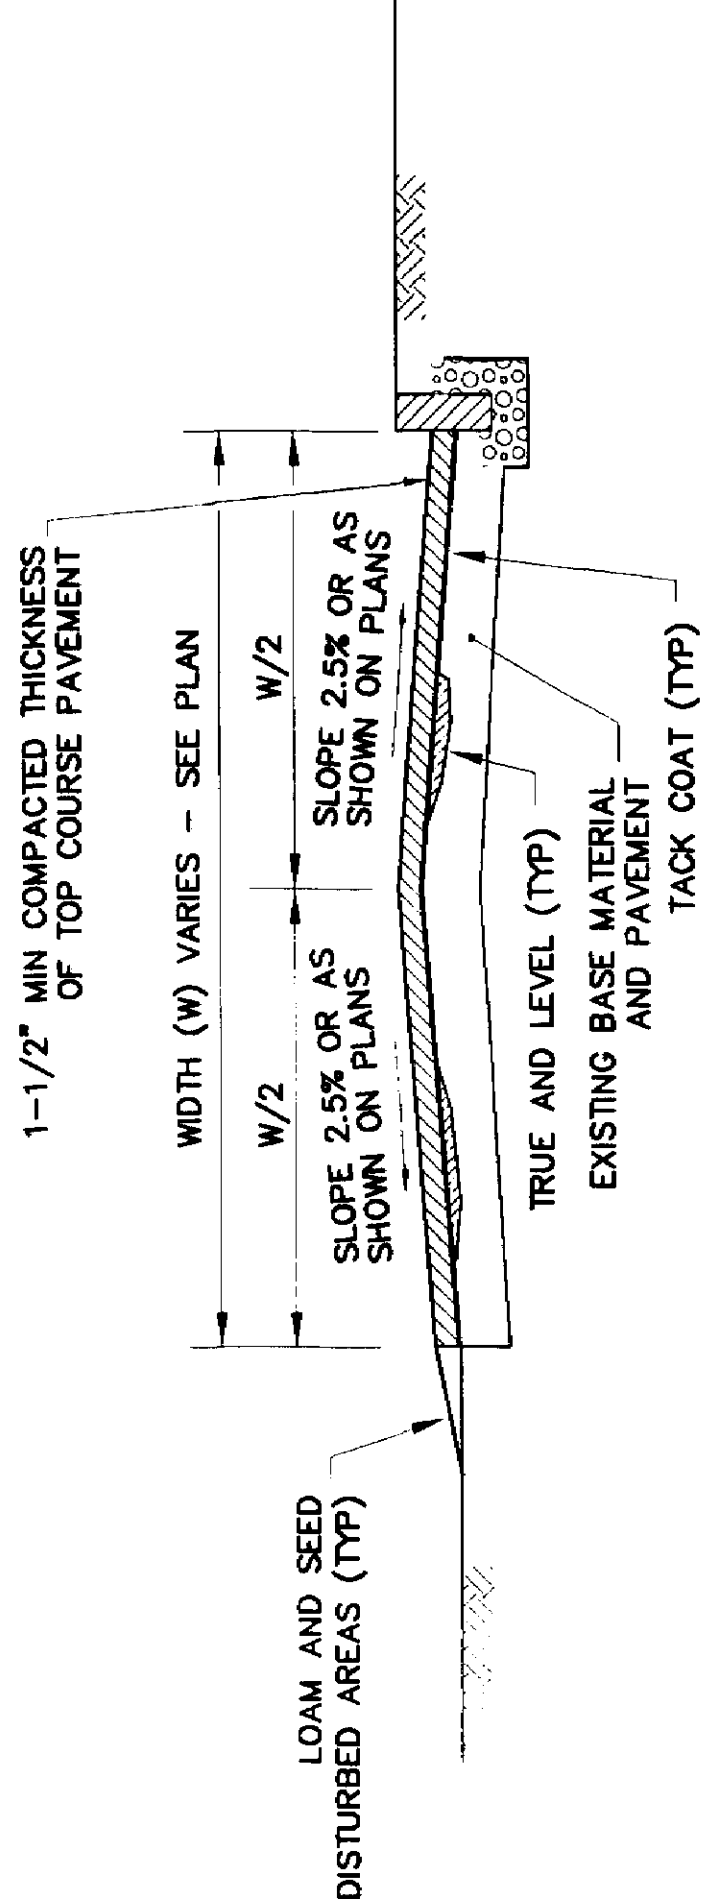


TYPICAL OVERLAY DETAIL

N.T.S.

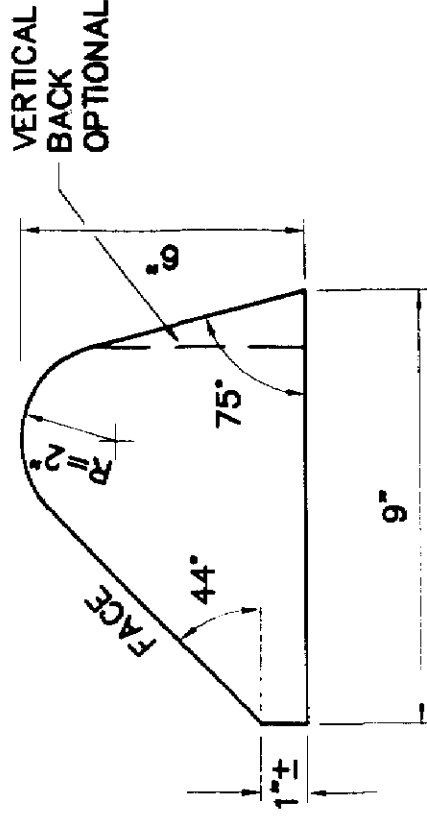


CURB DETAIL

CURB IS TYPE-2 PER MASS.
DPW CONSTRUCTION STANDARDS

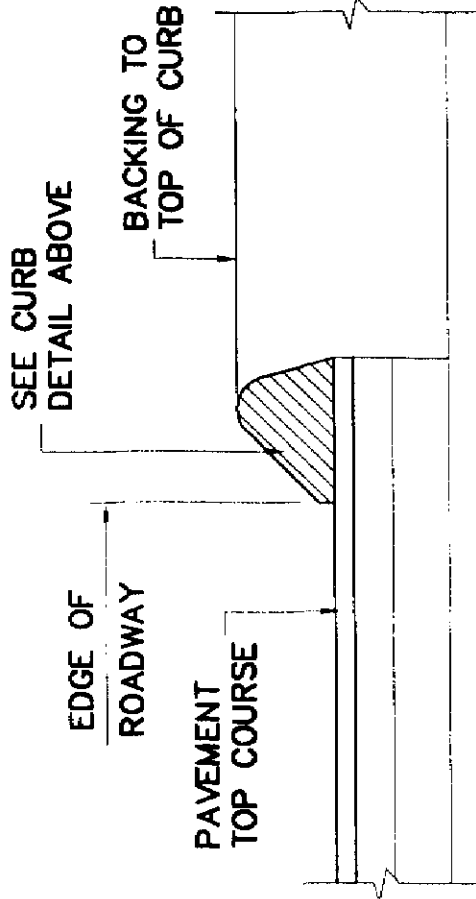


BITUMINOUS CONCRETE CURB

N.T.S.

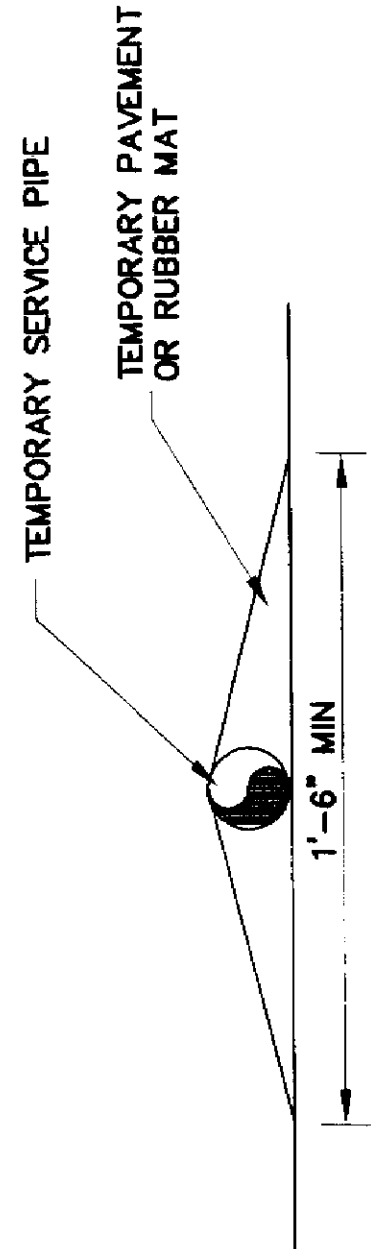


2\"/>

N.T.S.

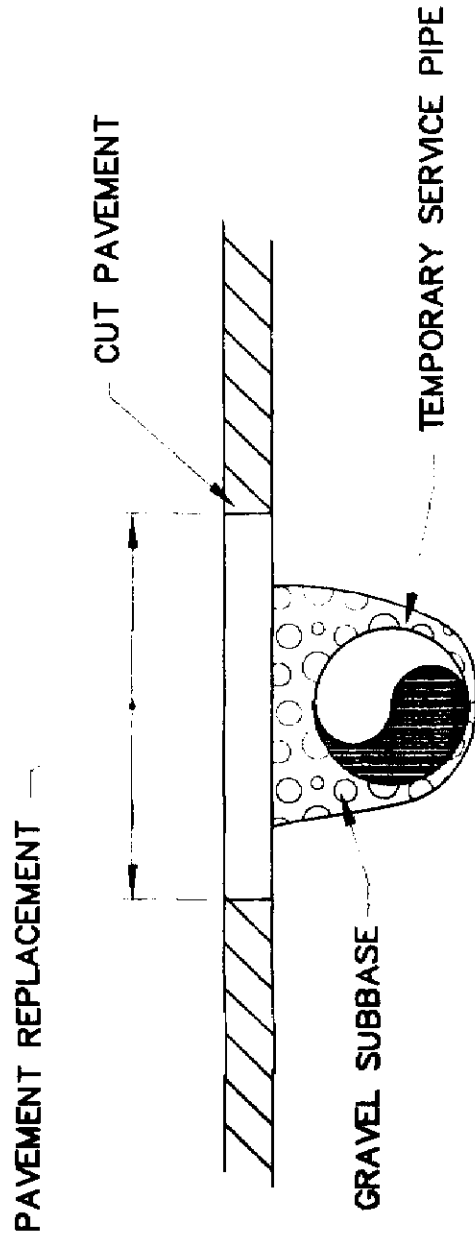

TEMPORARY SERVICE PIPE ROADWAY CROSSING DETAIL

N.T.S.

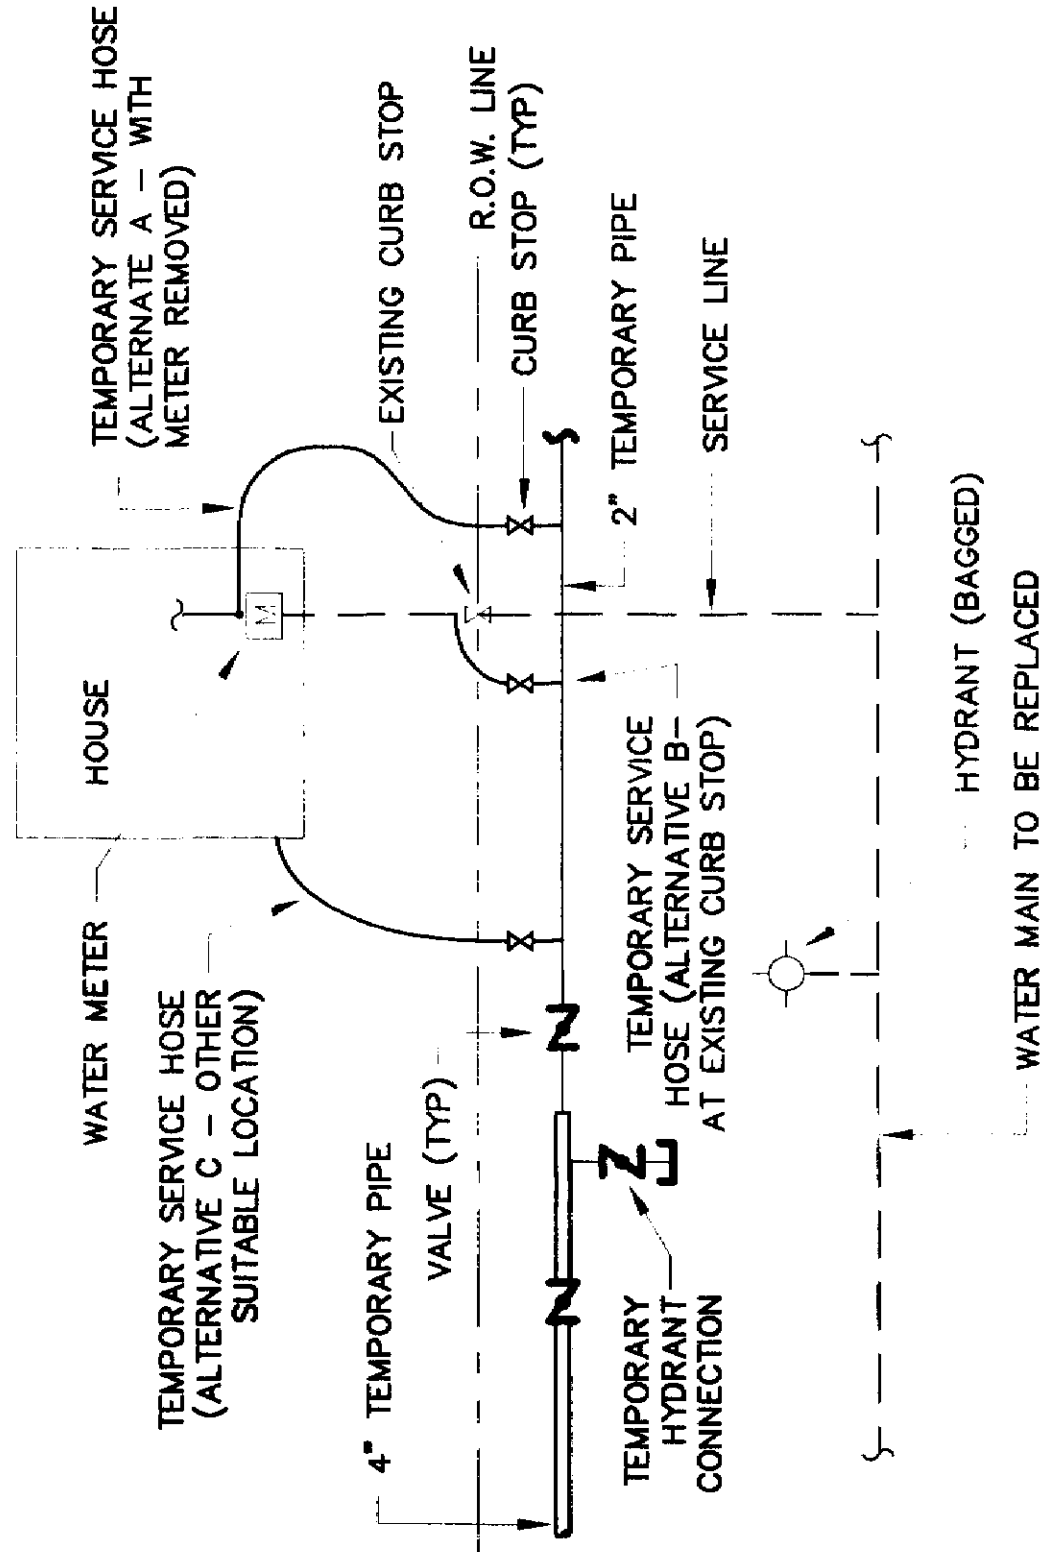

TEMPORARY SERVICE PIPE DETAIL

N.T.S.

RECORD DRAWING

WESTON & SAMPSON ENGINEERS, INC. 2028 MAIN STREET, GASTONBURY, CT 06033		REGISTERED PROFESSIONAL ENGINEER DATE _____	
1 02/04 WGS Date No.		1 02/04 WGS Date No.	
RECORD DRAWING		RECORD DRAWING	
Description		Description	
App. By		App. By	
P		P	
R		R	
O		O	
V		V	
E		E	
D		D	

TOWN OF EAST LONGMEADOW, MASSACHUSETTS WATER MAIN IMPROVEMENTS PROJECT		CAD NO. 141-10 FILE NO. 141-10	
SCALE: AS NOTED		RD ET-2	
CONTRACT:		JOB NO. 202038	
DR. BY WGS		DSN. BY WGS	
CHK. BY WGS		DRL	
APP. BY PJC		PJC	