


PARKER STREET WATER MAIN REPLACEMENT DEPARTMENT OF PUBLIC WORKS EAST LONGMEADOW, MASSACHUSETTS

MAY 2003

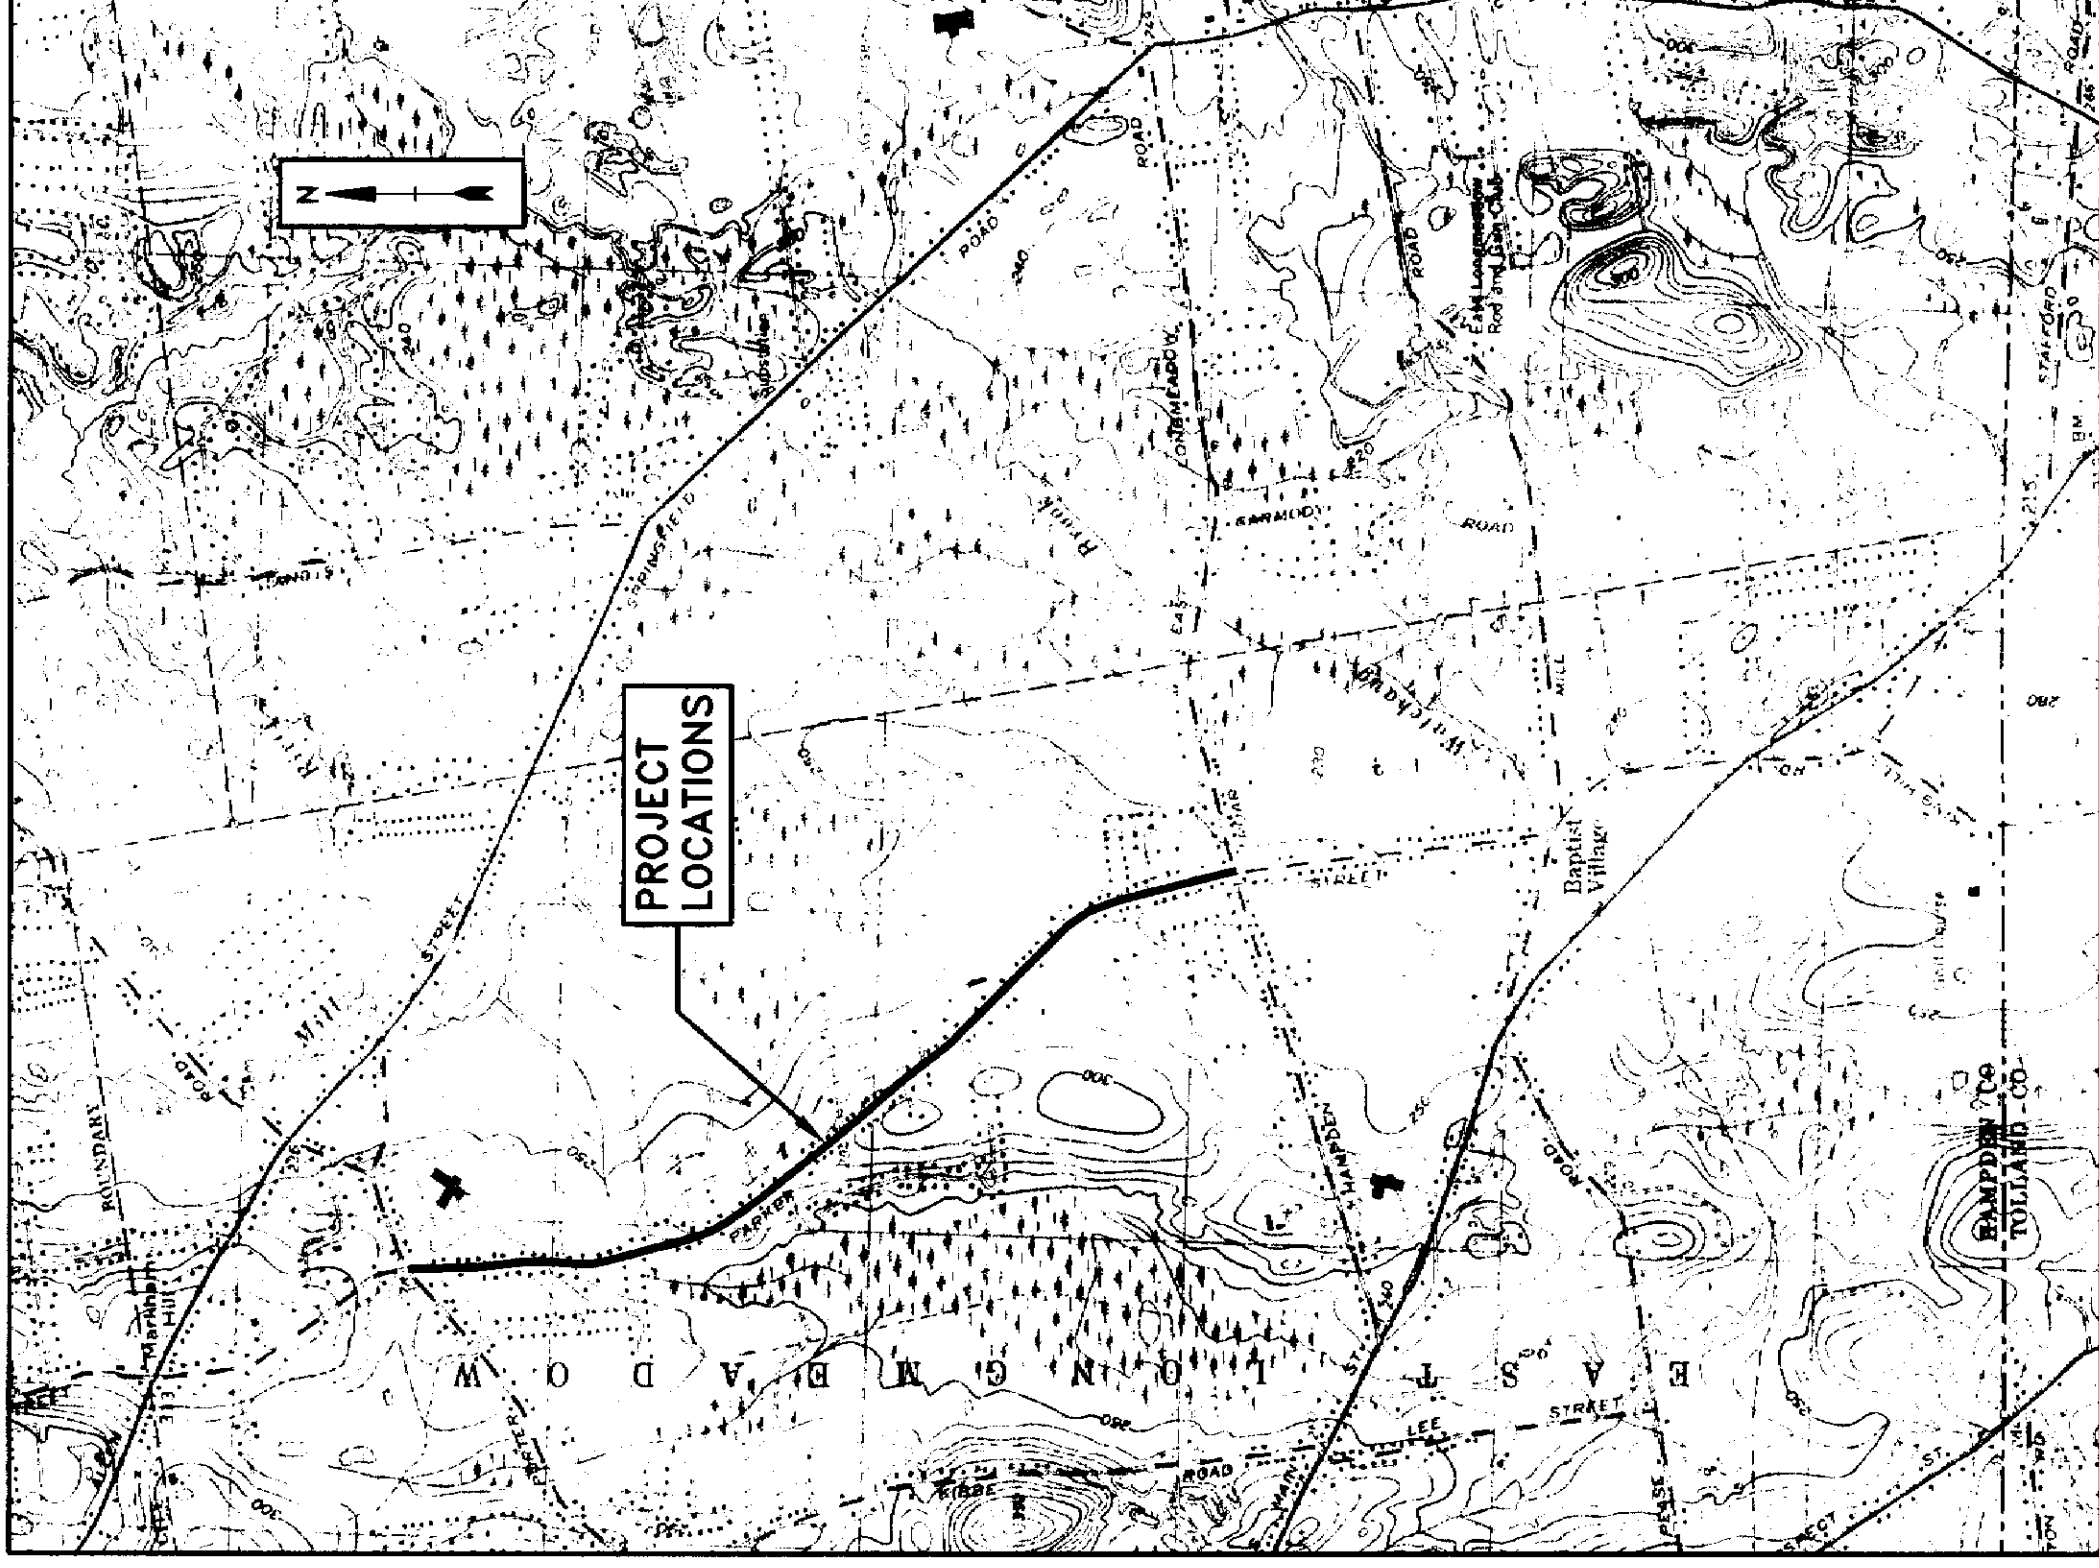

SCALE: 1:24000

BOARD OF PUBLIC WORKS

JOHN F. MAYBURY, CHAIRMAN
MICHAEL A. PERKINS
DANIEL S. BURACK

TOWN ENGINEER / DIRECTOR

DAVID J. GROMASKI, P.E.

RECORD PLAN
THIS RECORD PLAN WAS PREPARED BASED ON LIMITED INFORMATION
GATHERED DURING CONSTRUCTION OF THE PROJECT AND INDICATES ONLY
SIGNIFICANT CHANGES MADE FROM THE DESIGN PLANS DURING CONSTRUCTION.

Tighe&Bond
Consulting Engineers

COMPLETE SET 10 SHEETS