



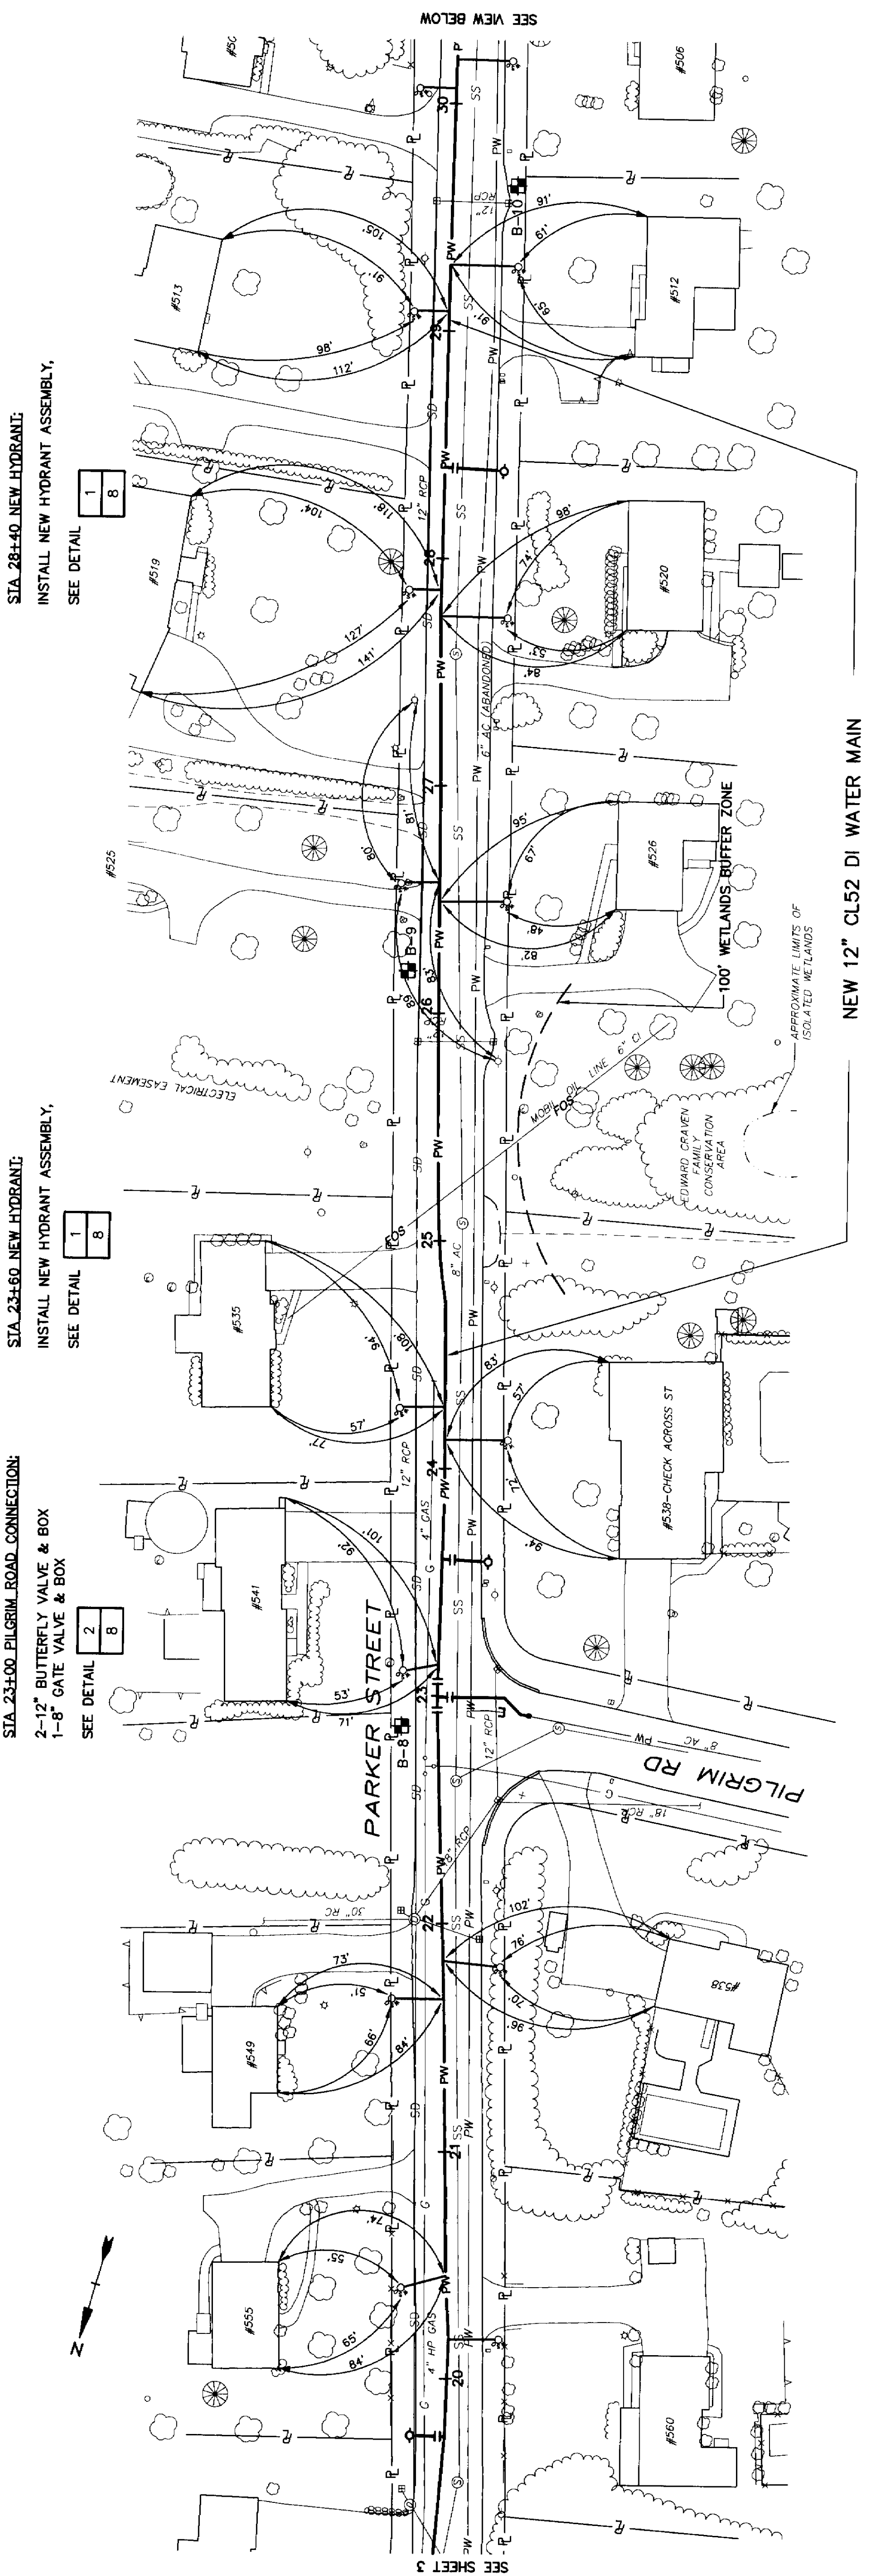

STA 231+00. PILGRIM ROAD CONNECTION:
2-12" BUTTERFLY VALVE & BOX
1-8" GATE VALVE & BOX
SEE DETAIL 2 8

STA 28+40 NEW HYDRANT:
INSTALL NEW HYDRANT ASSEMBLY,
SEE DETAIL 1 8

NEW 12" CL52 DI WATER MAIN

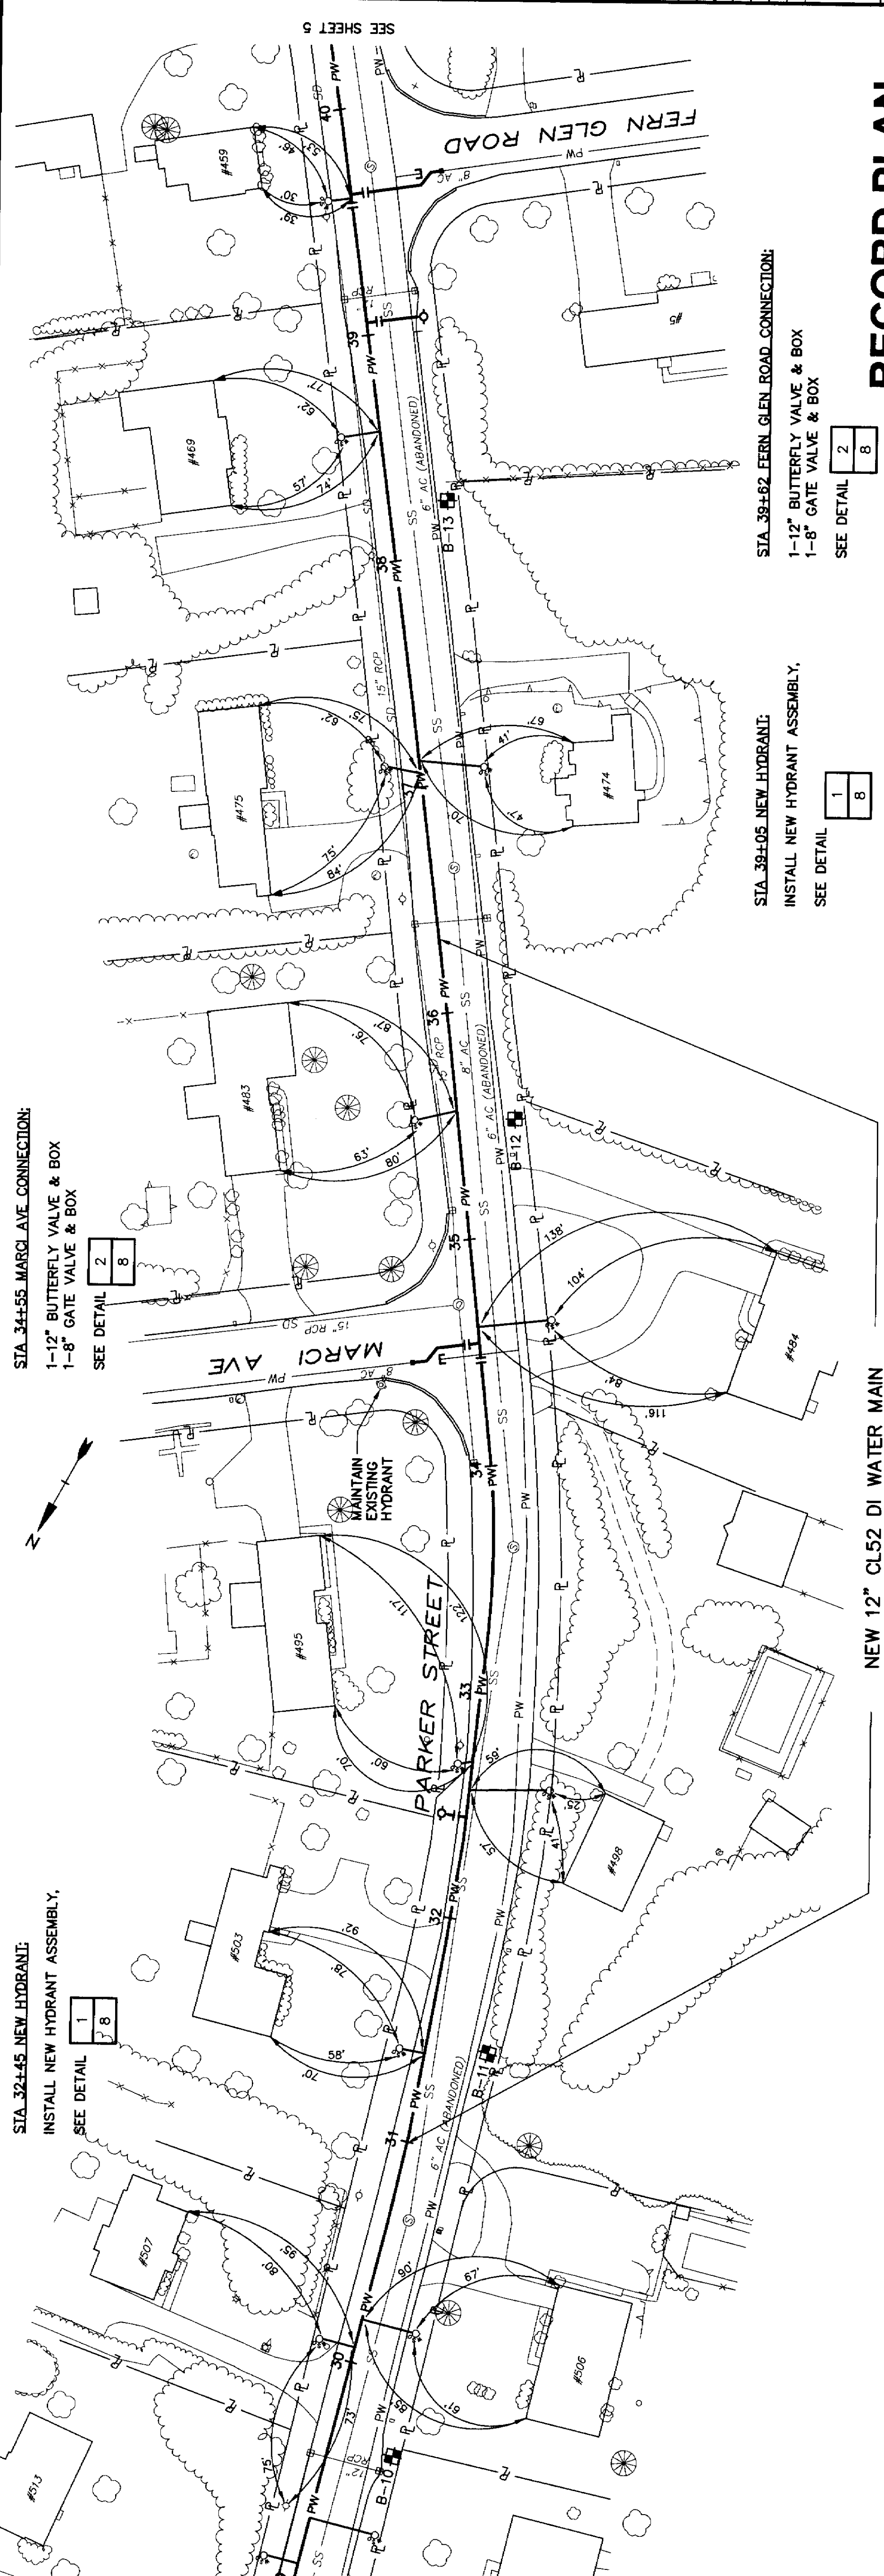

STA 32+45 NEW HYDRANT:
INSTALL NEW HYDRANT ASSEMBLY,
SEE DETAIL 1 8

STA 34+55 MARCI AVE CONNECTION:
1-12" BUTTERFLY VALVE & BOX
1-8" GATE VALVE & BOX
SEE DETAIL 2 8

NEW 12" CL52 DI WATER MAIN

STA 38+05 NEW HYDRANT:
INSTALL NEW HYDRANT ASSEMBLY,
SEE DETAIL 1 8

STA 38+82 FERN GLEN ROAD CONNECTION:
1-12" BUTTERFLY VALVE & BOX
1-8" GATE VALVE & BOX
SEE DETAIL 2 8

RECORD PLAN

THIS RECORD PLAN WAS PREPARED BASED ON THE INFORMATION GATHERED DURING CONSTRUCTION OF THE PROJECT AND INDICATES ONLY SIGNIFICANT CHANGES MADE FROM THE DESIGN PLANS DURING CONSTRUCTION.

SCALE: 1" = 40'

SHEET 4 OF 10

**Parker Street
Water Main
Replacement**

**Department of
Public Works**

**East Longmeadow,
Massachusetts**

PROJECT NO.	EA481-2-02
FILE:	EA481-PARKERWASH14
DRAWN BY:	CFY
CHECKED:	JT
APPROVED BY:	RP
PARKER STREET	
STA 20+00 TO STA 40+00	