



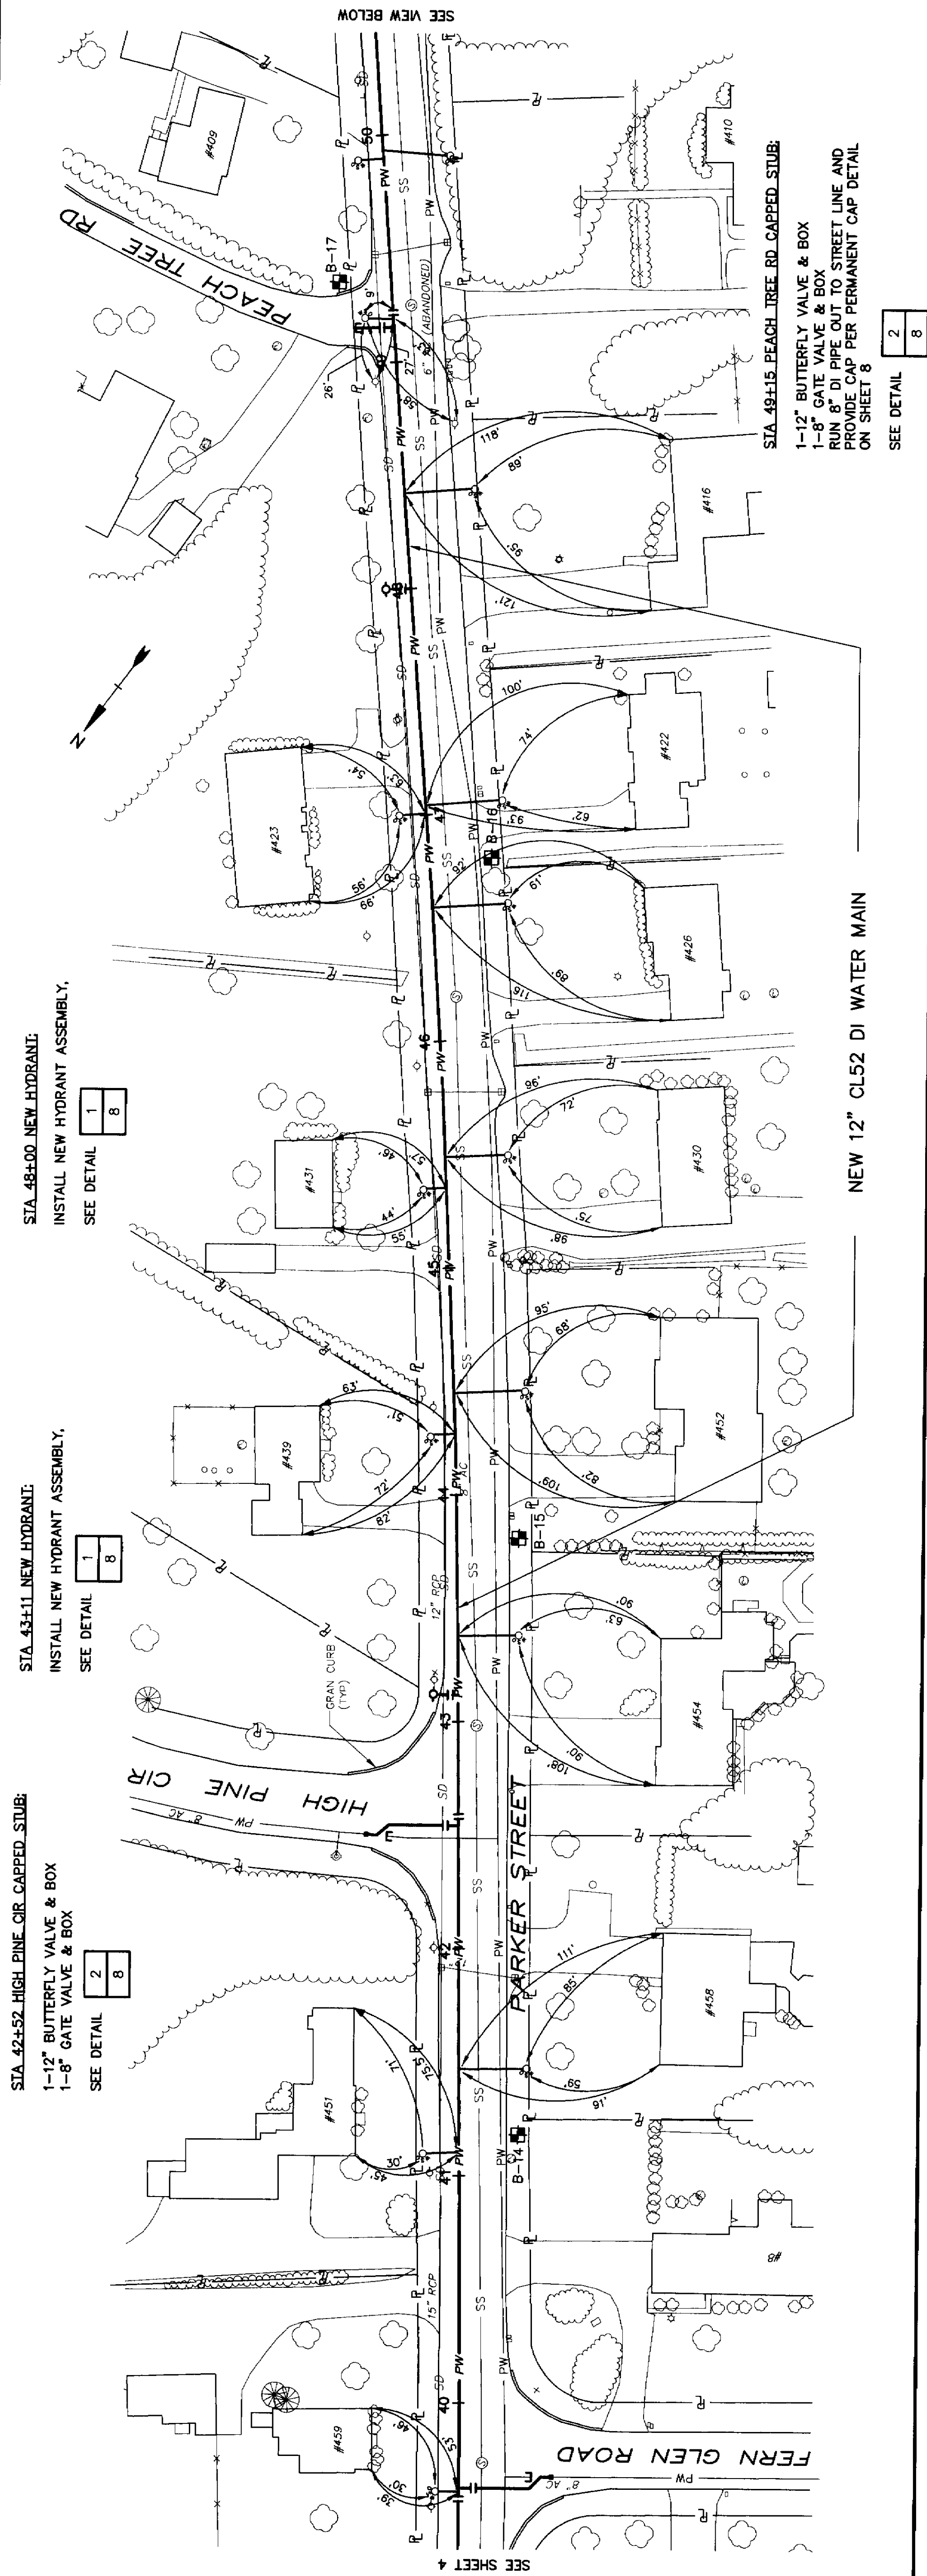

STA 52+60 NEW HYDRANT;
INSTALL NEW HYDRANT ASSEMBLY,
SEE DETAIL []

STA 55+00 NEW VALVE:
1-12" BUTTERFLY VALVE & BOX

STA 57+50 NEW HYDRANT:
INSTALL NEW HYDRANT ASSEMBLY,

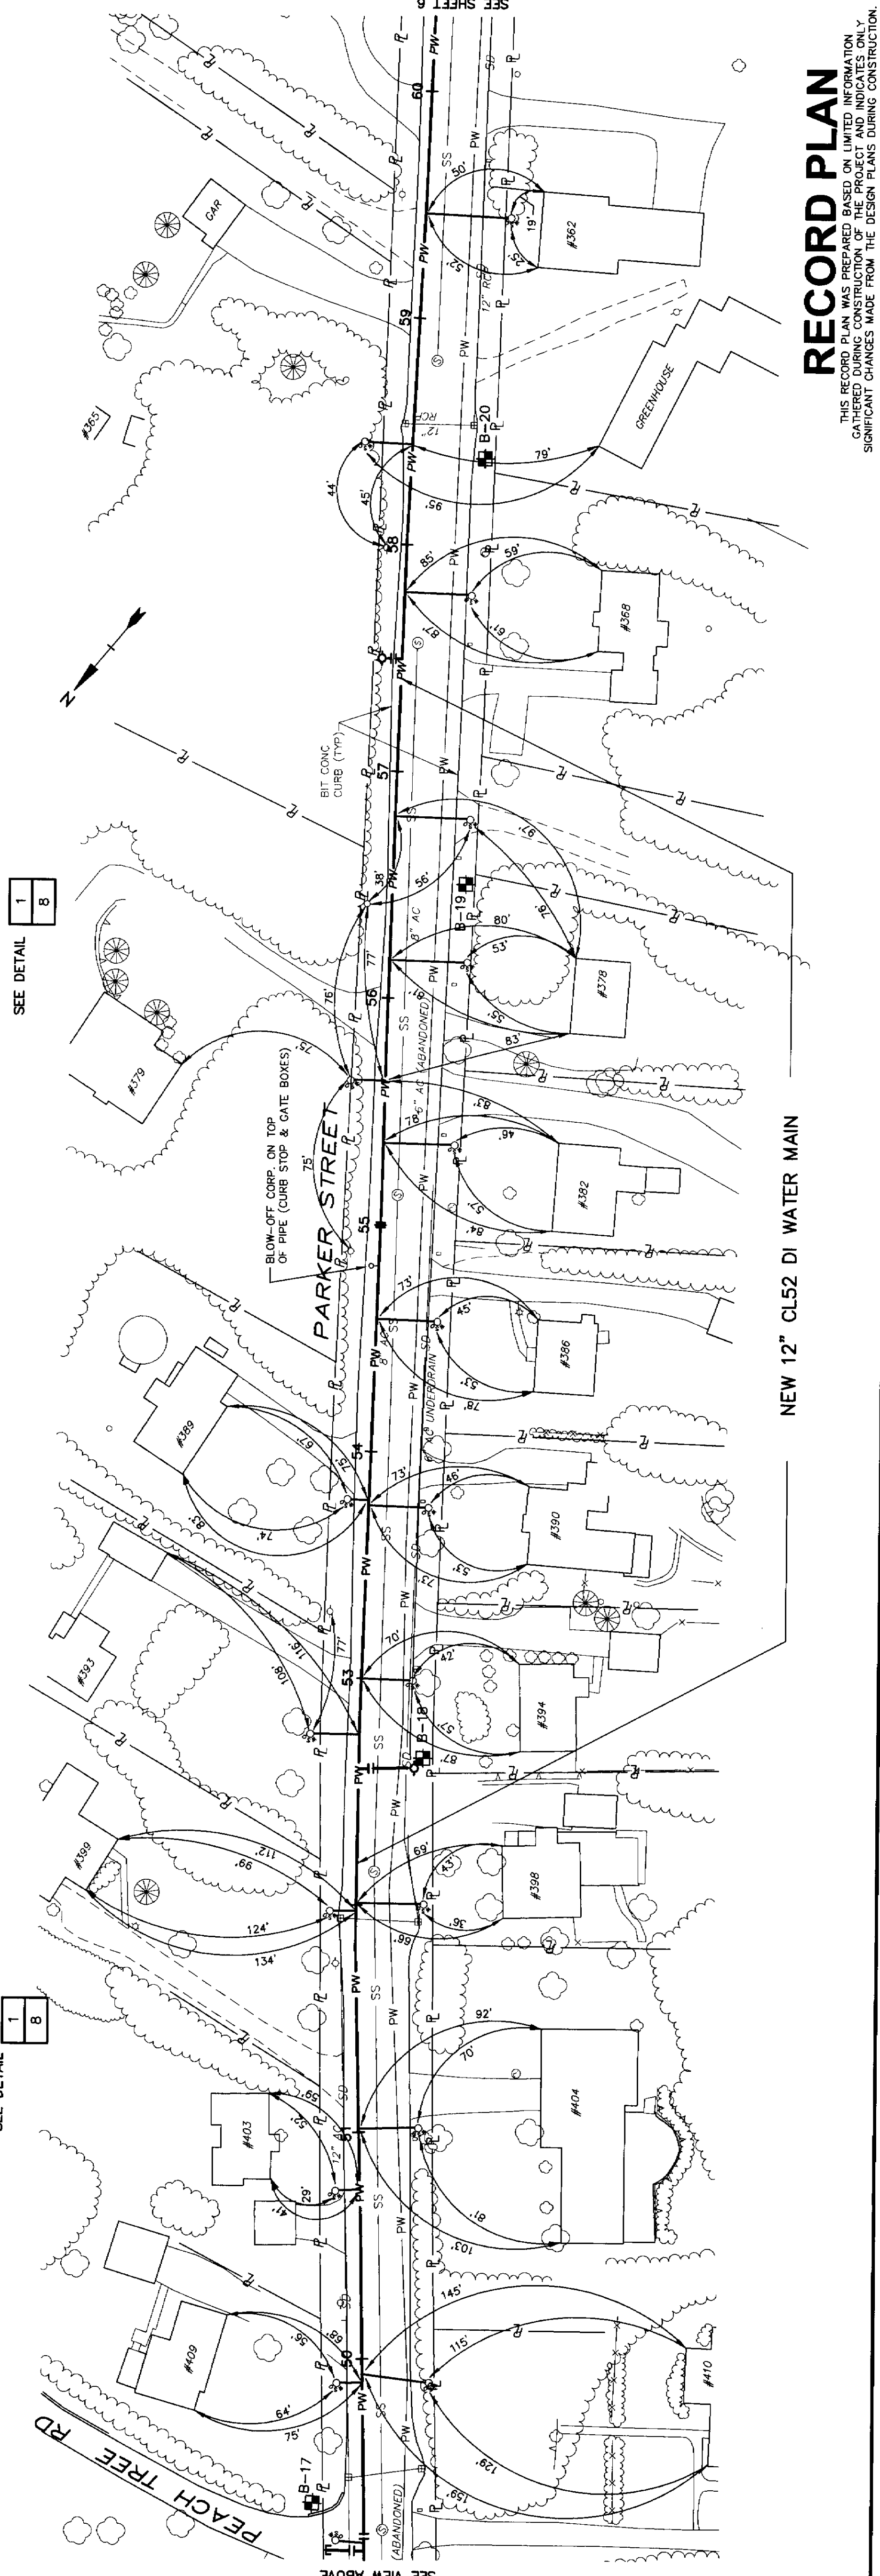

RECORD PLAN

THIS RECORD PLAN WAS PREPARED BASED ON LIMITED INFORMATION GATHERED DURING CONSTRUCTION OF THE PROJECT AND INDICATES ONLY SIGNIFICANT CHANGES MADE FROM THE DESIGN PLANS DURING CONSTRUCTION.

12/15/03

Parker Street Water Main Replacement

Department of
Public Works

**East Longmeadow,
Massachusetts**

[illegible]

NEW 12" CL52 DI WATER MAIN