


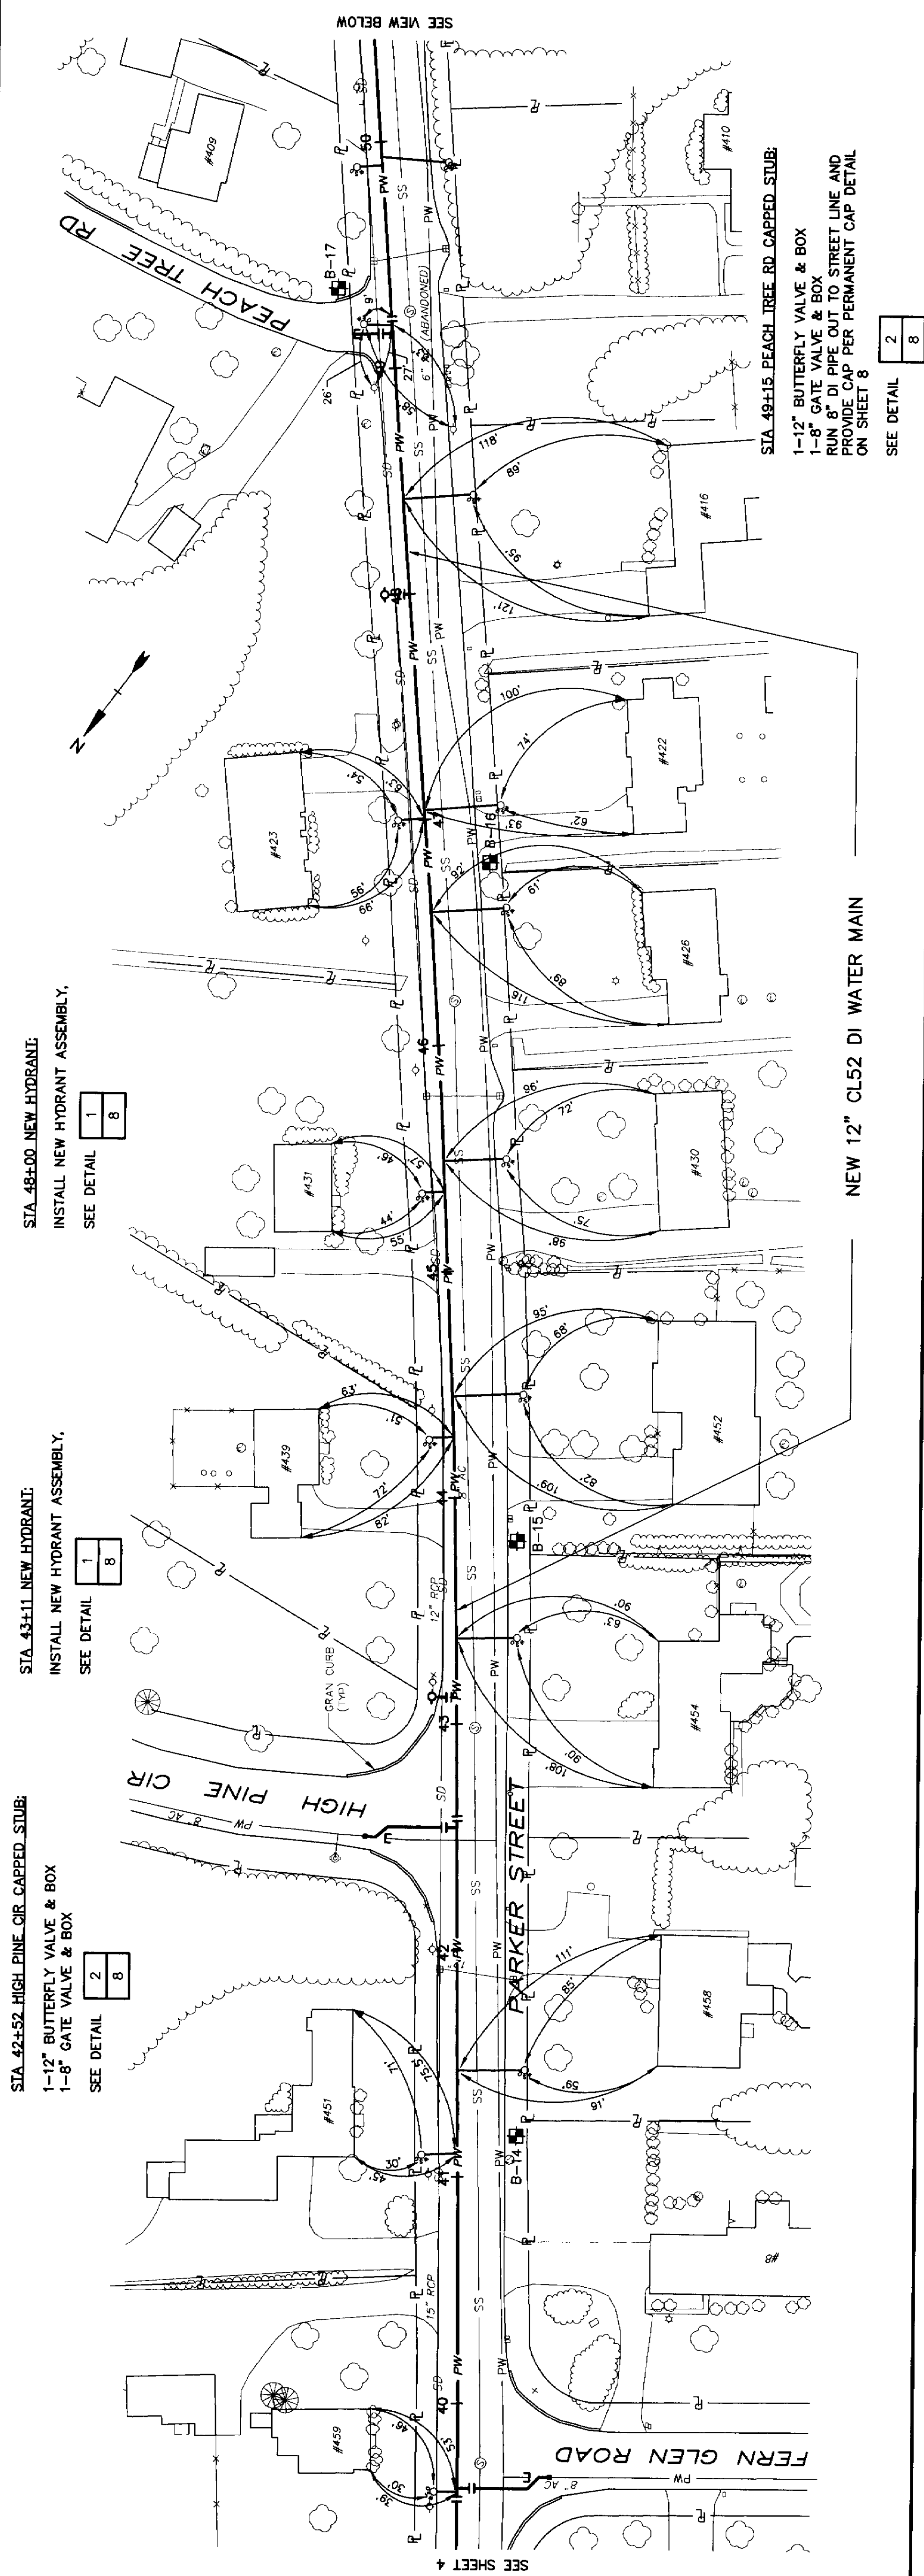

Parker Street Water Main Replacement

Department of
Public Works

**East Longmeadow,
Massachusetts**


B	12/03	RECORD PLAN
A	05/03	FINAL ISSUE
Mark	Date	Description
PROJECT NO:		E0451-2-02
TITLE:		E0451PARKERWMSHT5
DRAWN BY:	CFY	
CHECKED:	JT	
APPROVED BY:	RP	

PARKER STREET
STA 40+00 TO STA 60+00

SCALE: 1" = 40'

SHEET 5 OF 10

12/15/03

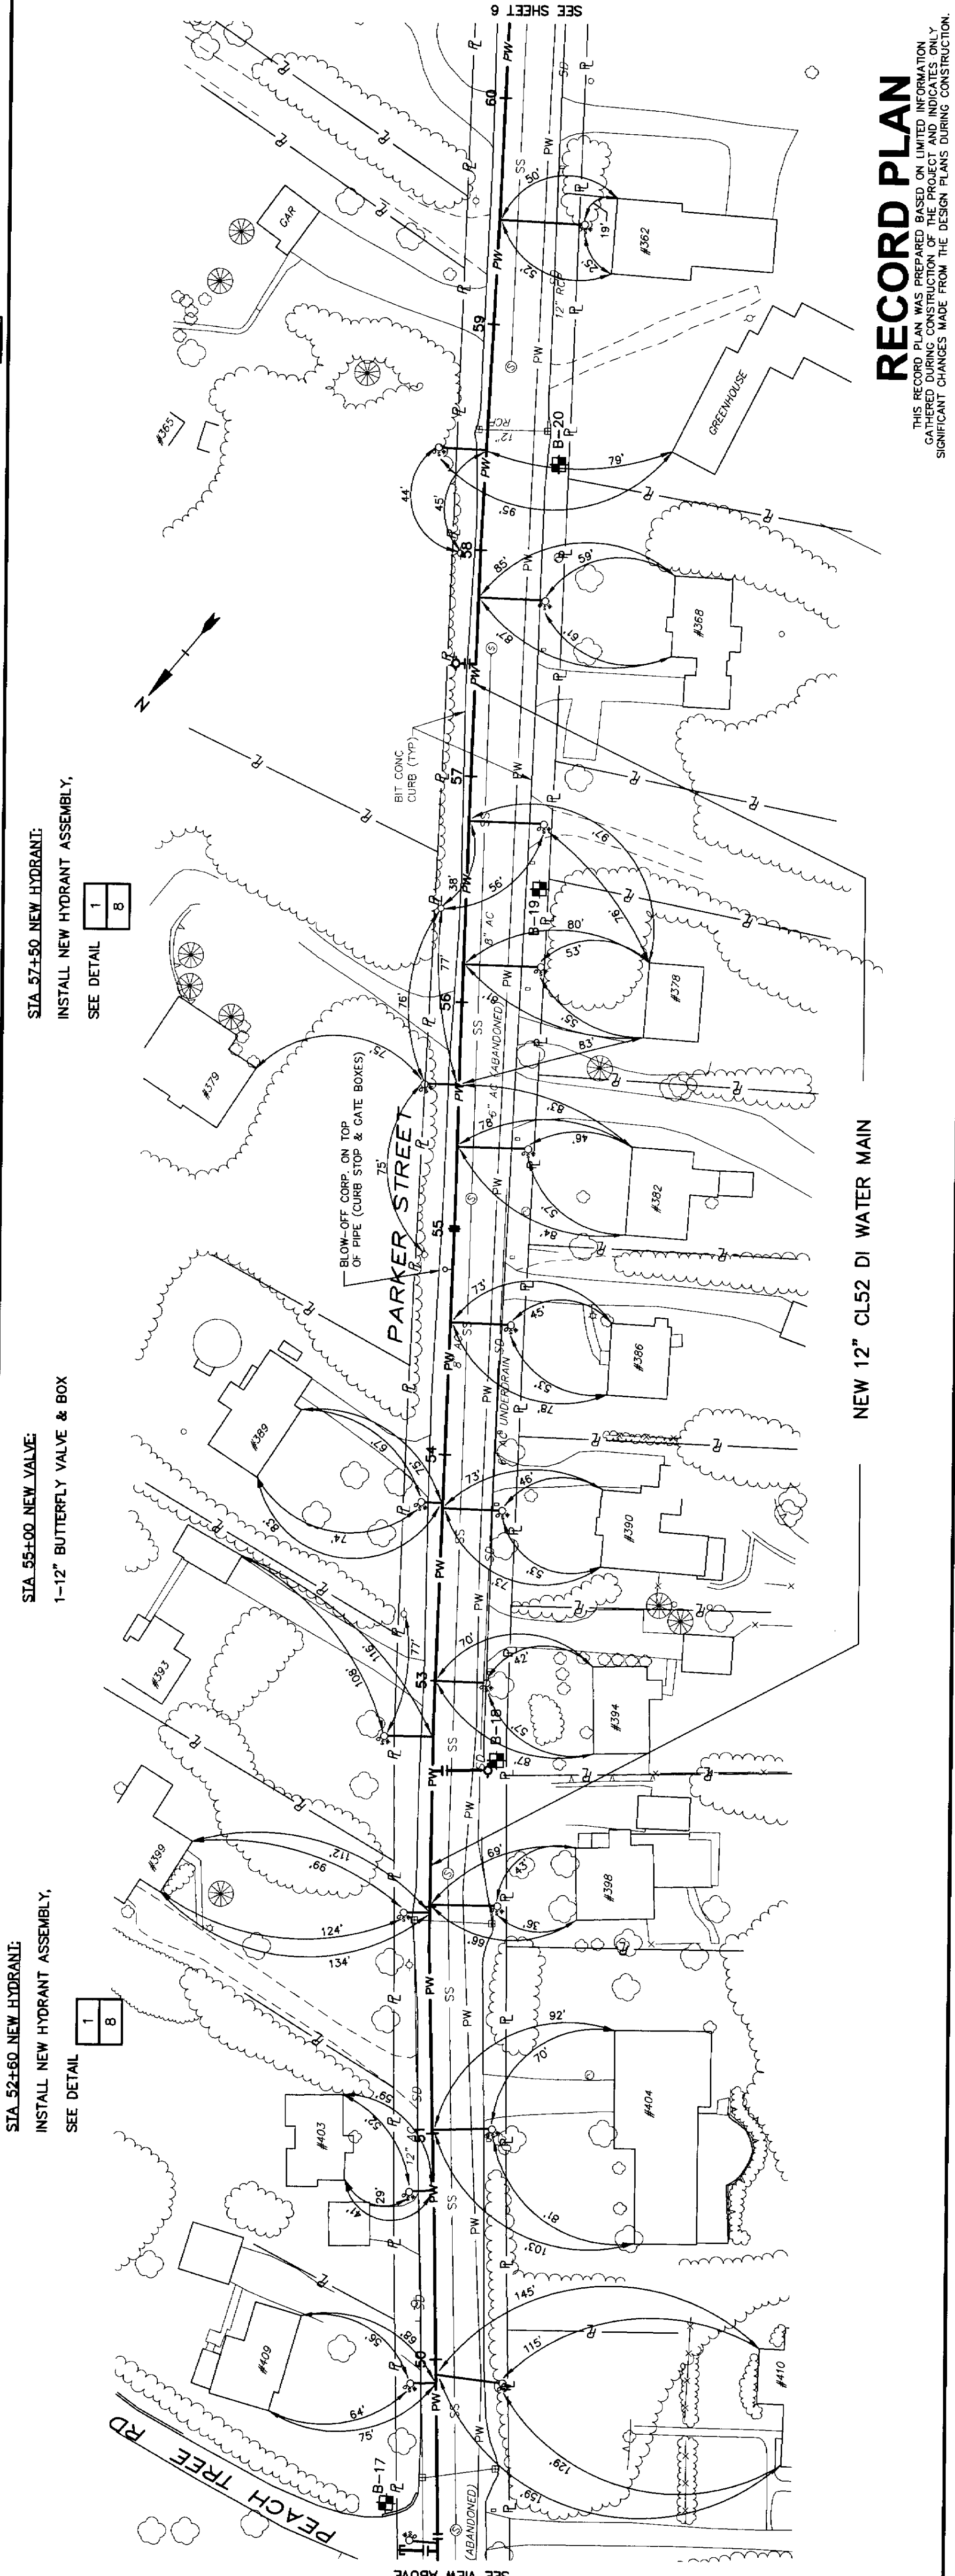

MINI 12 WATER MAIN

RECORD PLAN

THIS RECORD PLAN WAS PREPARED BASED ON LIMITED INFORMATION GATHERED DURING CONSTRUCTION OF THE PROJECT AND INDICATES ONLY SIGNIFICANT CHANGES MADE FROM THE DESIGN PLANS DURING CONSTRUCTION.