



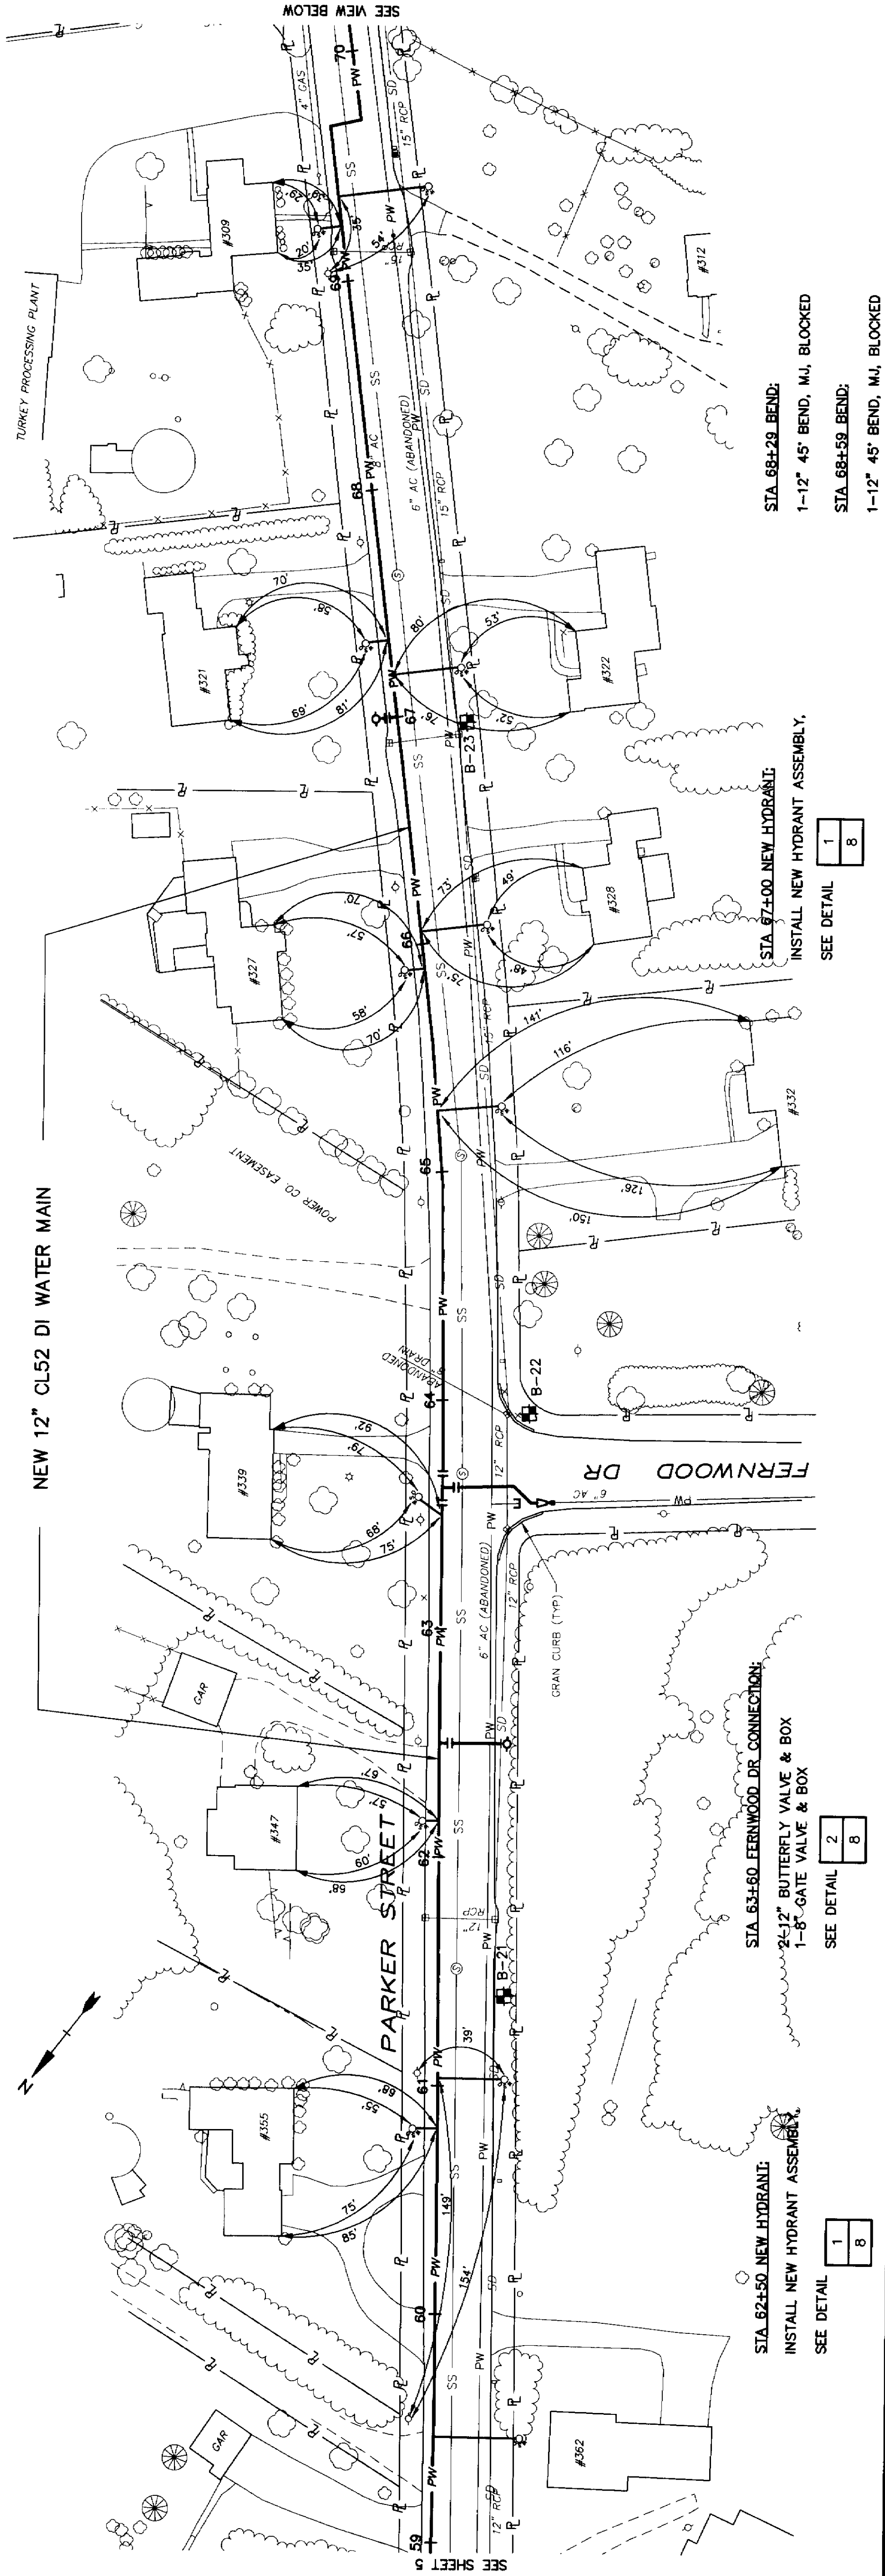

NEW 12" CL52 DI WATER MAIN

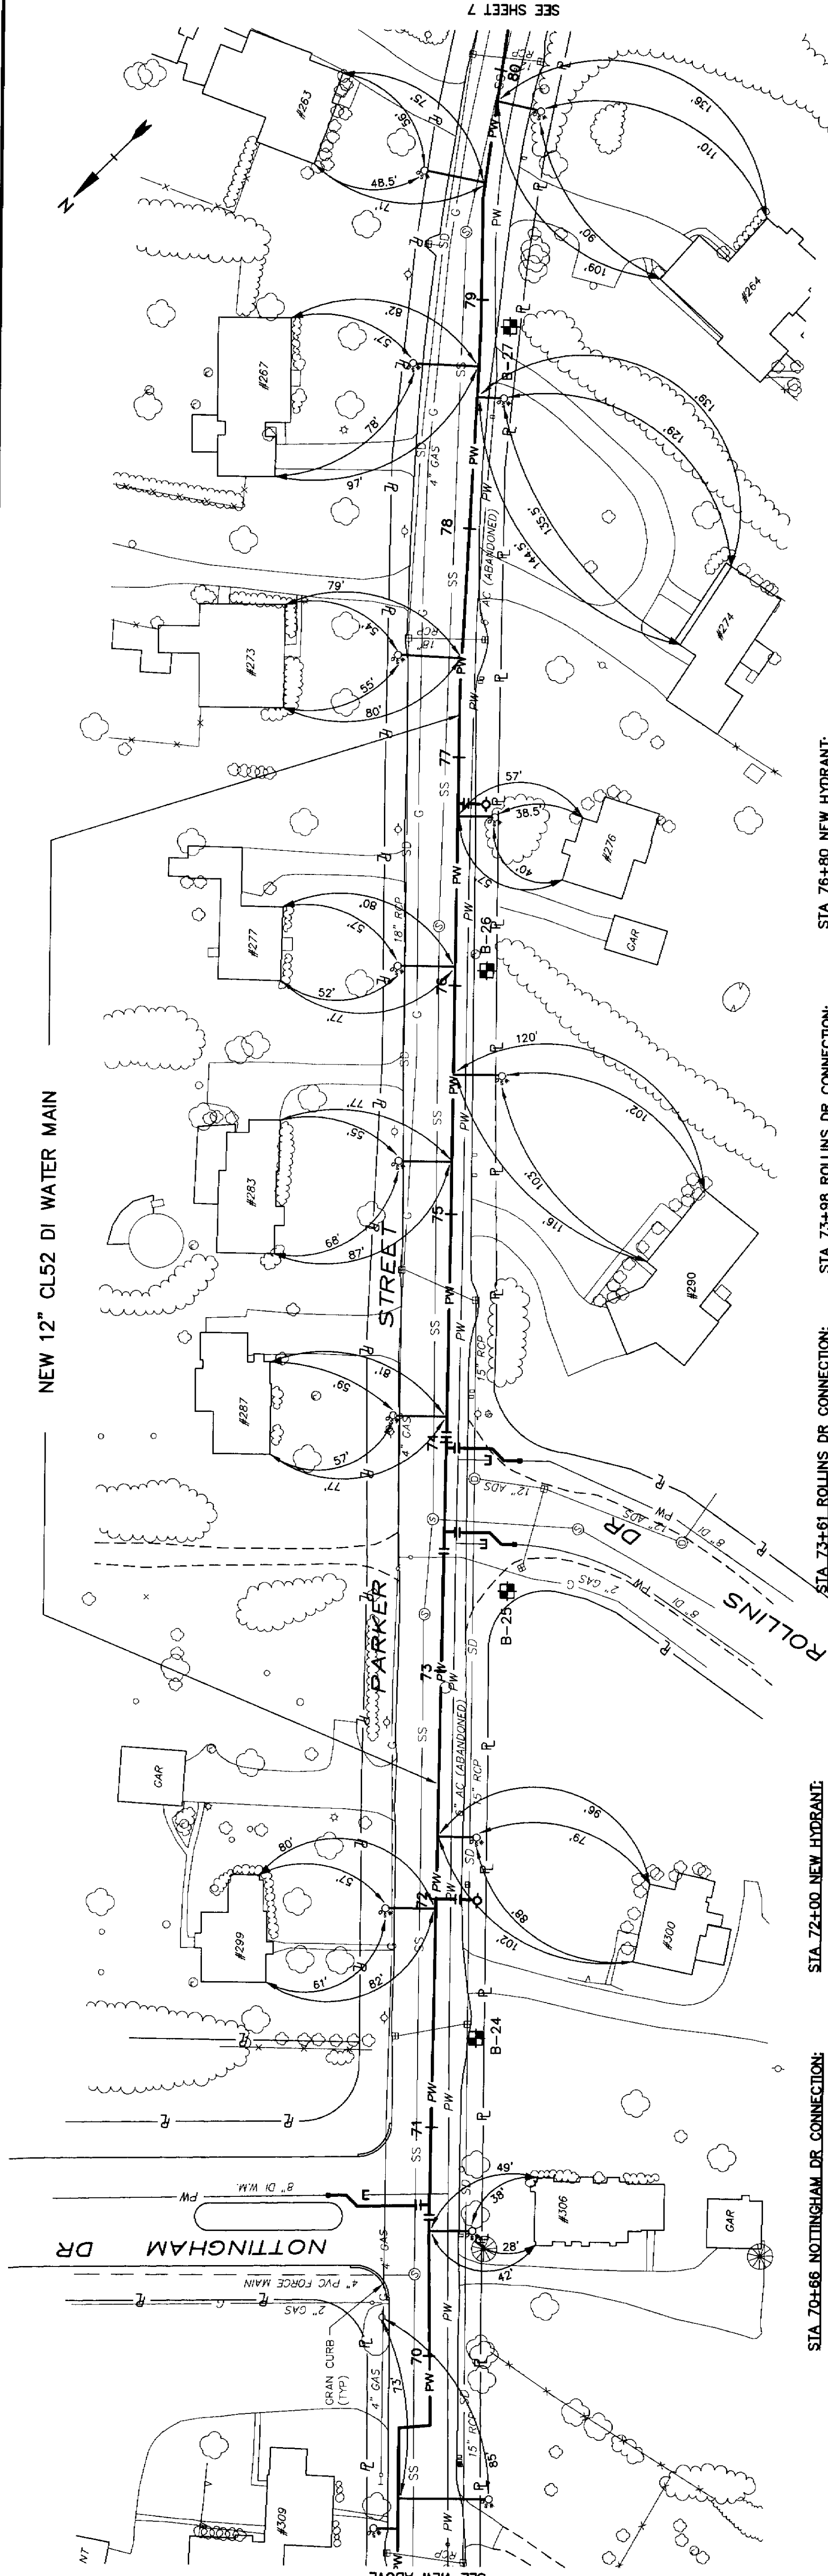

STA 70+66 NOTTINGHAM DR CONNECTION:
1-12" BUTTERFLY VALVE & BOX
1-8" GATE VALVE & BOX
SEE DETAIL 2 8

STA 72+00 NEW HYDRANT:
INSTALL NEW HYDRANT ASSEMBLY,
SEE DETAIL 1 8

STA 73+61 ROLLINS DR CONNECTION:
1-12" BUTTERFLY VALVE & BOX
1-8" GATE VALVE & BOX
SEE DETAIL 2 8

STA 73+88 ROLLINS DR CONNECTION:
1-12" BUTTERFLY VALVE & BOX
1-8" GATE VALVE & BOX
SEE DETAIL 2 8

STA 76+80 NEW HYDRANT:
INSTALL NEW HYDRANT ASSEMBLY,
SEE DETAIL 1 8

RECORD PLAN

THIS RECORD PLAN WAS PREPARED BASED ON LIMITED INFORMATION GATHERED FROM THE FIELD AND DESIGNED FOR CONSTRUCTION. SIGNIFICANT CHANGES MADE FROM THE DESIGN PLANS DURING CONSTRUCTION.

SCALE: 1" = 40'

SHEET 6 OF 10

**Parker Street
Water Main
Replacement**

**Department of
Public Works**

**East Longmeadow,
Massachusetts**

B	1200	RECORD PLAN
A	0503	FINAL ISSUE
Mark	Date	Description
PROJECT NO.	EG0512-02	
FILE	EG0512PARKERWWSHT6	
DRAWN BY:	DJB	
CHECKED:	JT	
APPROVED BY:	RP	
PARKER STREET STA 60+00 TO STA 80+00		
SCALE:	1" = 40'	

12/15/03