


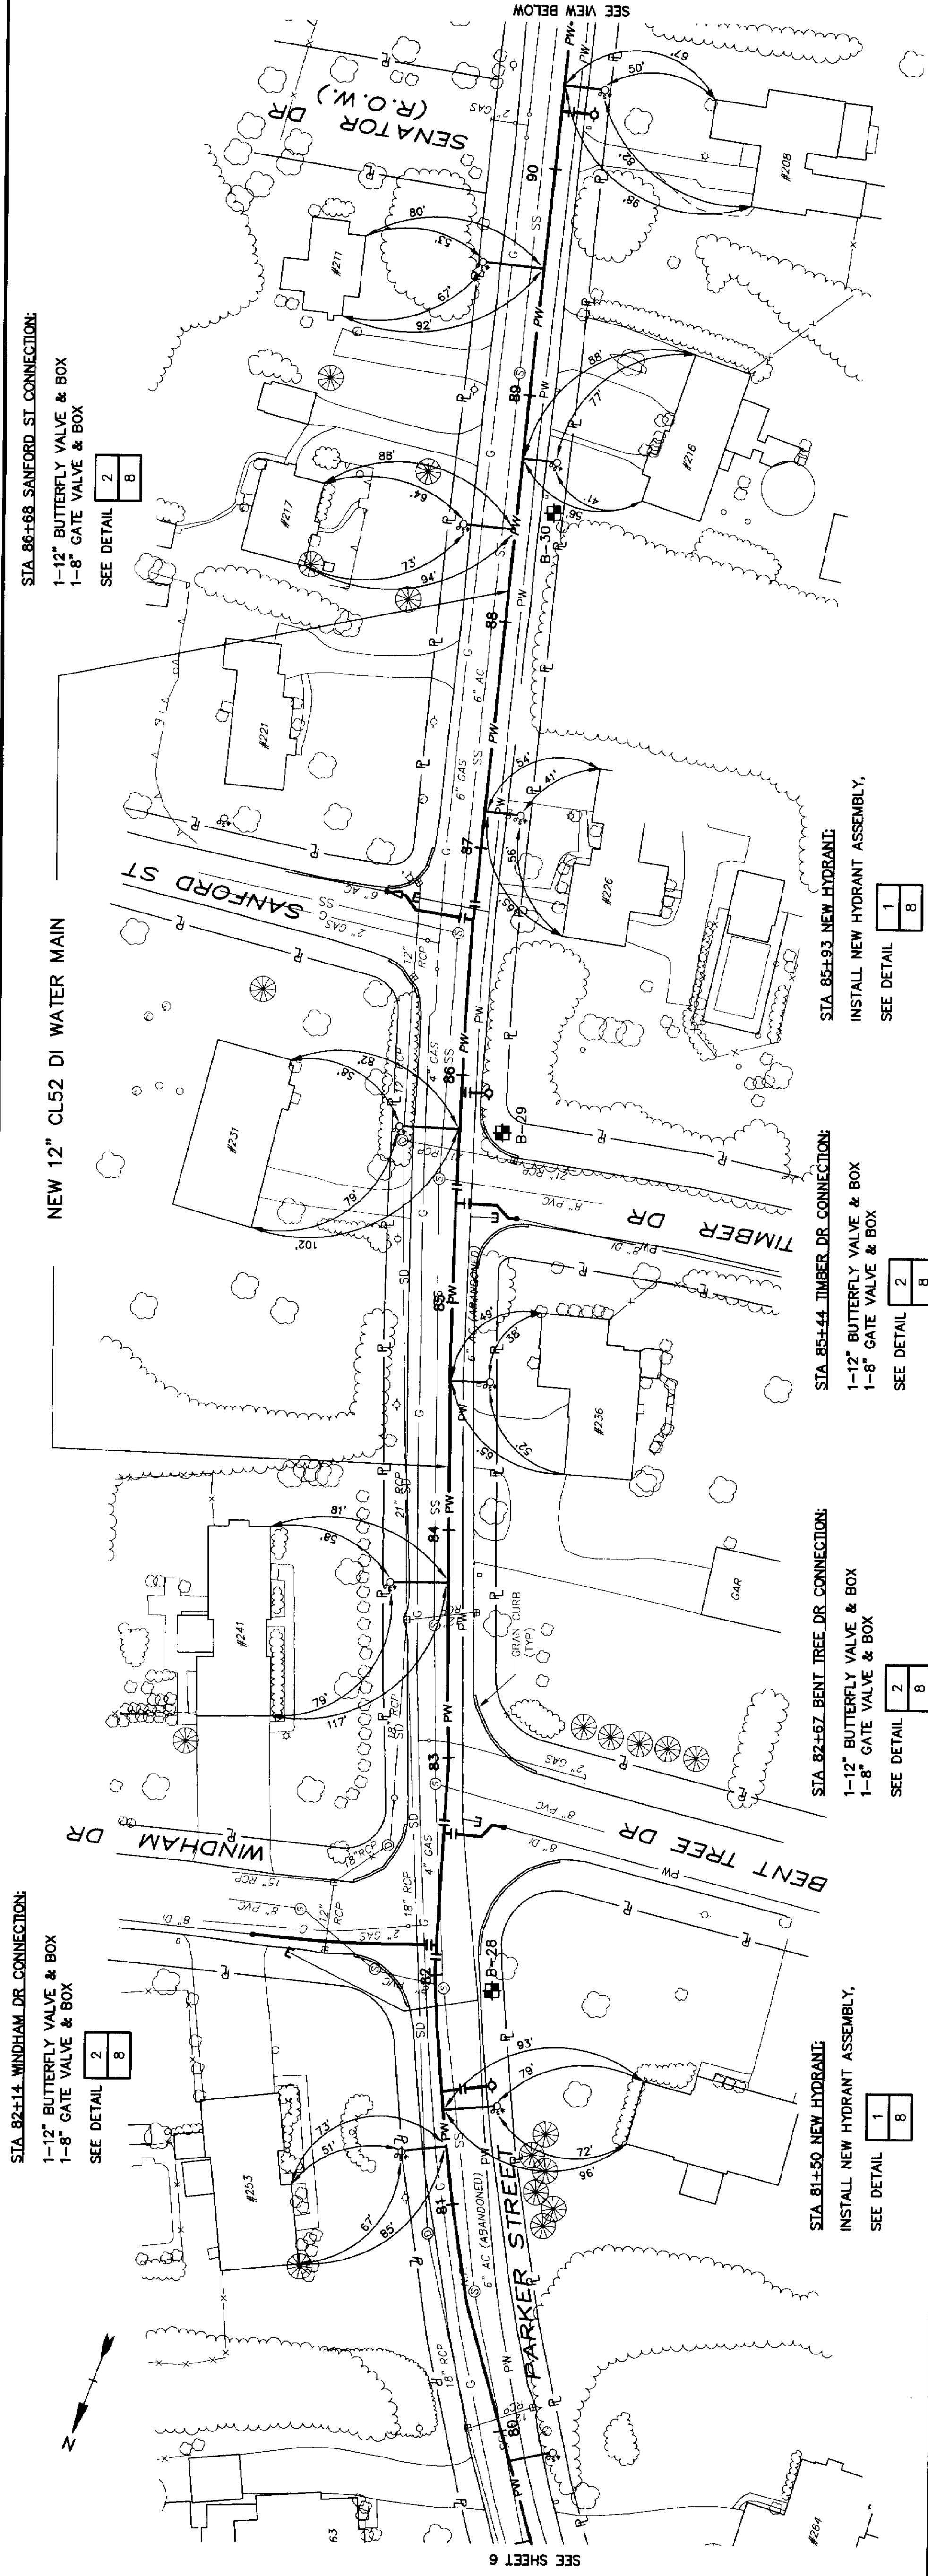

Parker Street Water Main Replacement

Department of
Public Works

**East Longmeadow,
Massachusetts**

	B	1203	RECORD PLAN	
	A	0603	FINAL ISSUE	
	Mick	Date	Description	
		PROJECT NO.	E04S1-2-02	
		FILE	E04S1/PARKER/MHSHT7	
		DRAWN BY:	QTY	
		CHECKED	JT	
		APPROVED BY:	RP	
		PARKER STREET		
		STA 80+00 TO STA 99+00		
		SCALE:	1" = 40'	

RECORD PLAN

THIS RECORD PLAN WAS PREPARED BASED ON LIMITED INFORMATION GATHERED DURING CONSTRUCTION OF THE PROJECT AND INDICATES ONLY SIGNIFICANT CHANGES MADE FROM THE DESIGN PLANS DURING CONSTRUCTION.

11

