


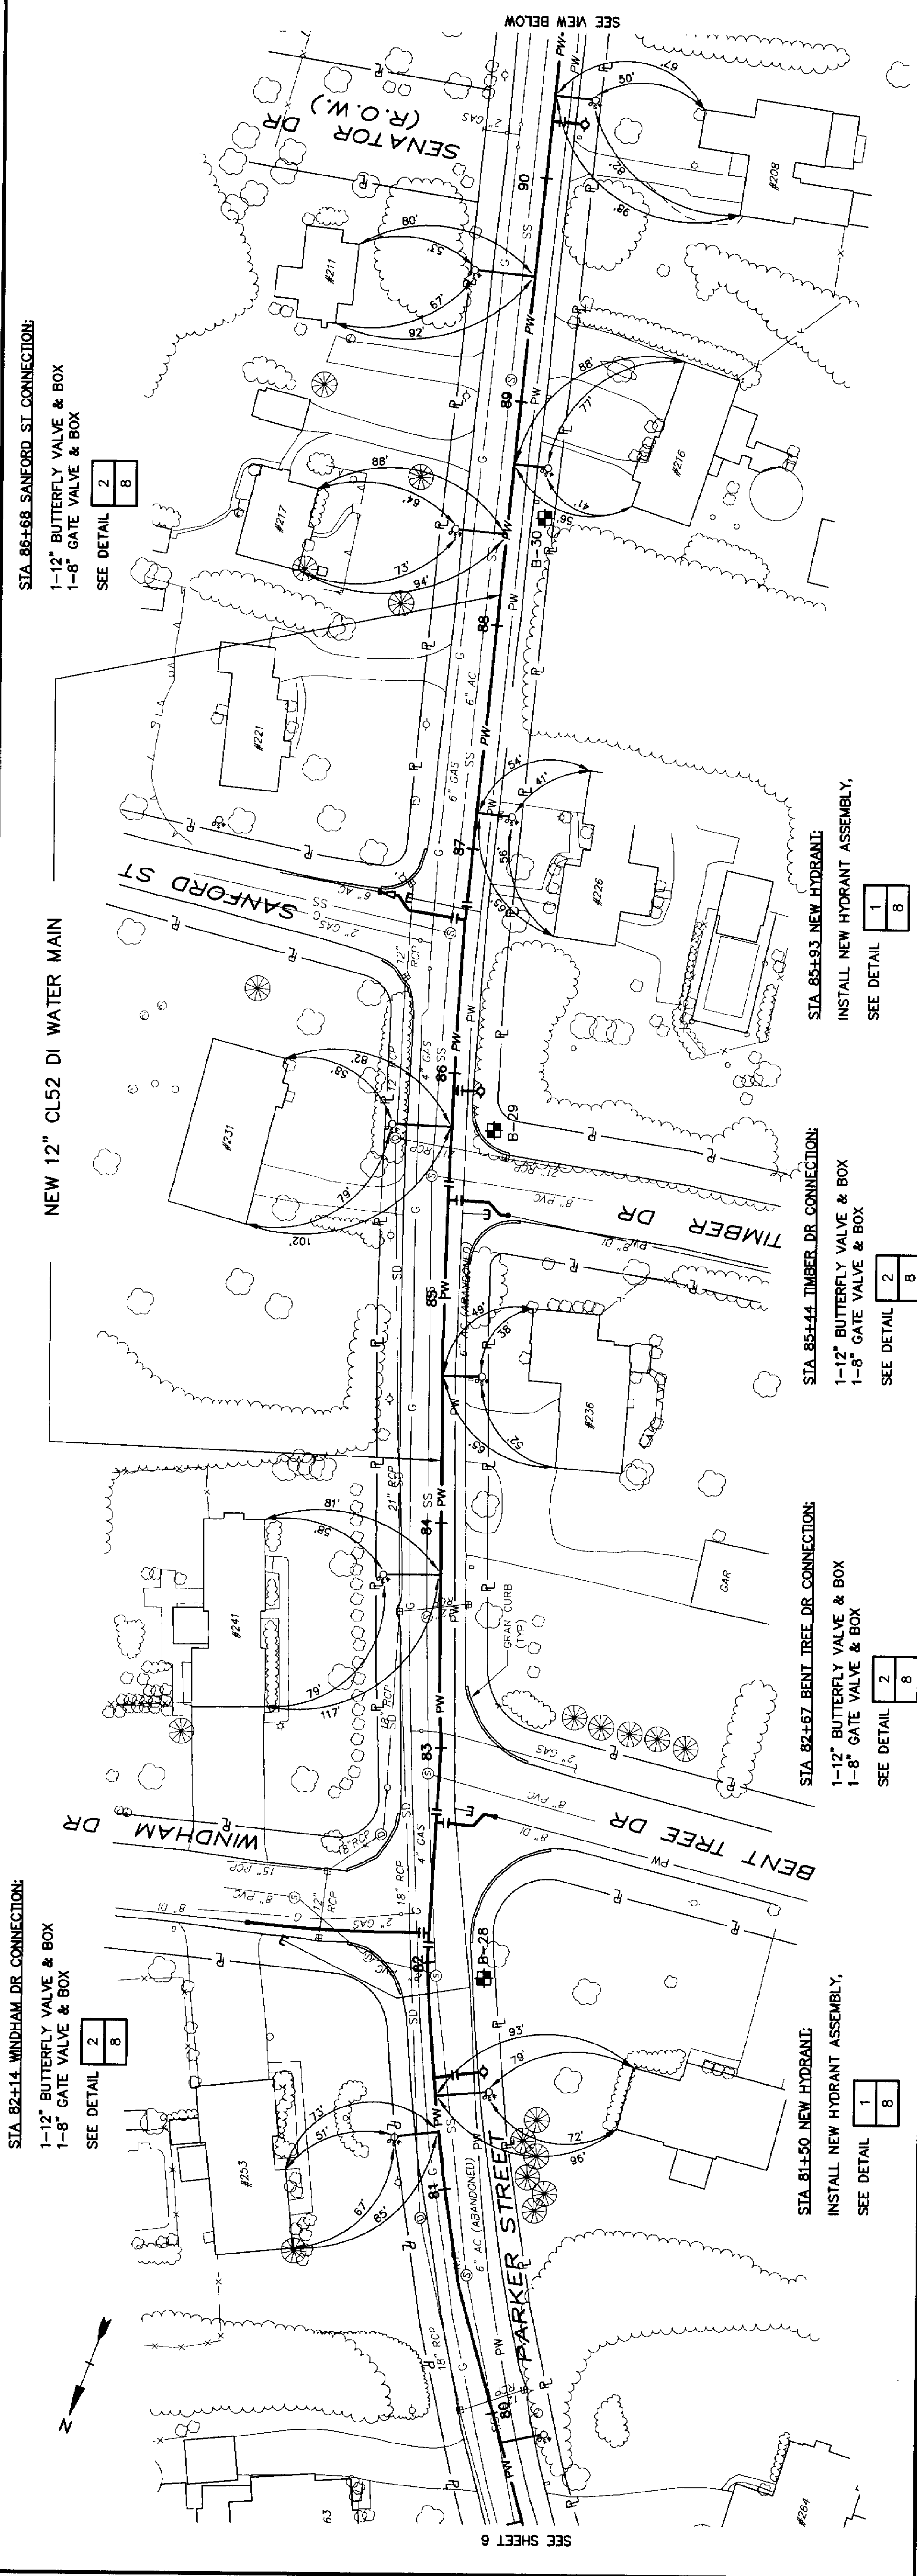


**Parker Street
Water Main
Replacement**

Department of
Public Works

East Longmeadow,
Massachusetts

PROJECT NO.	EA4512-02
FILE	EA4512-02
DRAWN BY	EA4512-02
CHECKED	EA4512-02
APPROVED BY	EA4512-02
DATE	12/15/03
SCALE	1" = 40'
SHEET	7 OF 10

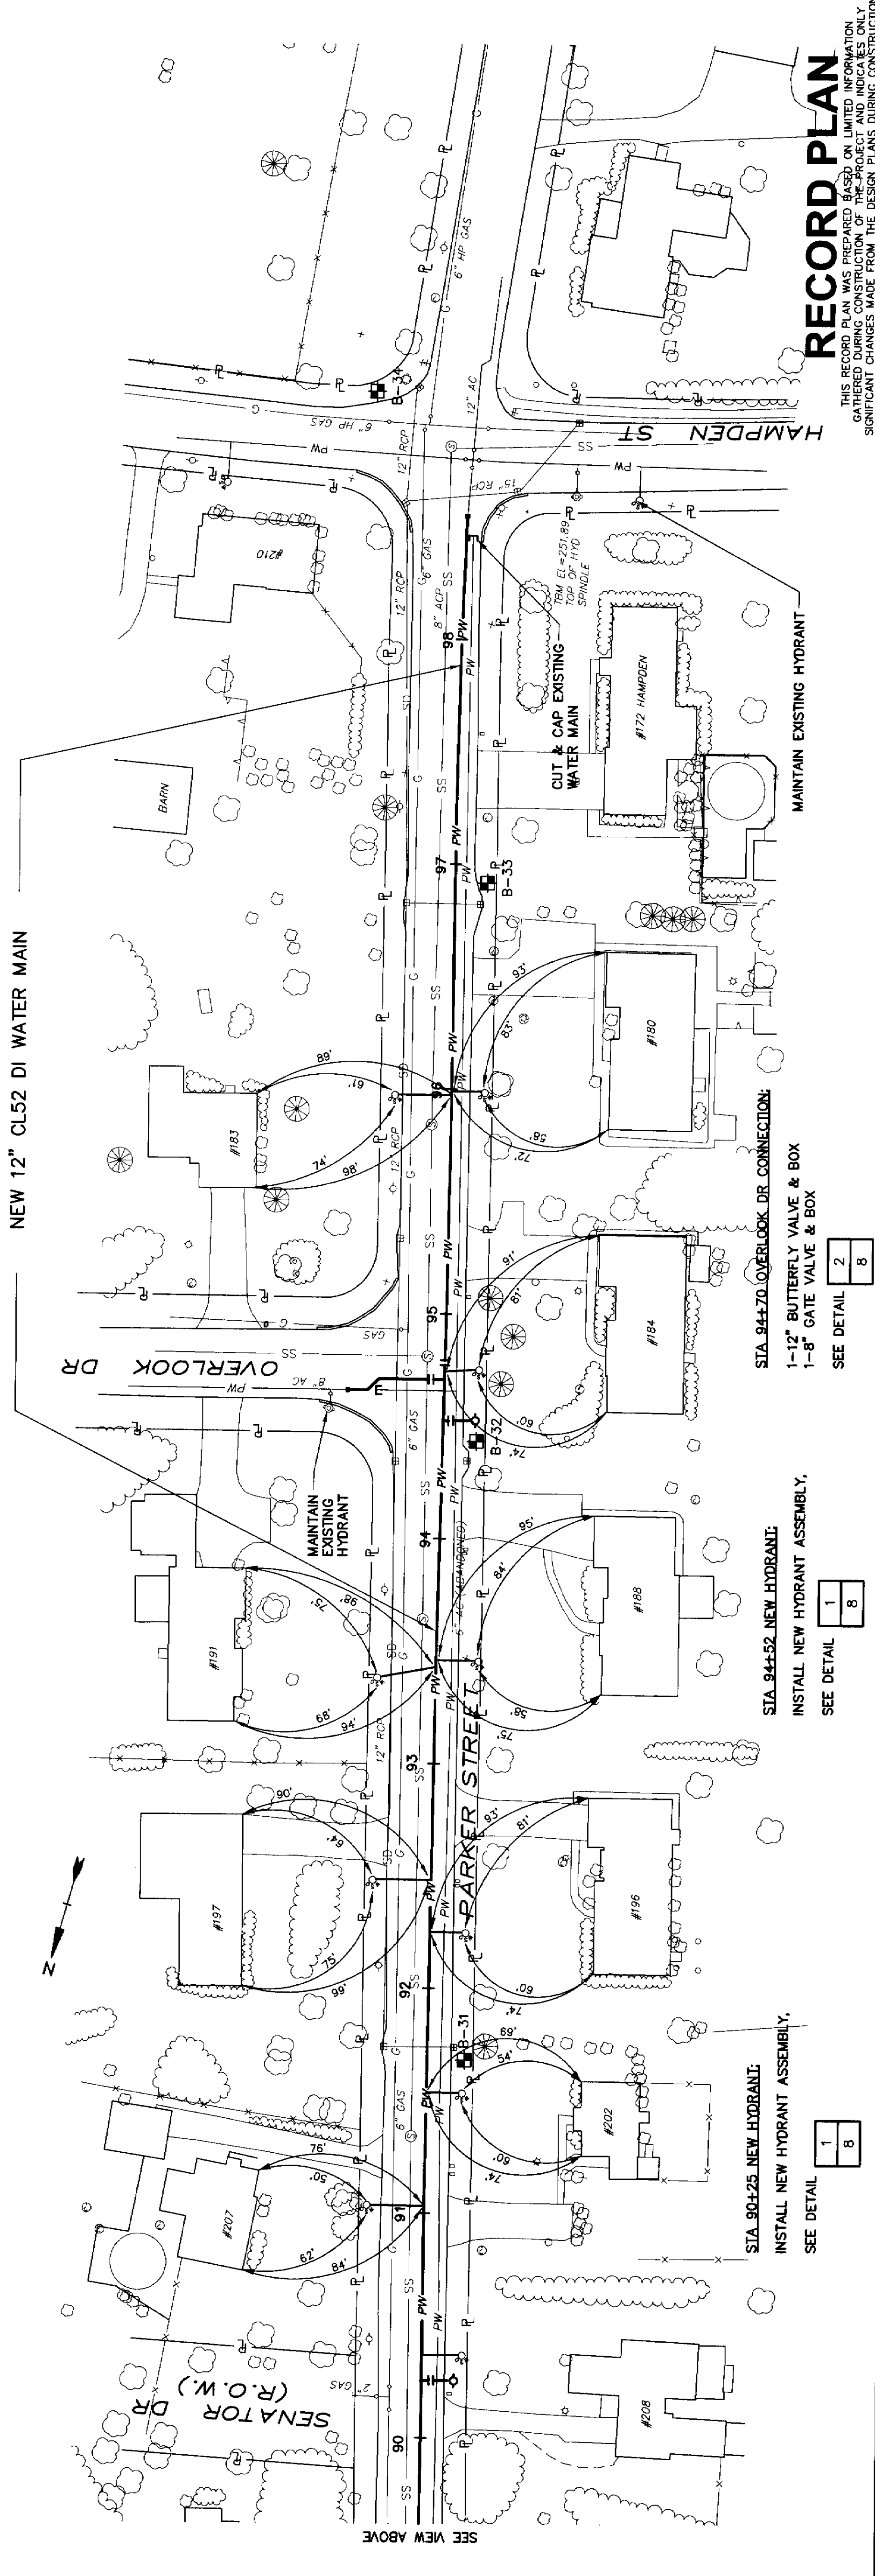

RECORD PLAN

THIS RECORD PLAN WAS PREPARED BASED ON LIMITED INFORMATION
OBTAINED FROM THE FIELD AND INDICATES ONLY
SIGNIFICANT CHANGES MADE FROM THE DESIGN PLANS DURING CONSTRUCTION.