


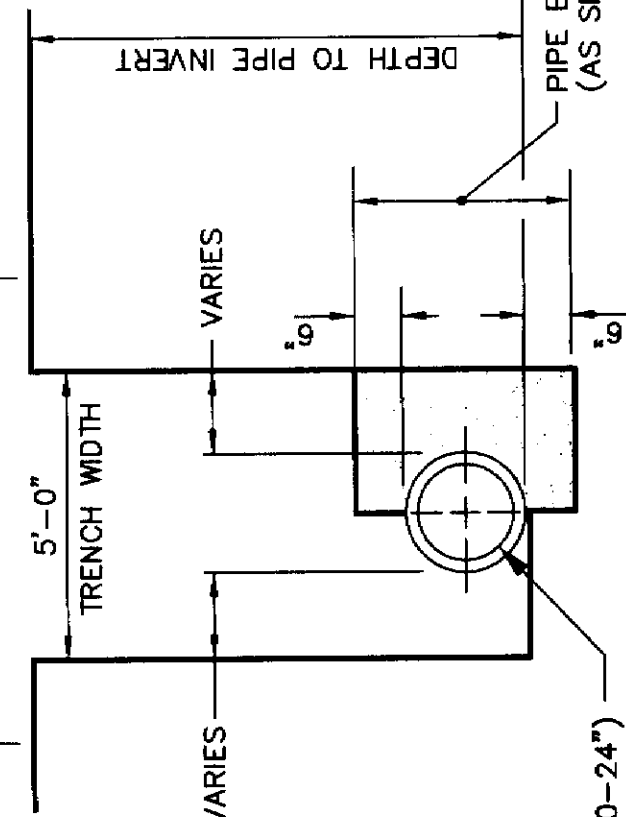

TYPICAL TRENCH SECTION

EARTH AND ROCK EXCAVATION PIPE TRENCH
PAYLINE LIMITS

TRENCH PAVEMENT REPAIR

NOTES:
1. THE PAYLINE DIMENSIONS SHOWN REPRESENT THE MAXIMUM PAYLINE LIMITS TO BE PAID. WHEN THE ACTUAL SURFACE REPAIR OR TRENCH WIDTH IS LESS, THE ACTUAL WIDTH SHALL BE PAID FOR AT THE APPLICABLE UNIT PRICE.

TRENCH PAY LINES



NOTES:

1. FOR HAY BALES INSTALLED ON UNPAVED SURFACES, A MINIMUM TWO WOOD STAKES REQUIRED PER HAY BALE. STEEL DOWELS SHALL BE UTILIZED WHERE WOOD STAKES CANT BE DRIVEN INTO GROUND.
2. STAKES SHALL NOT BE USED FOR HAY BALES INSTALLED ON PAVED SURFACES.
3. HAYBALES SHALL BE INSTALLED AROUND ALL CATCH-BASINS IN THE PROJECT AREA.

WATER SERVICE CONNECTION

CATCH BASIN INLET SEDIMENTATION CONTROL DETAIL

RECORD PLAN

THIS RECORD PLAN WAS PREPARED BASED ON LIMITED INFORMATION GATHERED DURING CONSTRUCTION OF THE PROJECT AND INDICATES ONLY SIGNIFICANT CHANGES MADE FROM THE DESIGN PLANS DURING CONSTRUCTION.

2/15/03

Parker Street Water Main Replacement

Department of
Public Works

East Longmeadow,
Massachusetts

FILE:	E0451PARKERMMDETAILS		
DRAWN BY:	CFY		
CHECKED:	JP		
APPROVED BY:	RT		
PROJECT NO:	E0451-2-02		
Mark	Date	Description	
A	05/03	FINAL ISSUE	
B	12/03	RECORD PLAN	

MISCELLANEOUS DETAILS - 2

SCALE: NO SCALE

SHEET 9 OF 10