



LOCATION MAP
SCALE: 1"=100'

DRAWING INDEX


SHEET NO.	TITLE
G-1	ABBREVIATIONS, NOTES, AND LEGEND
C-1	SOUTH BEND ROAD - STATION 0+00 TO 14+80
C-1	SOMERS ROAD - STATION 0+00 TO 7+65
C-2	SOMERS ROAD - STATION 7+65 TO 11+47
C-3	DETAILS

TOWN OF EAST LONGMEADOW, MASSACHUSETTS

BOARD OF PUBLIC WORKS

SOMERS ROAD HIGH SERVICE WATER MAIN REPLACEMENT

JUNE 2000

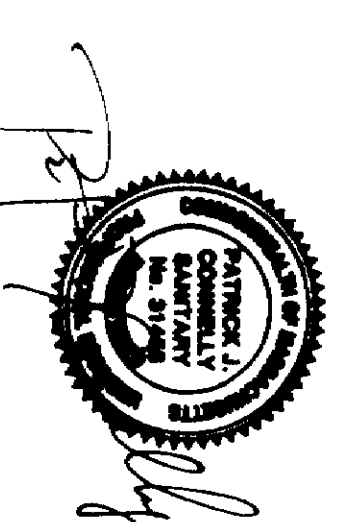

**WESTON & SAMPSON
ENGINEERS, INC.**

Five Centennial Drive, Pedbody, Massachusetts 01960

RECORD DRAWING