
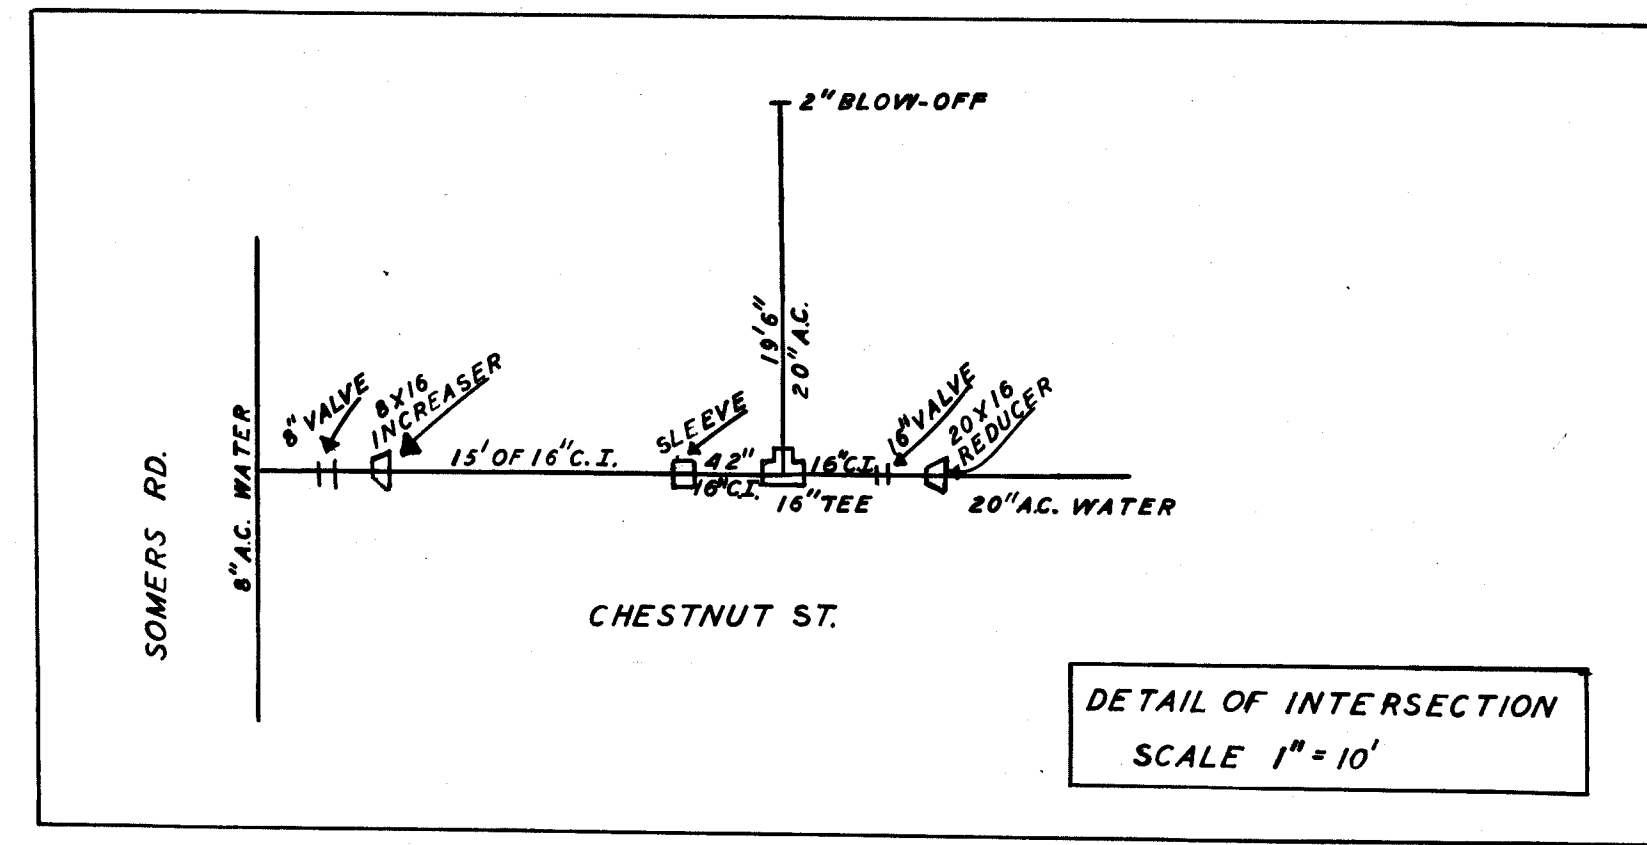


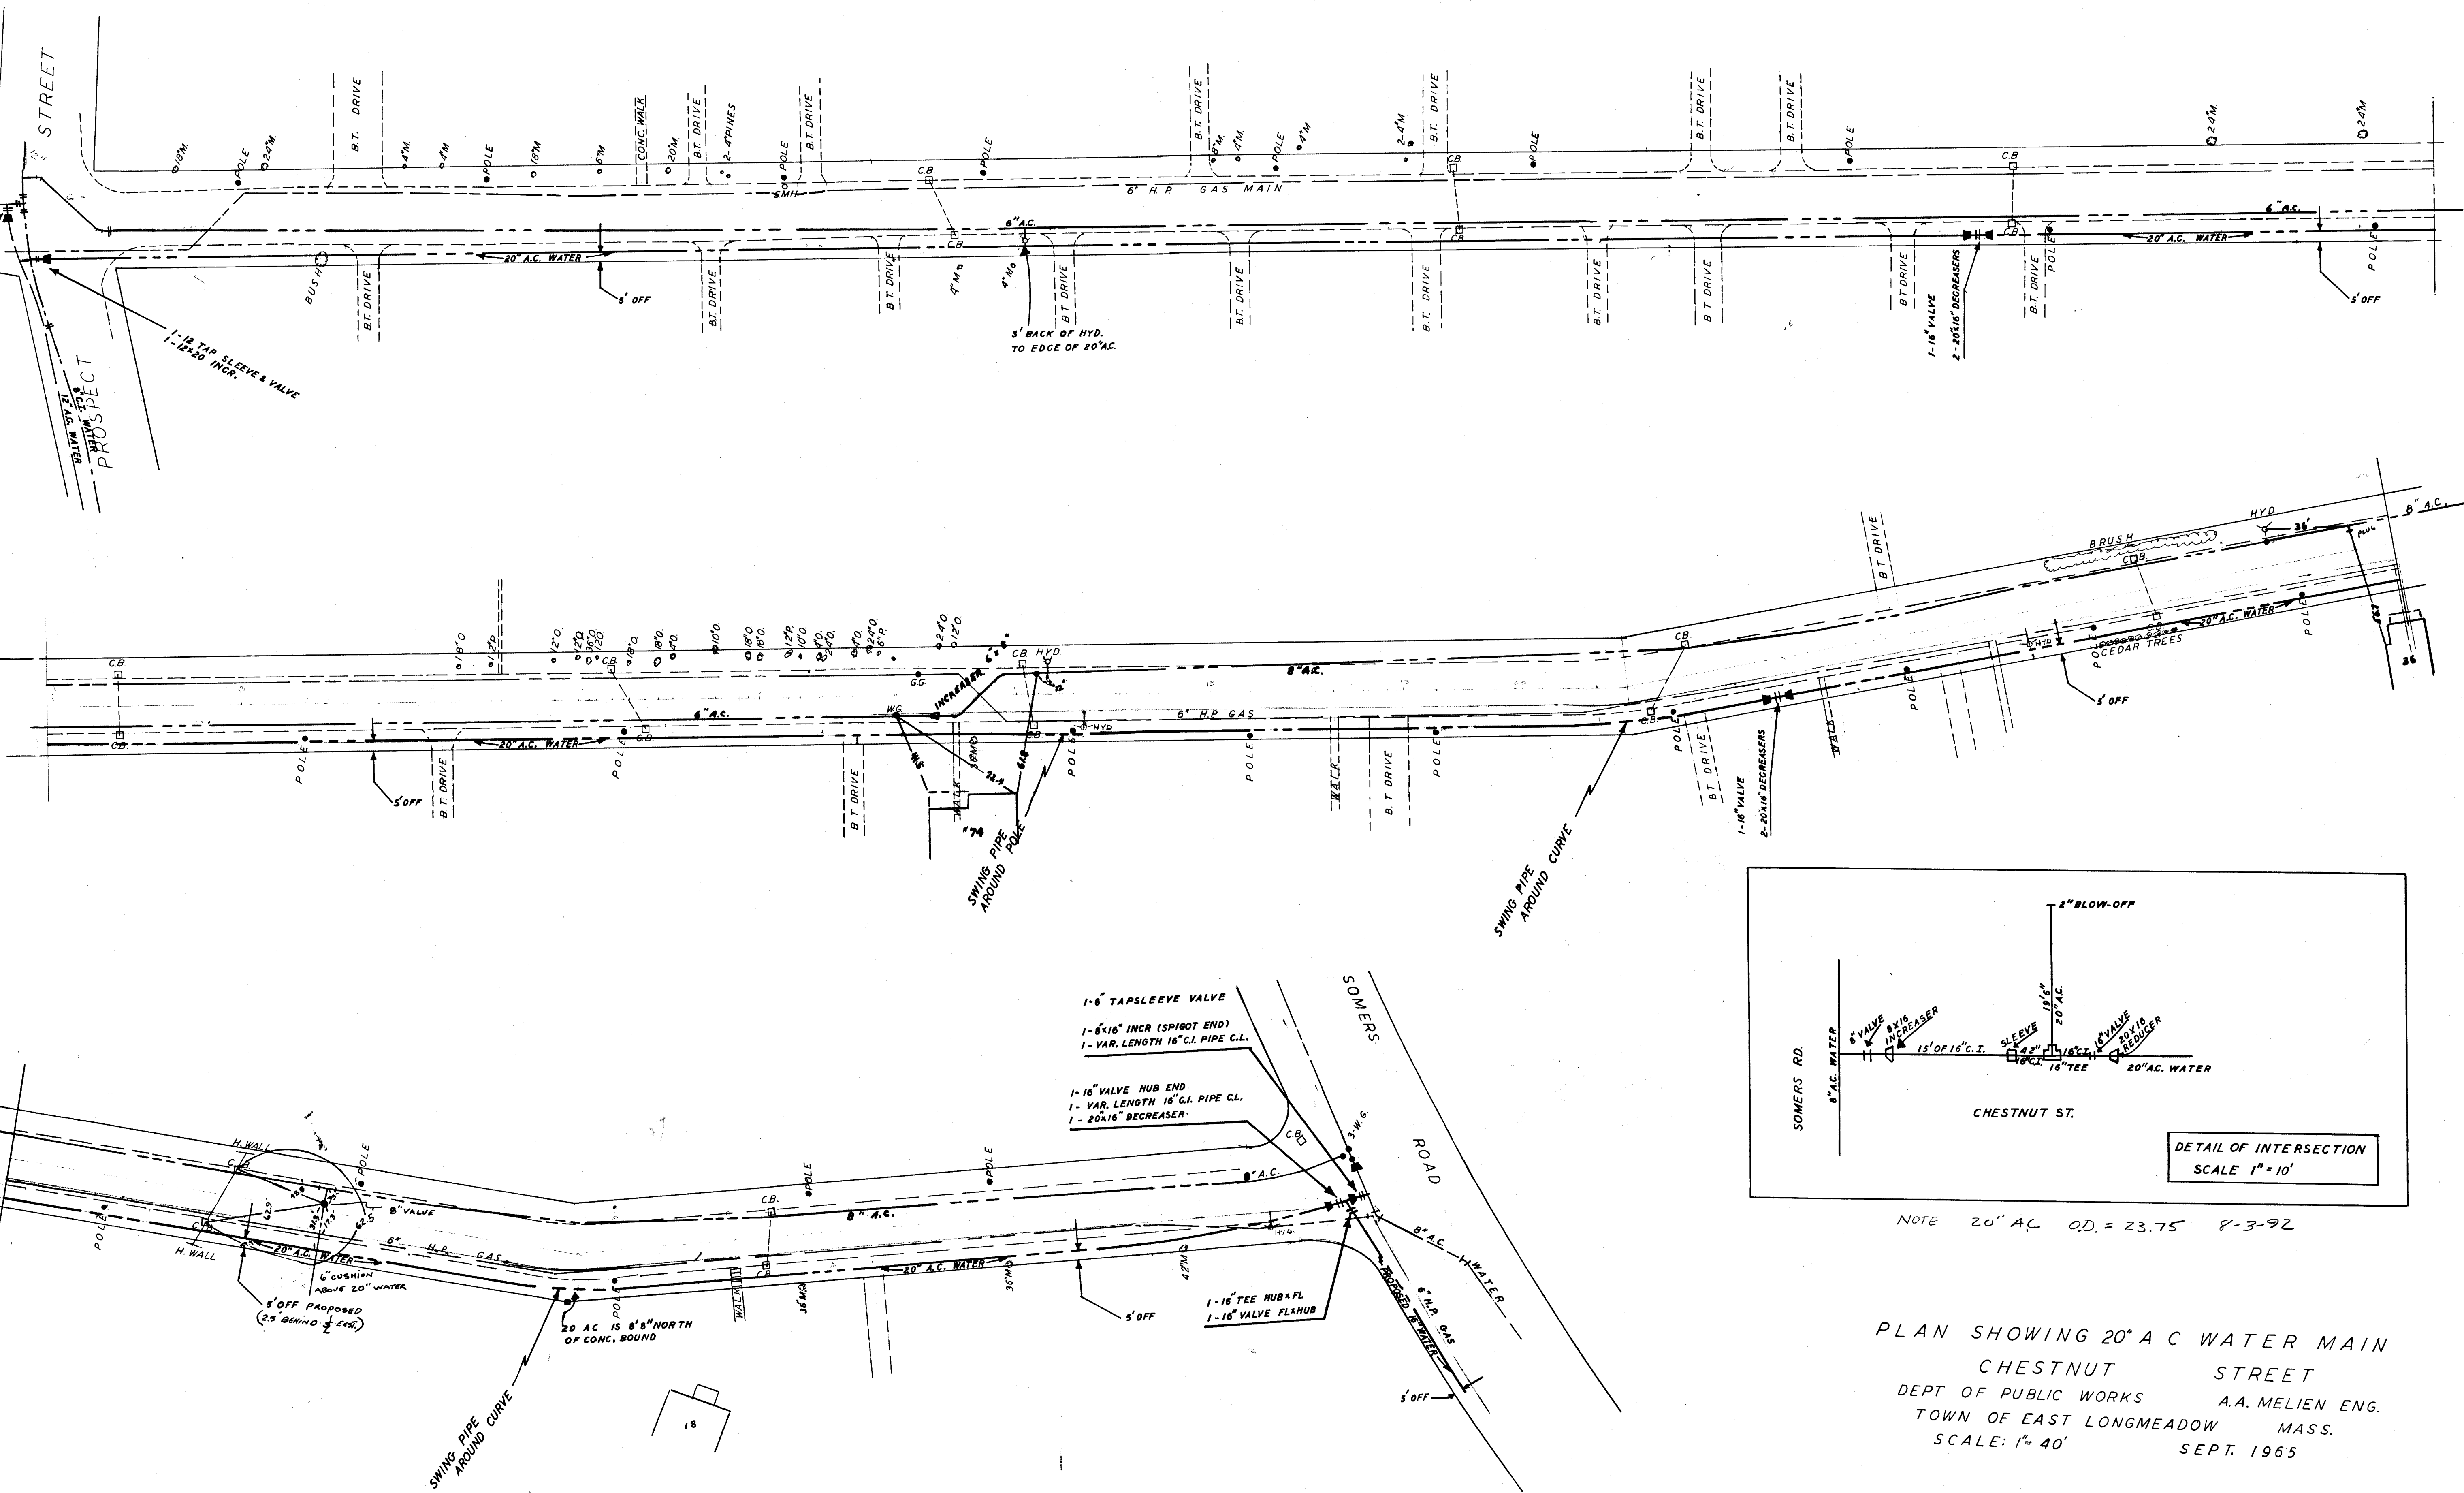

NOTE 20" A.C. O.D. = 23.75 8-3-92

PLAN SHOWING 20" A.C. WATER MAIN
 CHESTNUT STREET
 DEPT OF PUBLIC WORKS A.A. MELIEN ENG.
 TOWN OF EAST LONGMEADOW MASS.
 SCALE: 1" = 40' SEPT. 1965