

WATER LINE RIGHT OF WAY TO BE RECORDED BY DEED UPON SALE  
OF PROPERTY OF GORDON DIX 47 BREEZY KNOLL ROAD, EAST LONGMEADOW, MASS.  
THIS WATER LINE WILL SERVICE NEW RESIDENCE AT 43 BREEZY KNOLL ROAD.

43  
BREEZY  
KNOLL

*Gordon Dix*


3/4" COPPER

PROPERTY LINE

45'

*Alfred A. Melior Jr.*

My Commission Expires  
Nov. 10, 1972

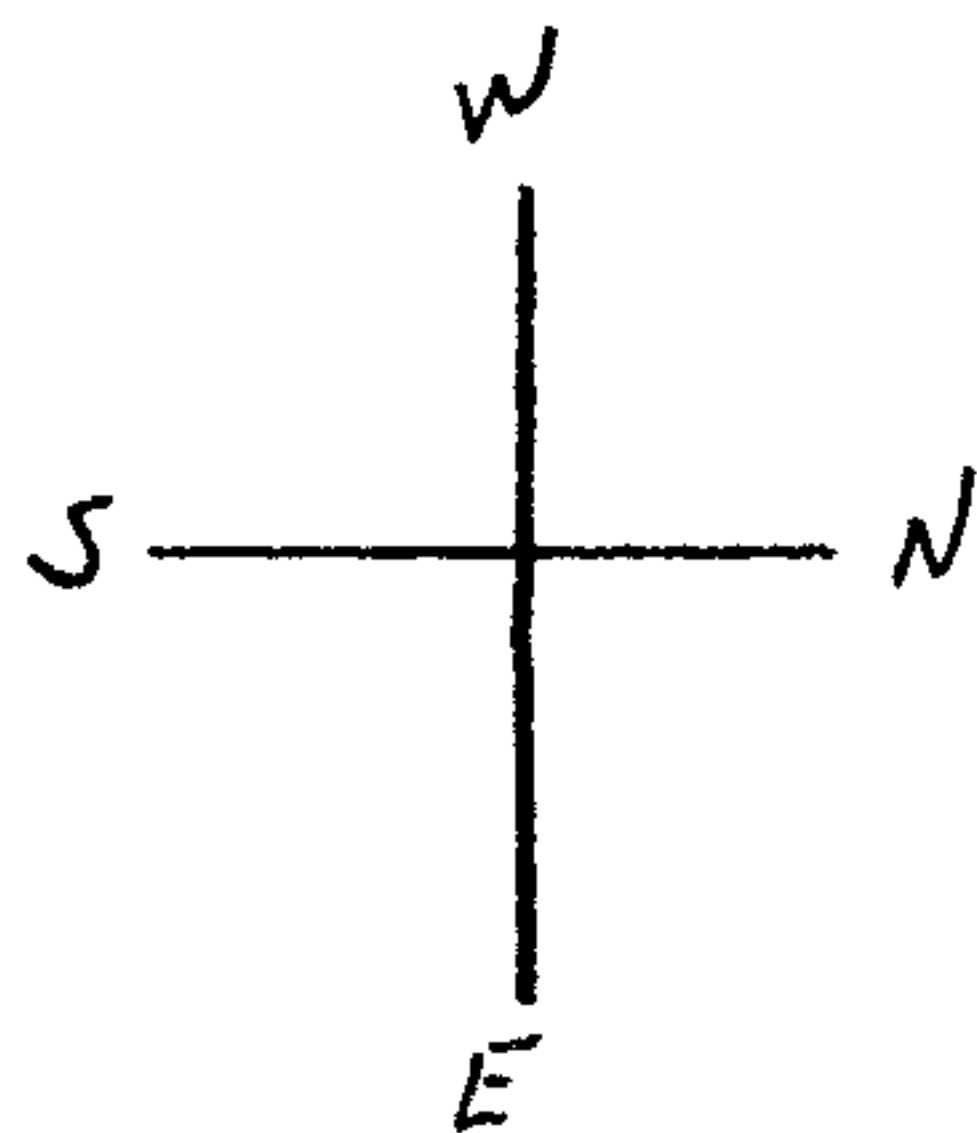

GARAGE

BREEZY KNOLL ROAD

47  
BREEZY KNOLL

8'  
RIGHT  
OF  
WAY

13'

32'6"

PRESENT ONE INCH  
ENTRANCE 4' FROM NE  
CORNER

15'  
0-0

INSTALL SHUT OFF  
VALVES TWO

W-293