



8/14/00	REVISED LOT LAYOUT, CROSS-CULVERT AND SEWER HOUSE CONNECTIONS	EDM
11/16/00	ADDED LOT "A"	EDM

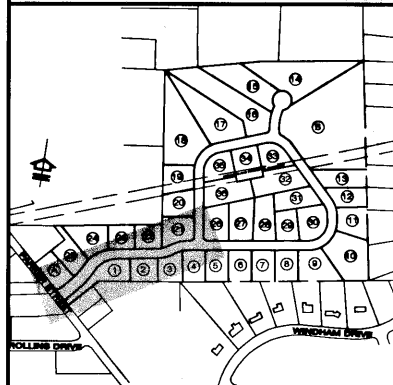

KEY MAP
SCALE: 1" = 600'

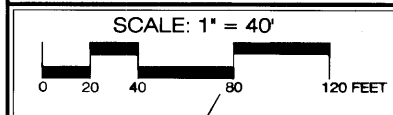

- LEGEND**
- PROPOSED PROPERTY LINE
 - EXISTING PRIMARY PROPERTY LINE
 - EXISTING 10' INTERVAL CONTOUR
 - EXISTING 2' INTERVAL CONTOUR
 - PROPOSED 2' INTERVAL CONTOUR
 - EXISTING EDGE OF PAVEMENT
 - PROPOSED BITUMINOUS CURB
 - SOIL TEST BORING (APPROXIMATE LOCATION)
 - PROPOSED ROADWAY CENTER LINE AND STATIONING
 - PROPOSED LEACHING BASIN
 - PROPOSED STORM DRAIN MANHOLE
 - PROPOSED SEWER MANHOLE
 - PROPOSED CATCH BASIN
 - PROPOSED STORM DRAIN LINE
 - PROPOSED SANITARY SEWER
 - PROPOSED SEWER FORCE MAIN
 - PROPOSED WATER LINE
 - PROPOSED WATER GATE
 - EXISTING SANITARY SEWER
 - WETLAND BOUNDARY LINE
 - 100 FT. WETLAND BUFFER

SHEET TITLE:
PLAN/PROFILE No. 1
NOTTINGHAM DRIVE
STA 10+00 - 21+00

PROJECT AND LOCATION:
NOTTINGHAM MEADOWS
EAST LONGMEADOW, MA

PREPARED FOR:
APPLE
LAND DEVELOPMENT, INC.
296 NORTH MAIN STREET
EAST LONGMEADOW, MA


DESIGNED BY:
BAYSTATE ENVIRONMENTAL
CONSULTANTS INC.

Civil Engineers Environmental Scientists
296 North Main Street East Longmeadow, MA 01028


PROJECT No. 99-1194
SCALE: VERT. 1"=4' HOR. 1"=40'
DATE: 6/2000
DESIGNED BY: F.A.D.
CHECKED BY: M.L.P.

6
6 of 12

W-494

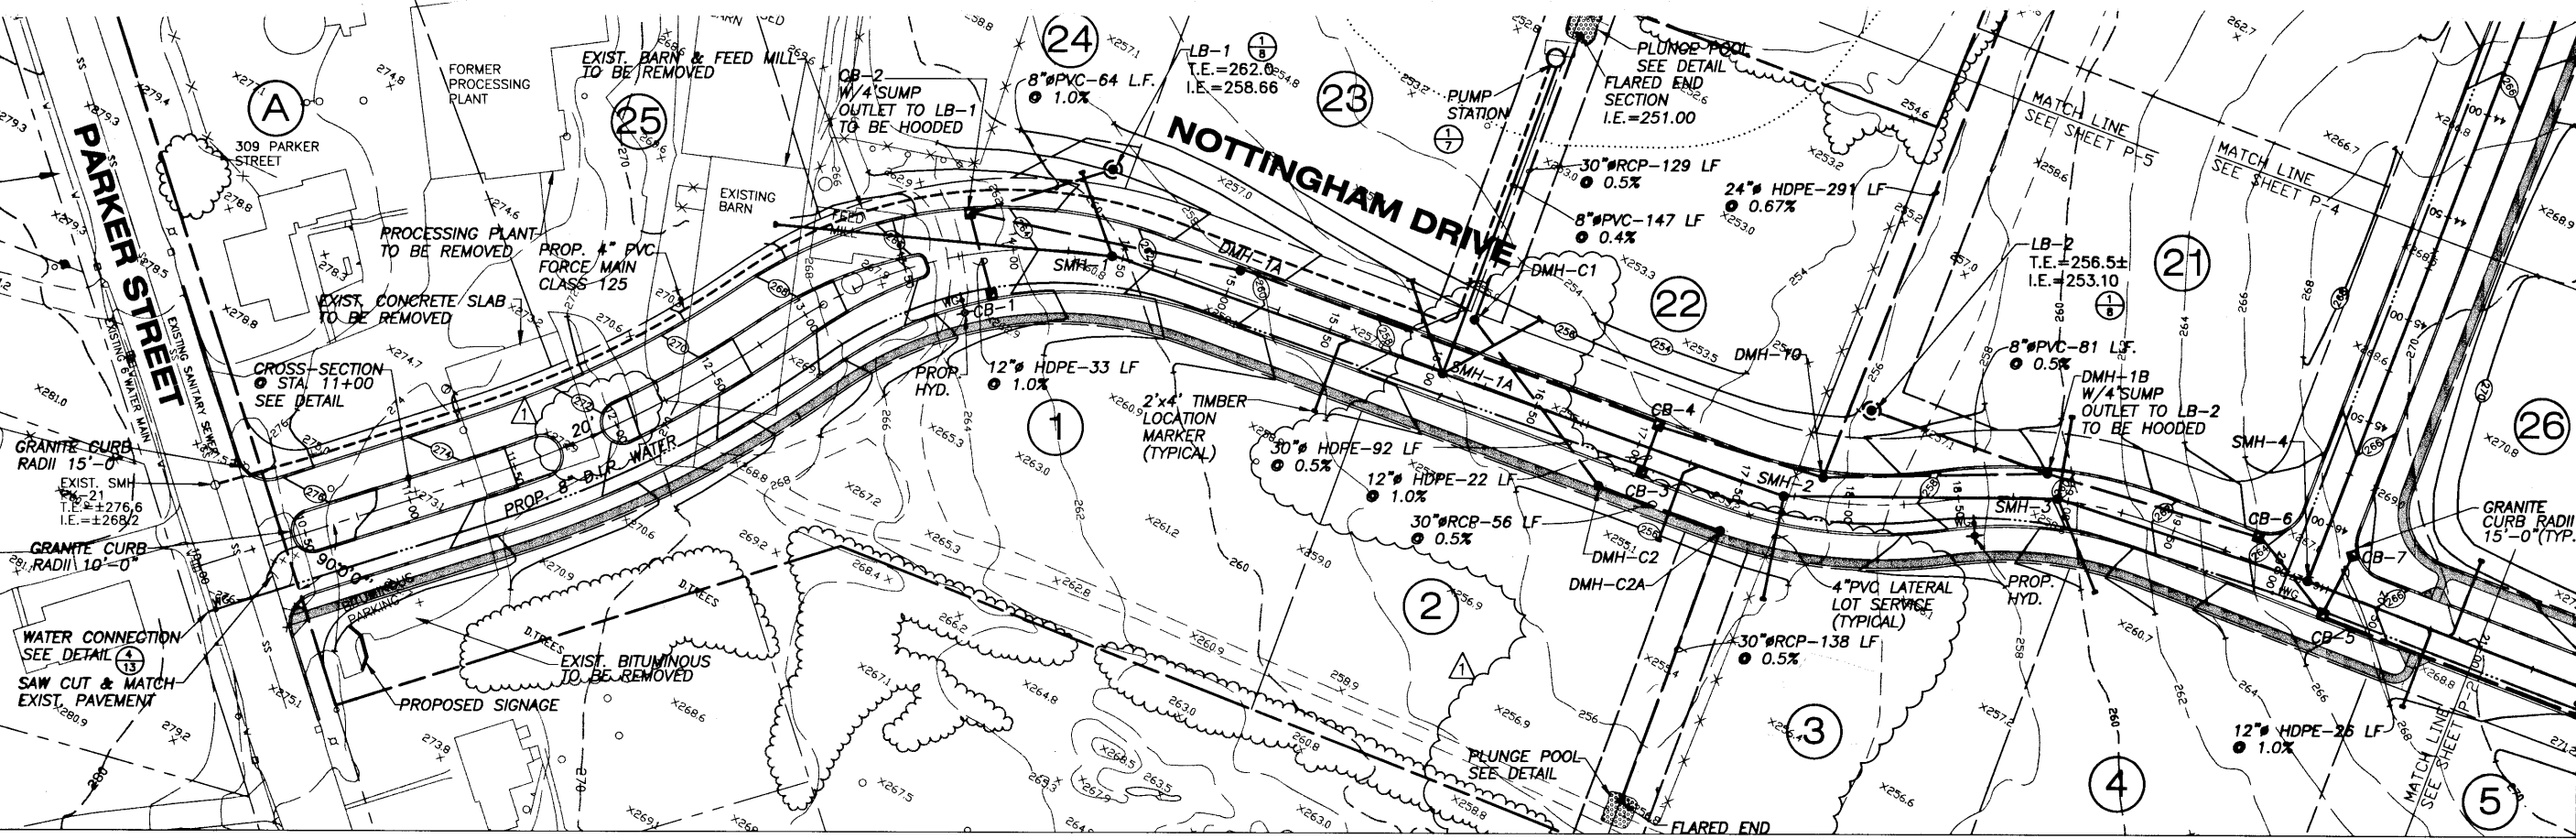

PLAN
1"=40'

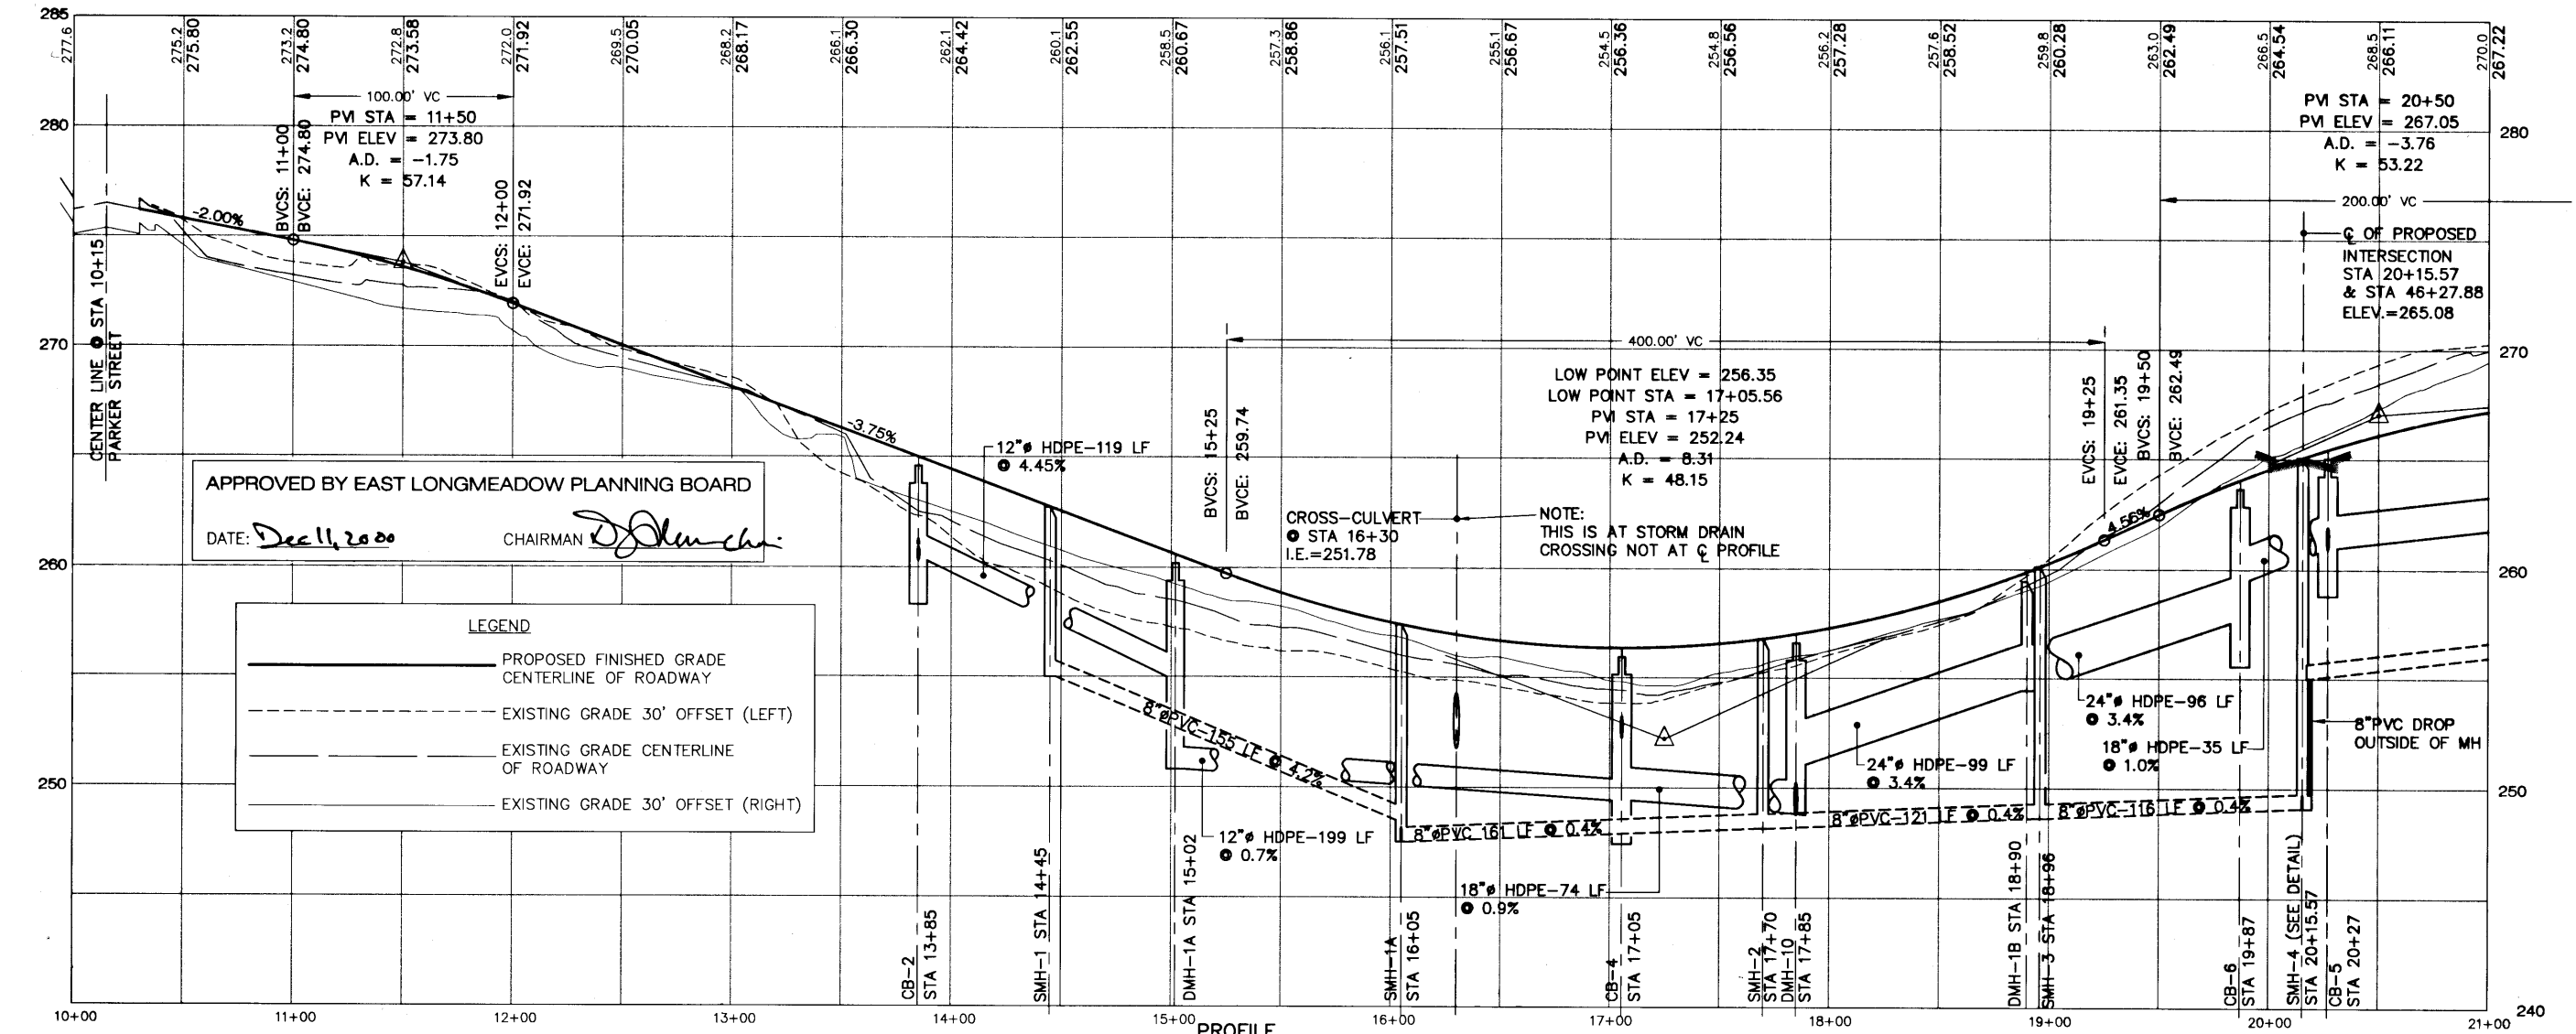

PROFILE
VERT. 1"=4' HOR. 1"=40'

APPROVED BY EAST LONGMEADOW PLANNING BOARD
DATE: Dec 11, 2000
CHAIRMAN: [Signature]