


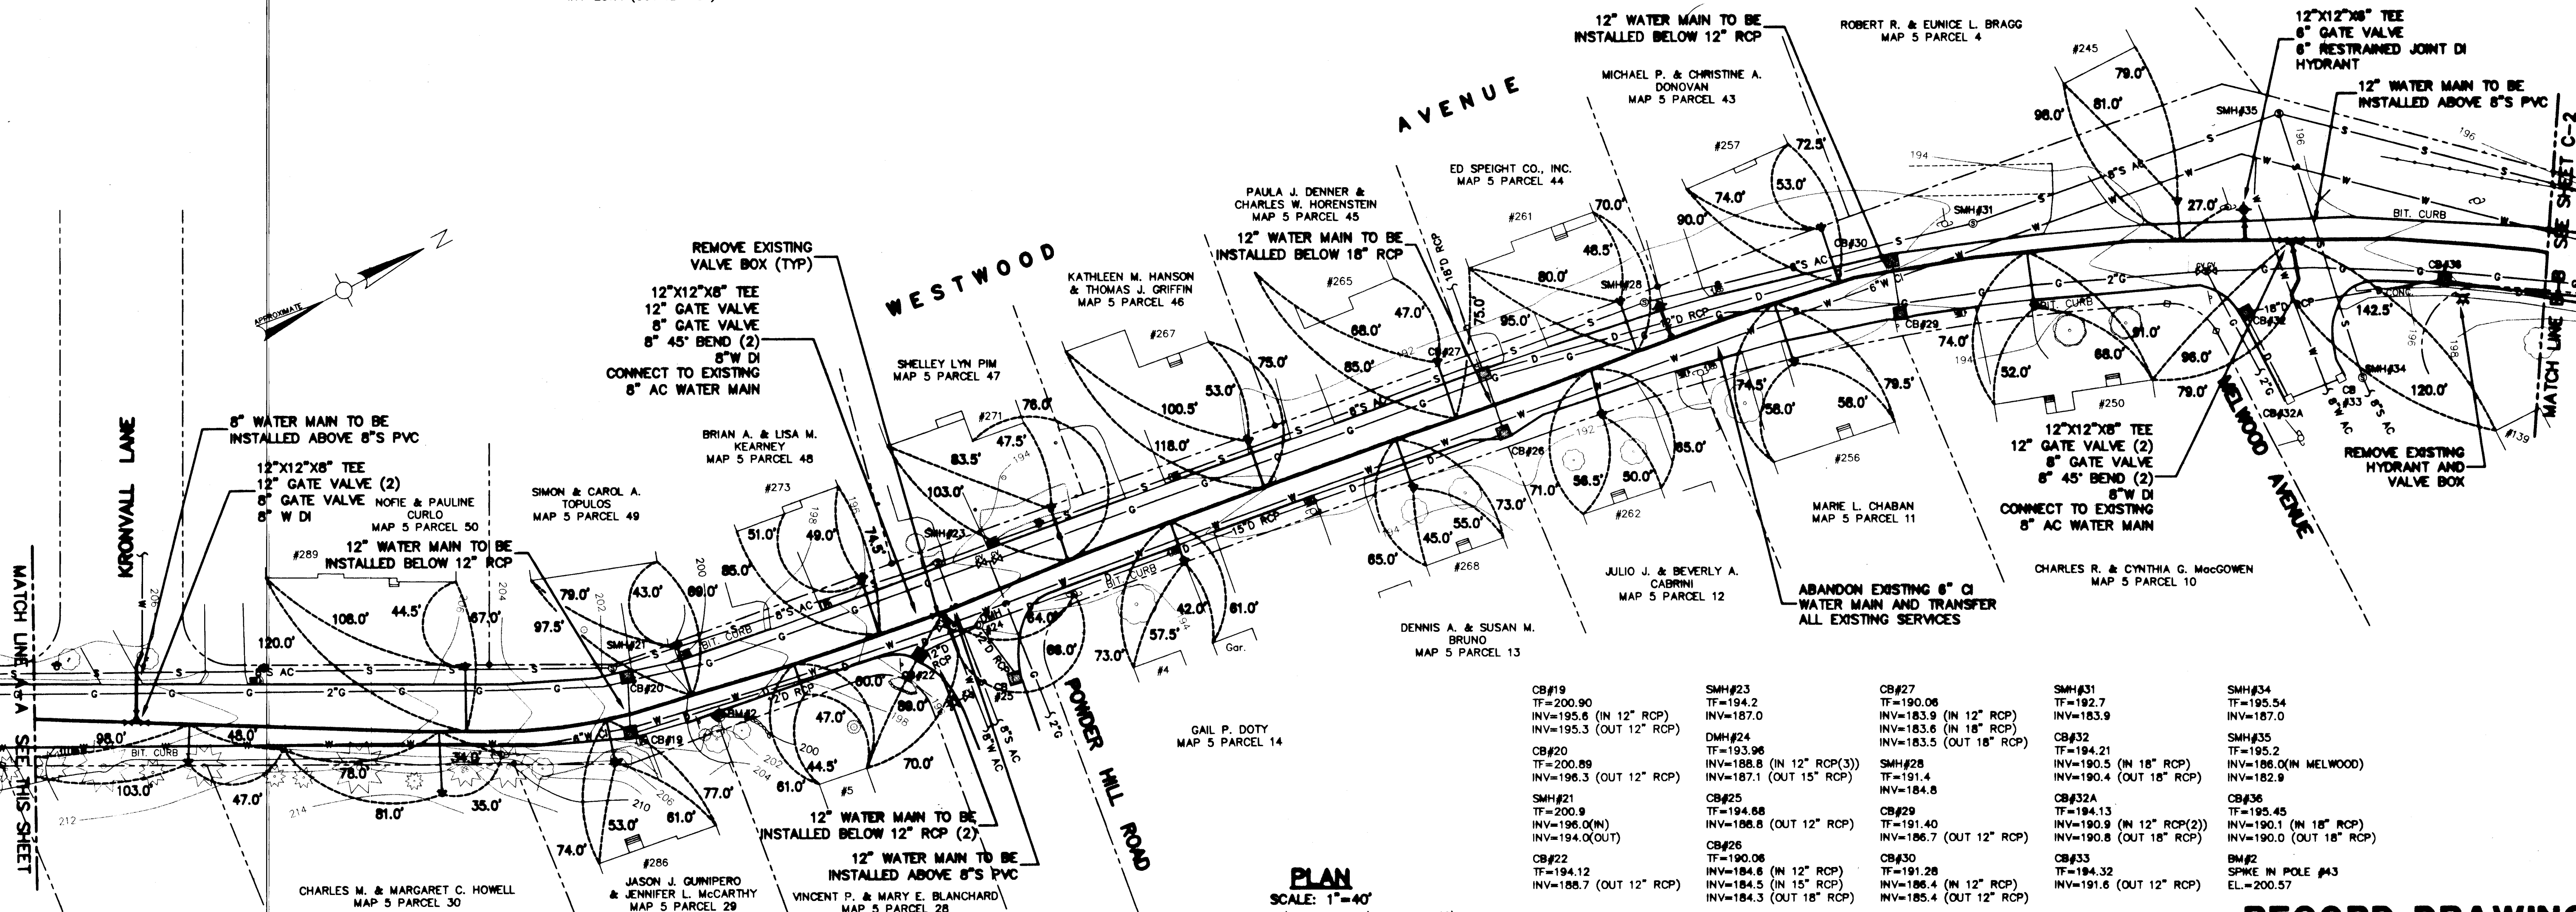

G-1

SHEET 3 OF