


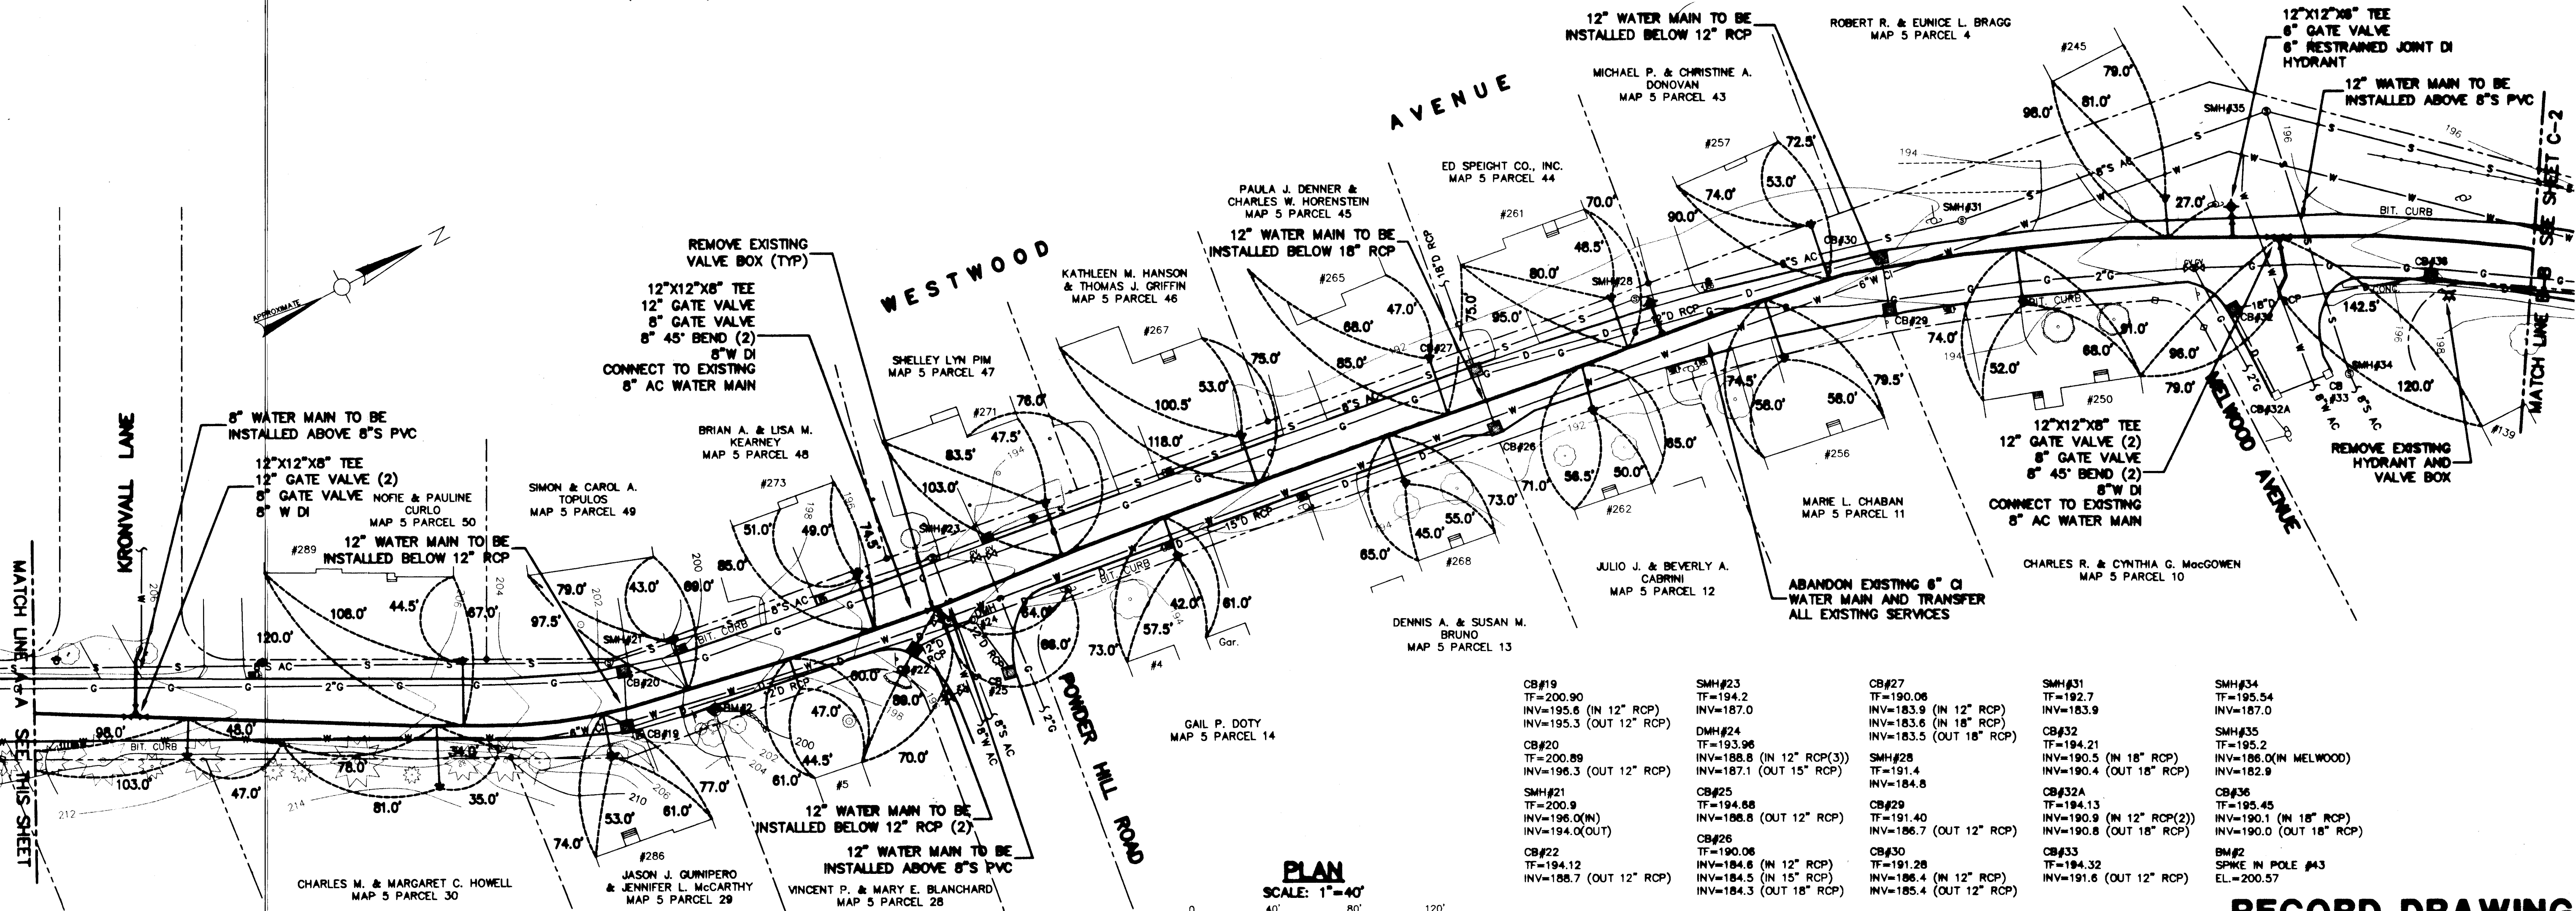

FILE NO. 133-45

C-1

SHEET 3 OF 6