
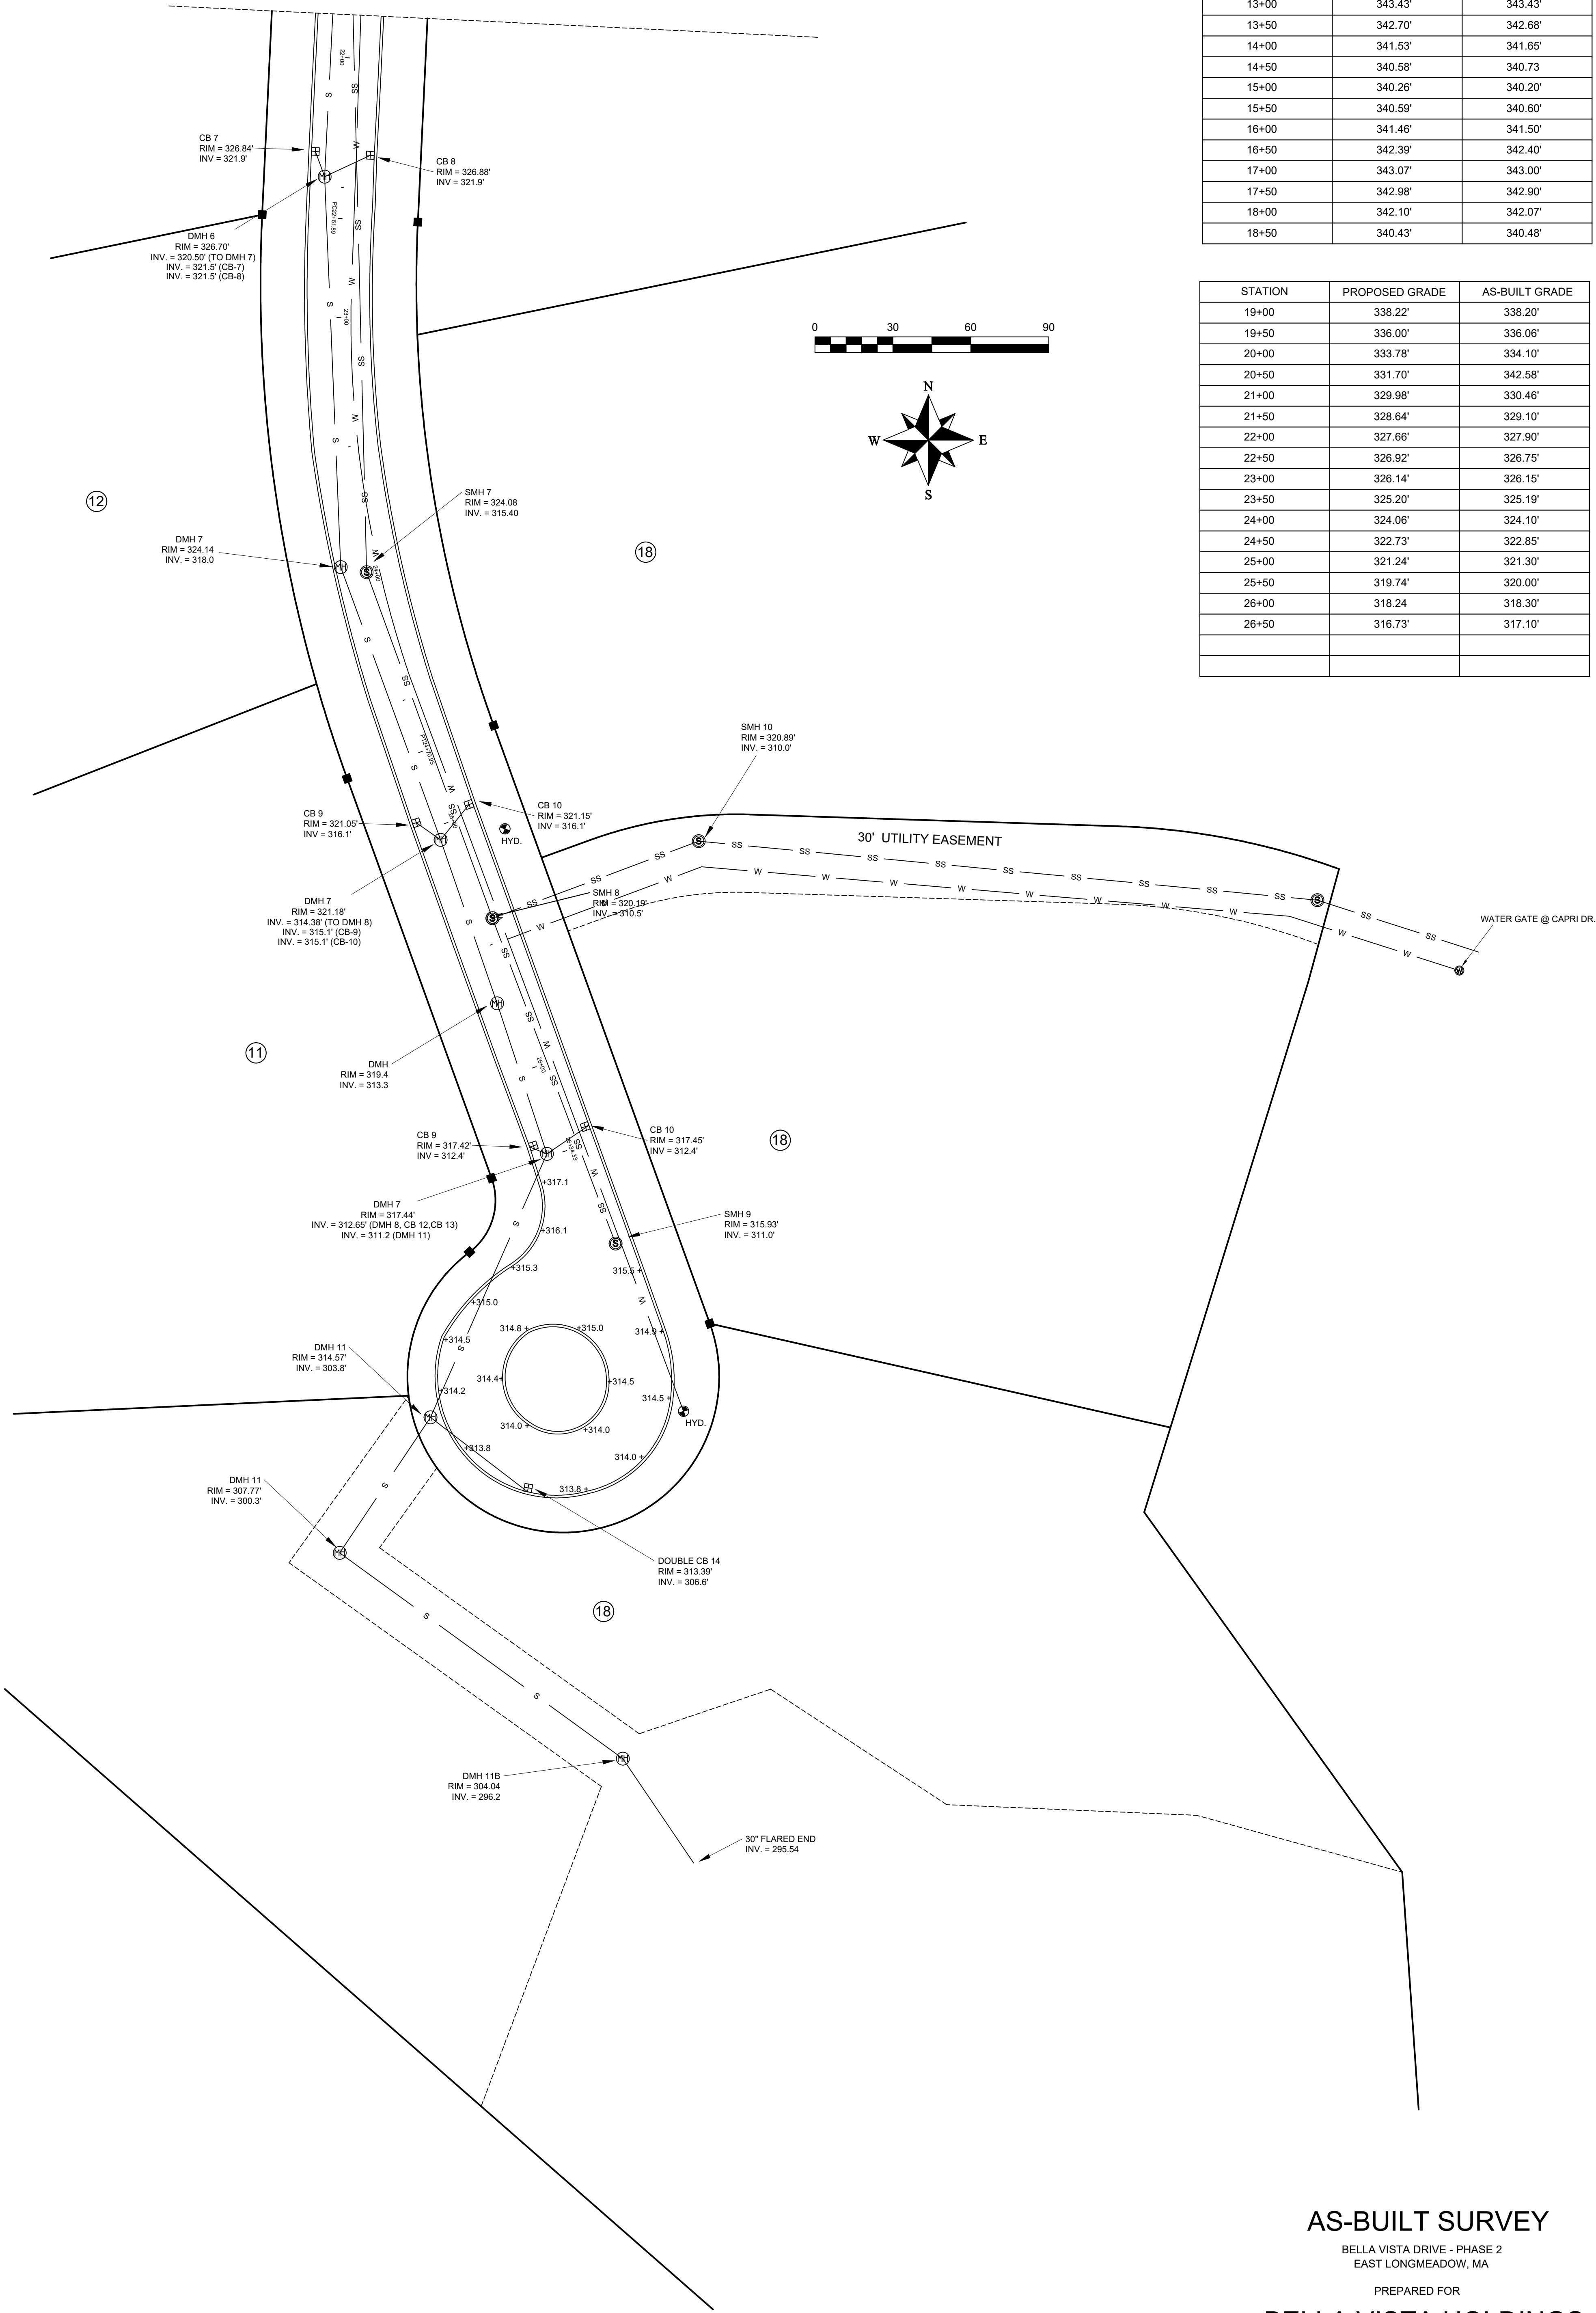
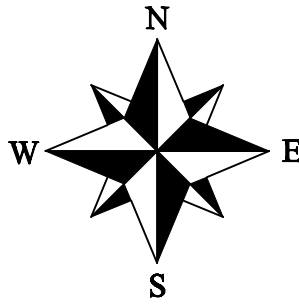


SS SS SS = SANITARY SEWER LINE
S S S = STORM SEWER LINE
W W W = WATER LINE

STATION	PROPOSED GRADE	AS-BUILT GRADE
10+00	340.38'	340.51'
10+50	341.14'	341.22'
11+00	341.90'	342.10'
11+50	342.66'	342.58'
12+00	343.36'	343.39'
12+50	343.65'	343.70'
13+00	343.43'	343.43'
13+50	342.70'	342.68'
14+00	341.53'	341.65'
14+50	340.58'	340.73'
15+00	340.26'	340.20'
15+50	340.59'	340.60'
16+00	341.46'	341.50'
16+50	342.39'	342.40'
17+00	343.07'	343.00'
17+50	342.98'	342.90'
18+00	342.10'	342.07'
18+50	340.43'	340.48'

STATION	PROPOSED GRADE	AS-BUILT GRADE
19+00	338.22'	338.20'
19+50	336.00'	336.06'
20+00	333.78'	334.10'
20+50	331.70'	342.58'
21+00	329.98'	330.46'
21+50	328.64'	329.10'
22+00	327.66'	327.90'
22+50	326.92'	326.75'
23+00	326.14'	326.15'
23+50	325.20'	325.19'
24+00	324.06'	324.10'
24+50	322.73'	322.85'
25+00	321.24'	321.30'
25+50	319.74'	320.00'
26+00	318.24'	318.30'
26+50	316.73'	317.10'

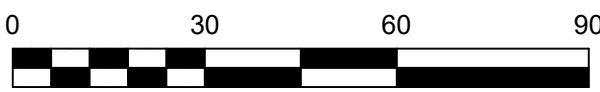

AS-BUILT SURVEY

BELLA VISTA DRIVE - PHASE 2
EAST LONGMEADOW, MA

PREPARED FOR

BELLA VISTA HOLDINGS
REALTY TRUST



DATE: 10/31/2023

SCALE: 1" = 30'

SMITH ASSOCIATES
SURVEYORS, INC.

46 B BALDWIN STREET - EAST LONGMEADOW, MA 01028 - P:(413) 525-8801 F: (413) 525-8841
SMITHASSOCIATESURVEYORS@HOTMAIL.COM WWW.SMITHASSOCIATESURVEYORS.COM