




EAST LONGMEADOW DEPARTMENT OF PUBLIC WORKS

Job: 26 EDMUND ST.

Sheet No: _____ of _____

Calculated By: RLE Date 8-12-15

Scale: WATER TIES

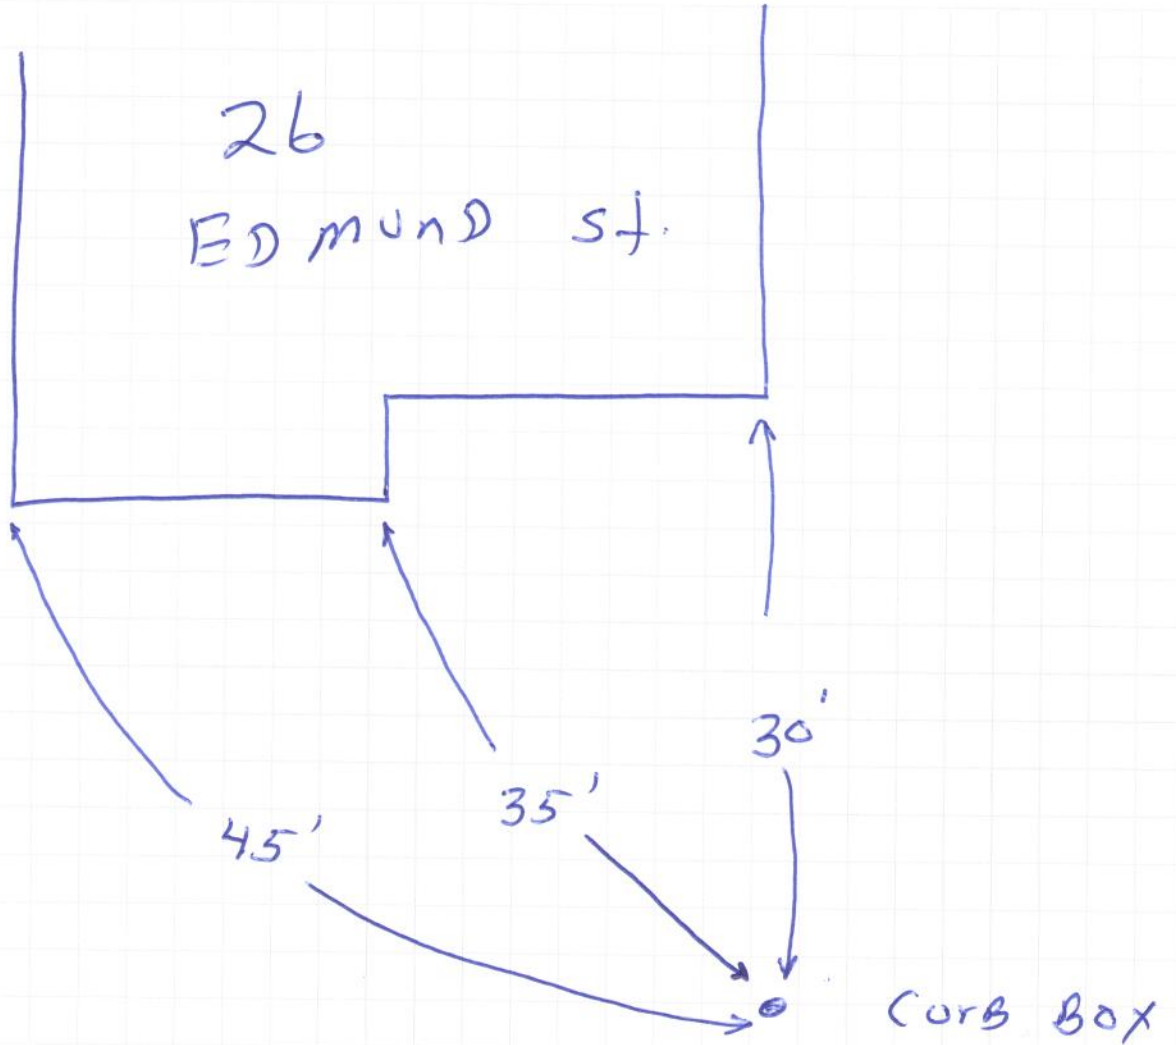

EDMUND STREET

8/19/15 Frank M.