


AS BUILT


WALL DETAILS		CONTRACT NO. 153403	
DEPT. OF PUBLIC WORKS		DATE 1/20/06	
EAST LONGMEADOW, MA		BY: CREG SCHROEDER - CIVIL	
2000 MC CET 97' DIA X 40' HR X 52' TWR		REVISIONS	
CONTRACT 3		DATE 2/25/06	
WALL DETAILS		REMARKS	
SUPPLIER'S / PURCHASER'S NO.		NEW REVISED PER CHANGE ORDER	

BY: *Greg Schroeder* DATE: 9/26/06
 CERTIFIED FOR CONFORMANCE TO PLANS & SPECIFICATIONS


ADDITIONAL REINFORCING BOTTOM OF WALL

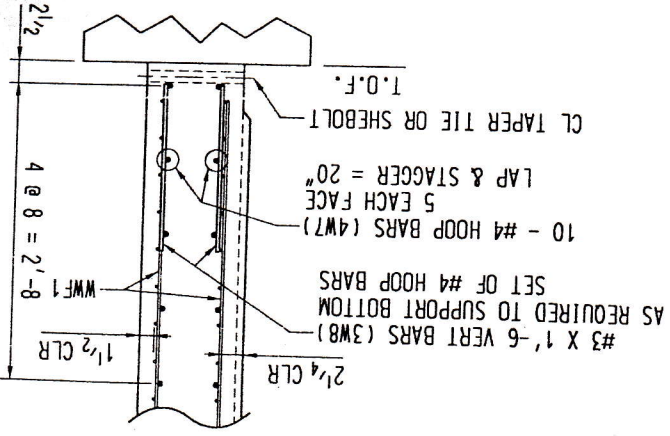


TYPICAL WALL REINFORCING

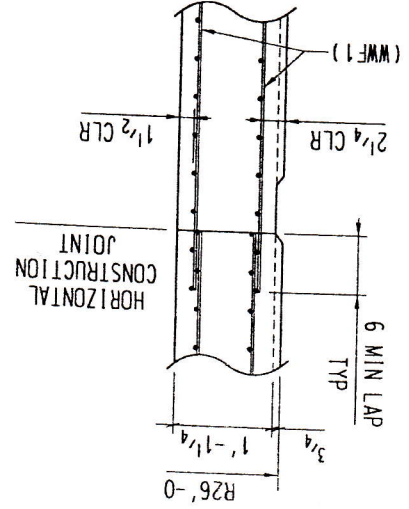

TYPICAL WALL REINFORCING

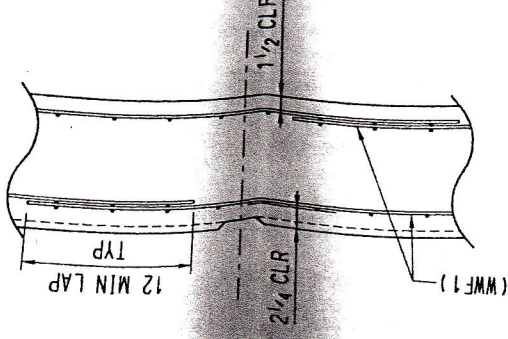

NOTE:
 4 X 4 - W5.5 X W4.0 (WFF1)
 W5.5 HORIZONTAL

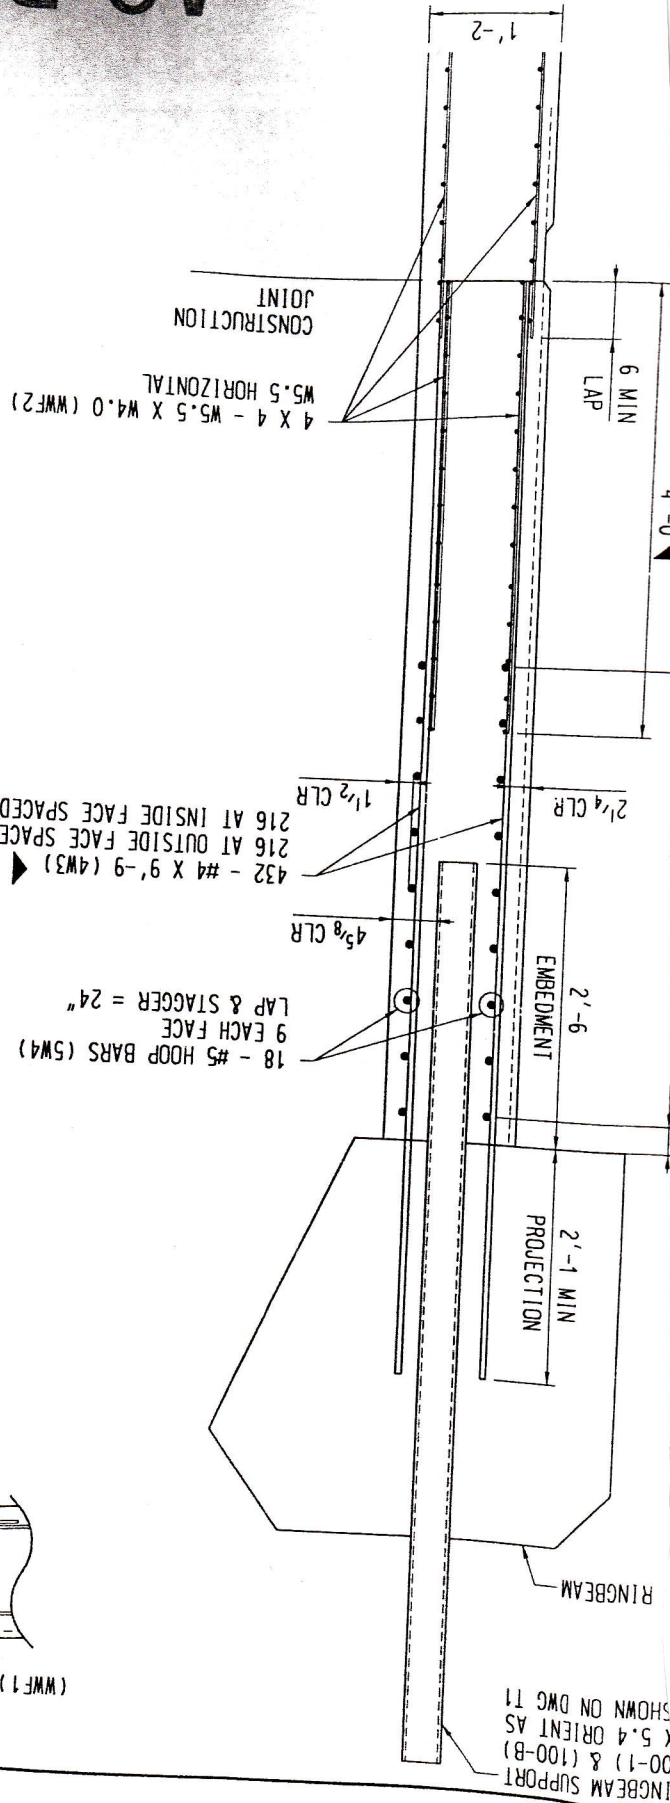

ING BEAM SUPPORT
 00-1) & (100-B)
 X 5.4 ORIENT AS
 SHOWN ON DWG T1