


N;

HERITAGE PARK @ N. MAIN

COUNCIL ON AGING

CENTER

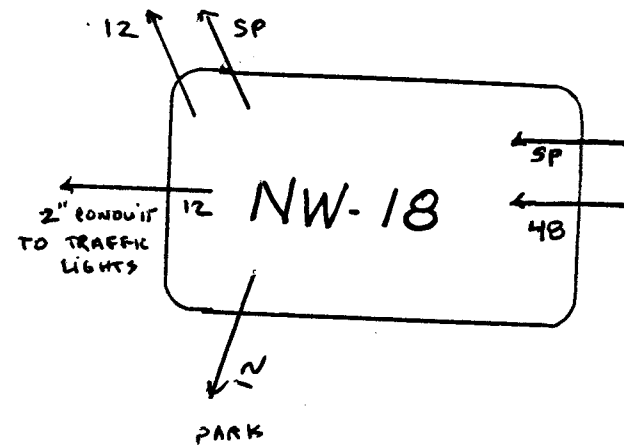

SPFLD