


Serving
The Northeast &
Midwest

Pipeline Specialists



Everett J. Prescott, Inc.

24 Hour
Emergency
Service

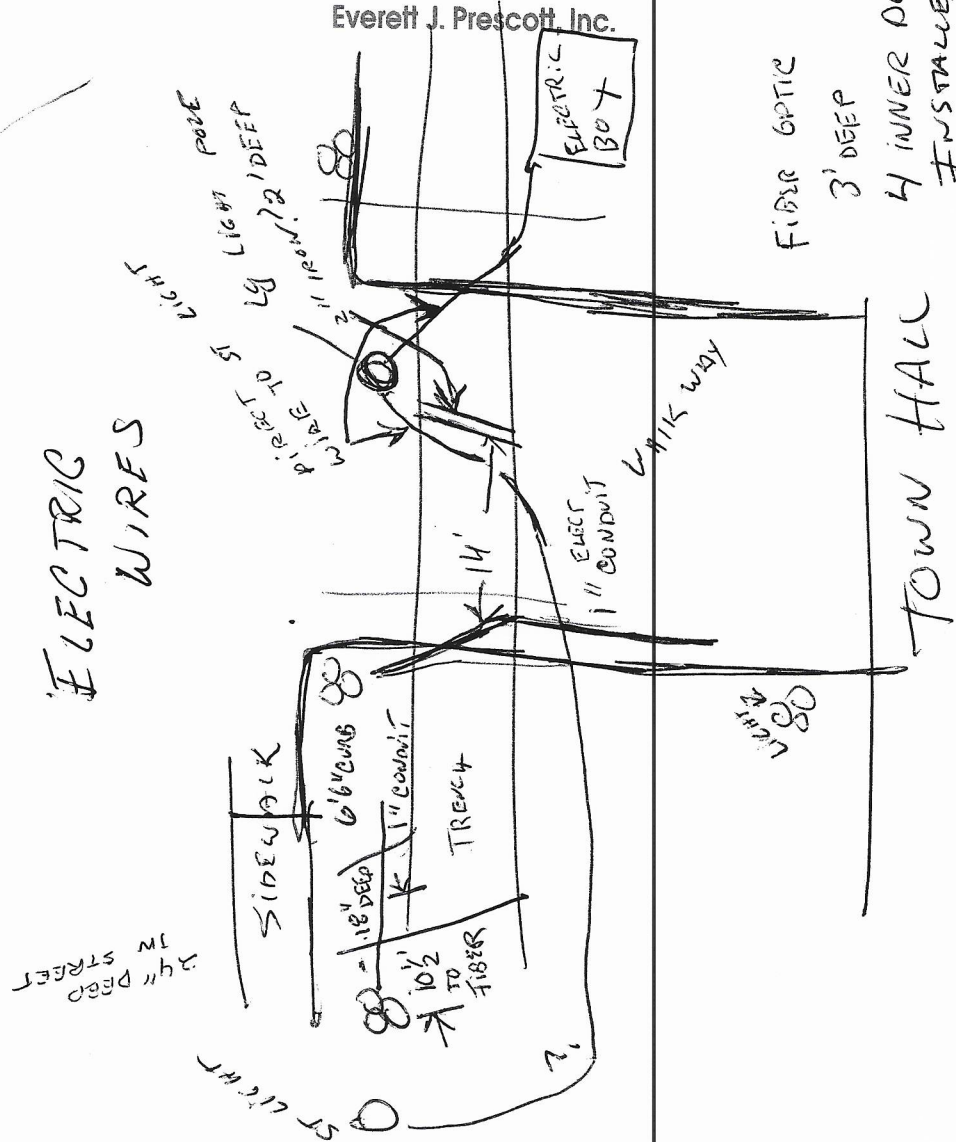

Water • Sewer • Drain • Gas

For your nearest EJP office call: 1-800-EJP-24HR

www.ejprescott.com

e-mail: ejp@ejprescott.com

Serving
The Northeast &
Midwest




24 Hour
Emergency
Service

Serving
The Northeast &
Midwest



24 Hour
Emergency
Service

Everett J. Prescott, Inc.

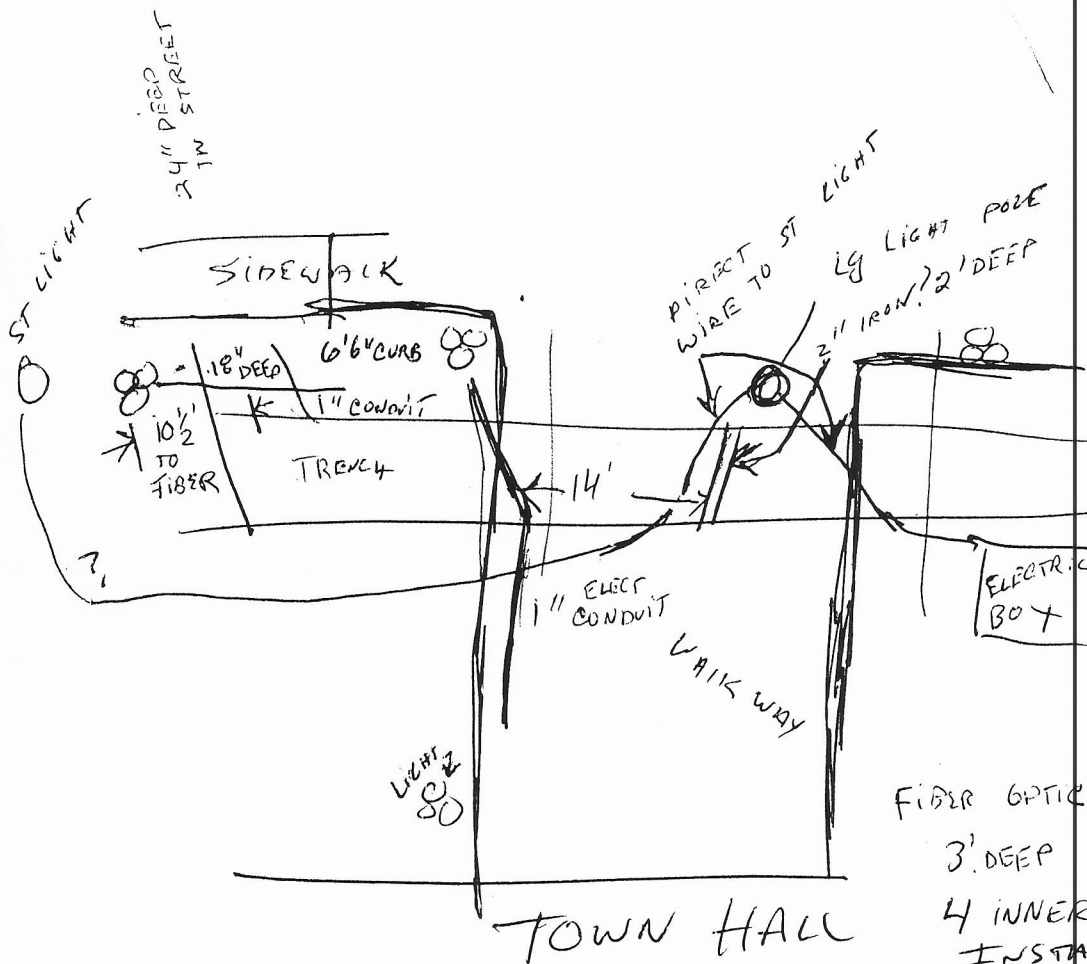

Todd
518 569 2589
100' NARROW ST. CROSSING

For your nearest EJP office call: 1-800-EJP-24HR

www.ejprescott.com

Water • Sewer • Drain • Gas

e-mail: ejp@ejprescott.com

For your nearest EJP office call: 1-800-EJP-24HR

www.ejprescott.com

Water • Sewer • Drain • Gas

e-mail: ejp@ejprescott.com

Serving
The Northeast &
Midwest

Pipeline Specialists

24 Hour
Emergency
Service



Everett J. Prescott, Inc.

TRACKS

705'

GREEN
BOX

170

PARADE
ST

4" CONDUIT

GREEN
BOX

118'

TOWN
HALL

9" THILS

SPICED
TOGETHER

218'

227?

INSTALLED

4" CONDUIT
4 ROWS

GREEN
BOX

SEE MAP
S

10' TO END
(4) 4" CONDUIT 24" DEEP

Water • Sewer • Drain • Gas

For your nearest EJP office call: 1-800-EJP-24HR


www.ejprescott.com

e-mail: ejp@ejprescott.com

PLEASANT ST

118
227
345

Streamline[®]
PRODUCTS

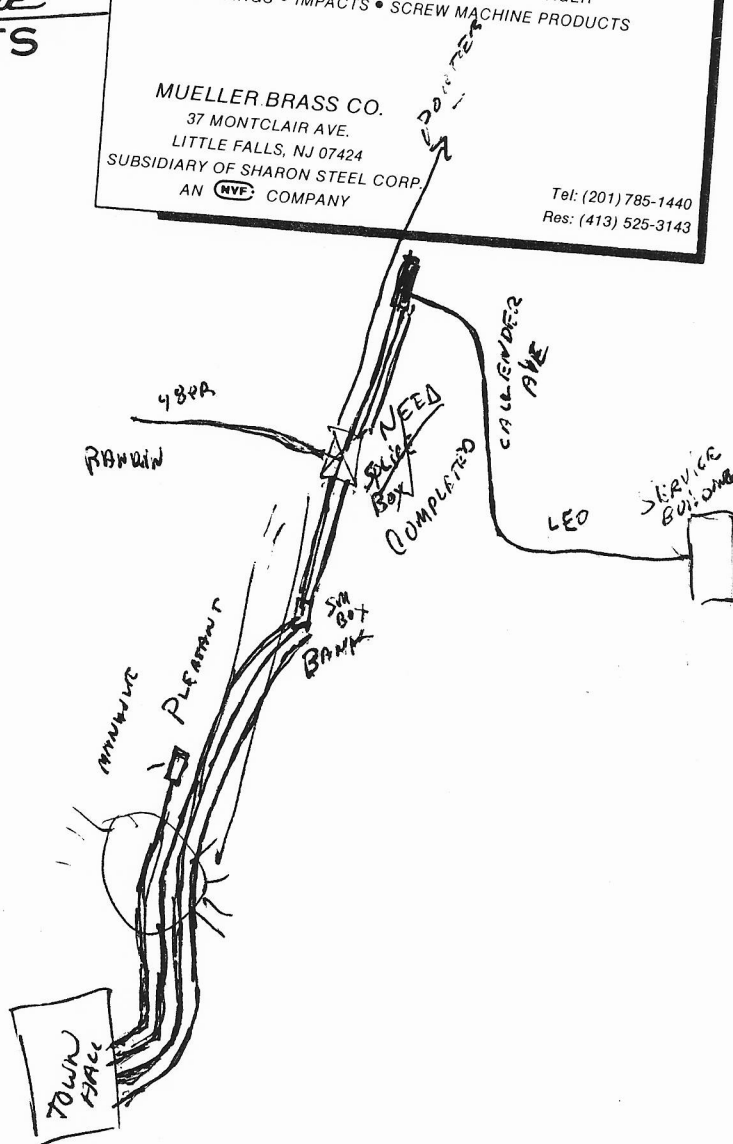

GAS CO. / GAS LEAK

781 9200 EX. 2304