


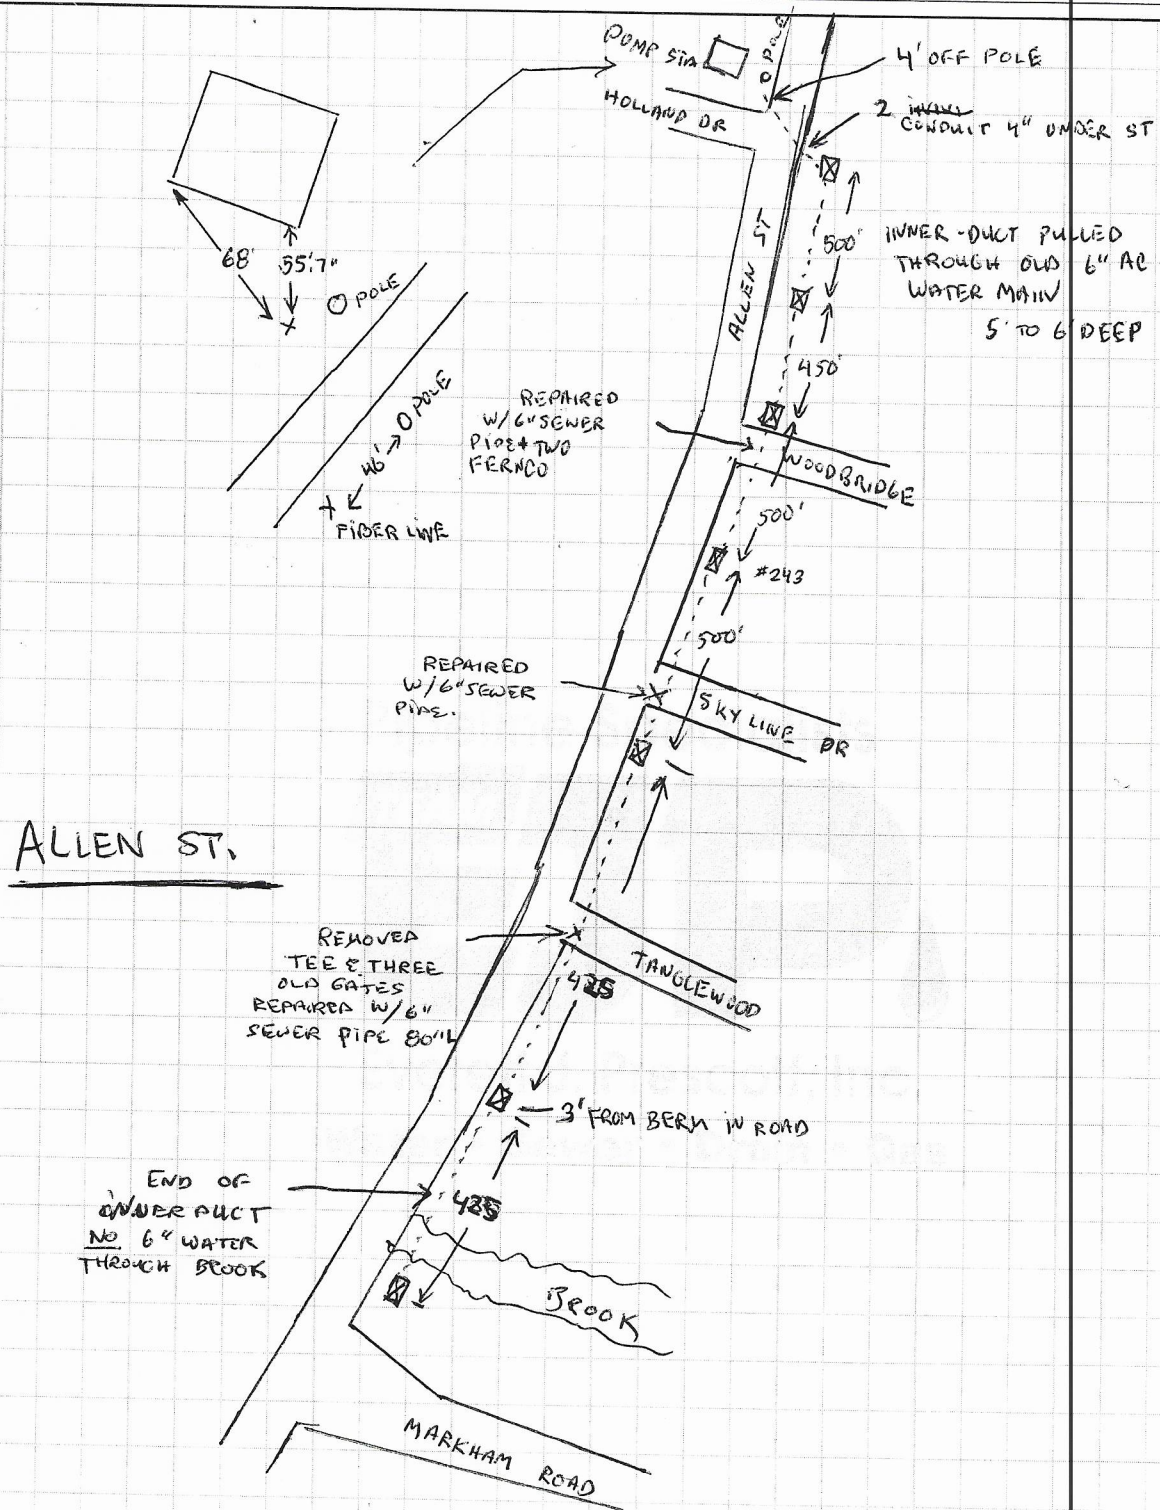


Serving
The Northeast &
Midwest

Pipeline Specialists



Everett J. Prescott, Inc.

24 Hour
Emergency
Service

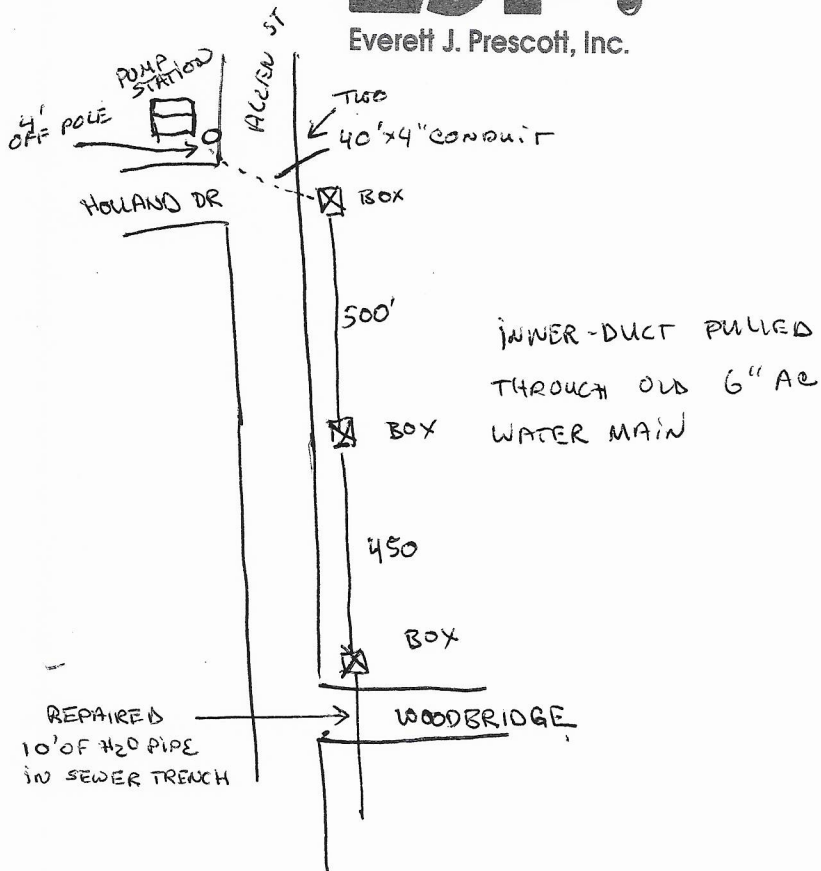

ALLEN ST.

HOLLAND TO WOODBRIDGE

Water • Sewer • Drain • Gas

For your nearest EJP office call: **1-800-EJP-24HR**

www.ejprescott.com

e-mail: ejp@ejprescott.com