


Serving
The Northeast &
Midwest

Pipeline Specialists
TEAM EJP
Everett J. Prescott, Inc.

24 Hour
Emergency
Service

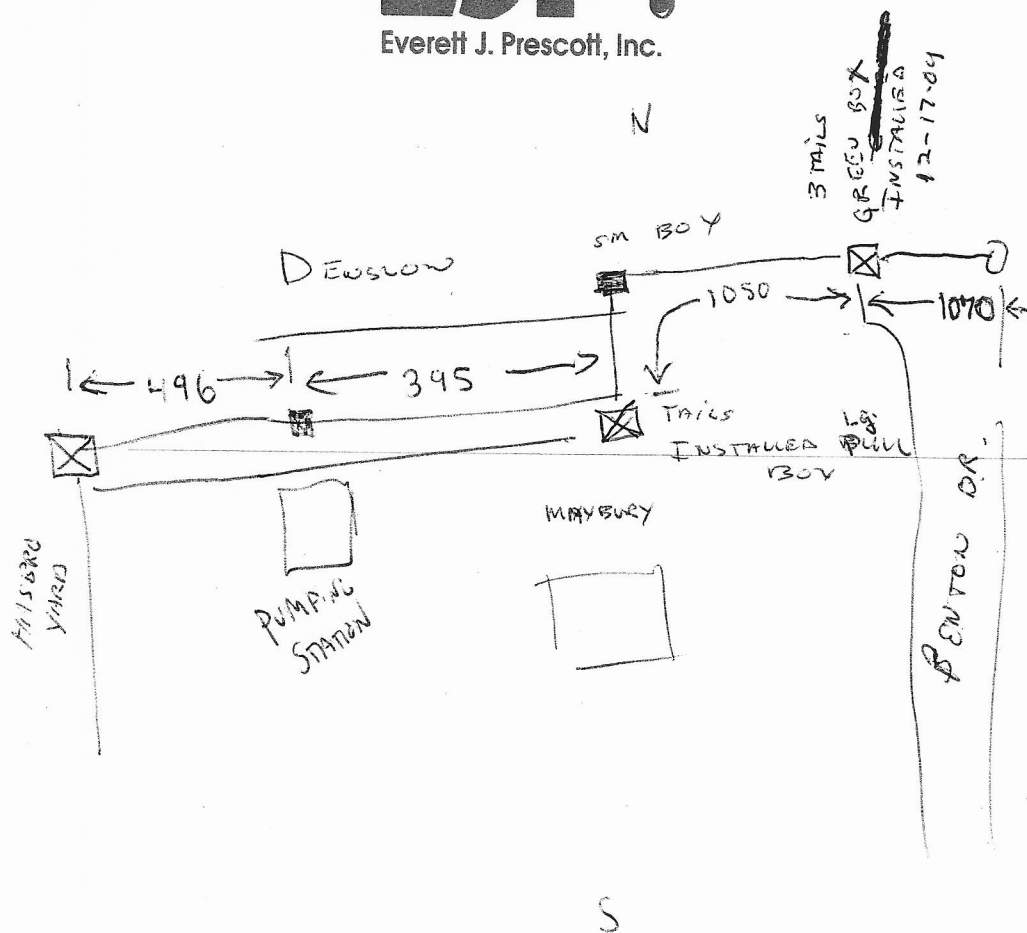

Water • Sewer • Drain • Gas

For your nearest EJP office call: **1-800-EJP-24HR**

www.ejprescott.com

e-mail: ejp@ejprescott.com




Vellano Bros., Inc.

877-VELLANO (835-5266) www.vellano.com

Your Single Source for Pipe, Equipment, and Supplies for
Underground Water, Sewer, and Drainage Systems

DENSLON ROAD PUMPING STATION

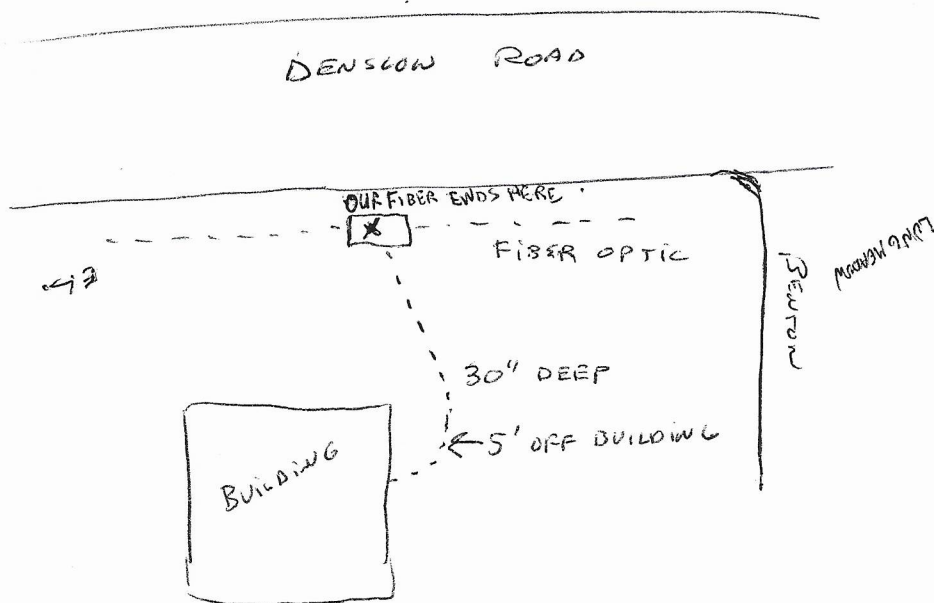



Water

Sewer

Municipal

Drainage

Streamline[®]
PRODUCTS

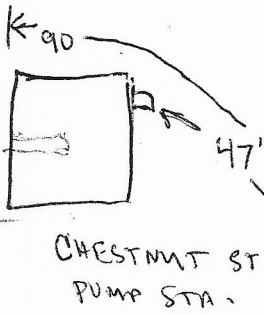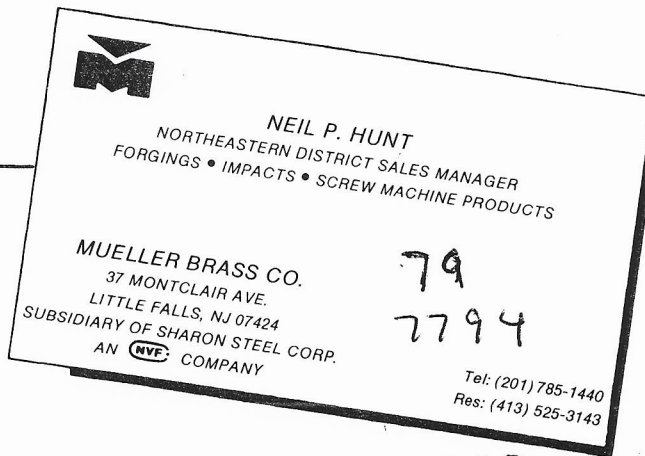

Completed
6-23-05
4" CONDUIT
AND INNER DUCT

7792
- 150

7642

