




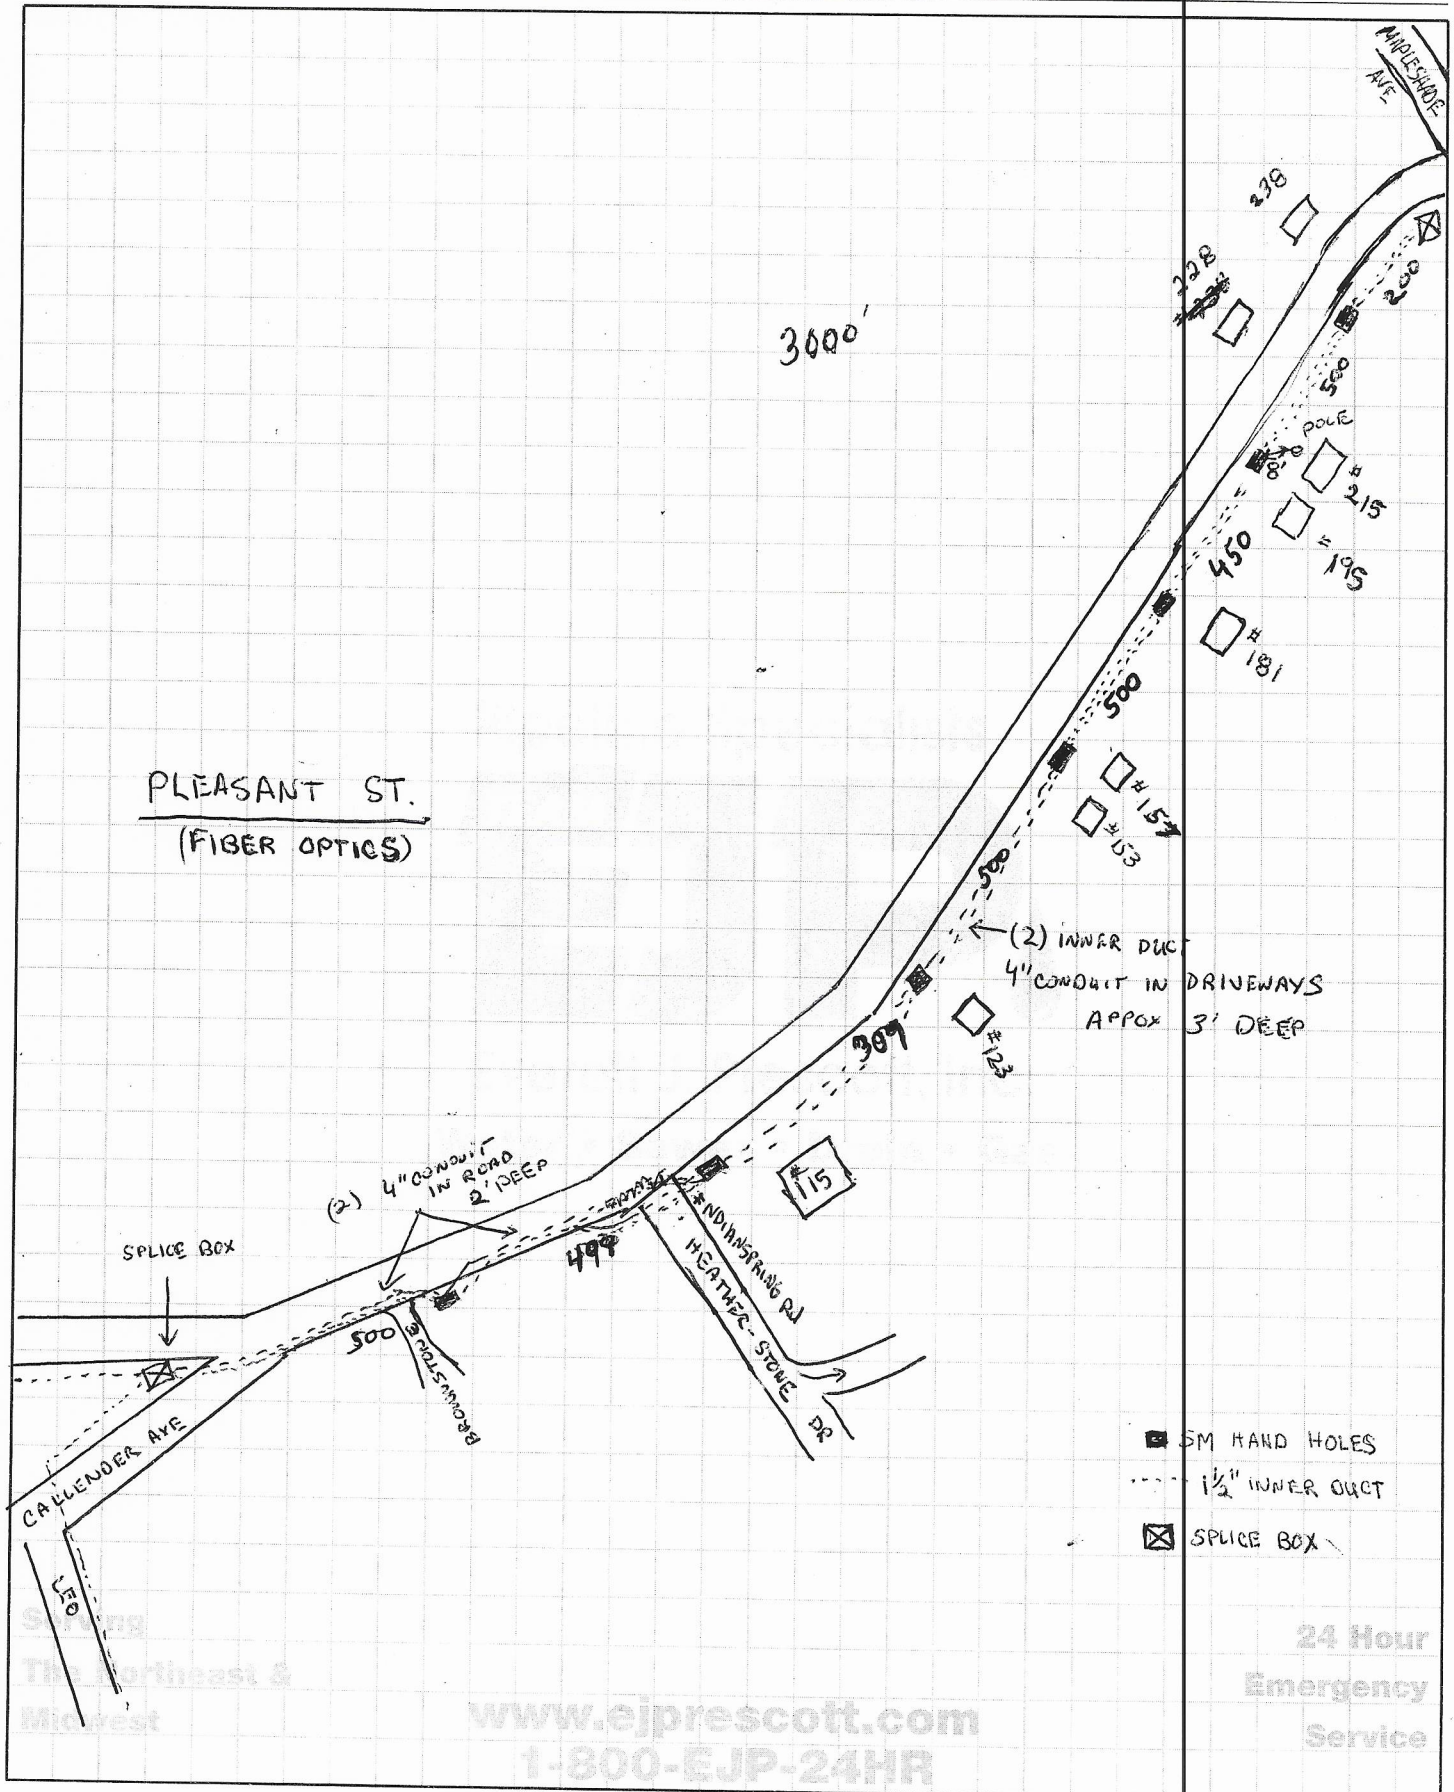


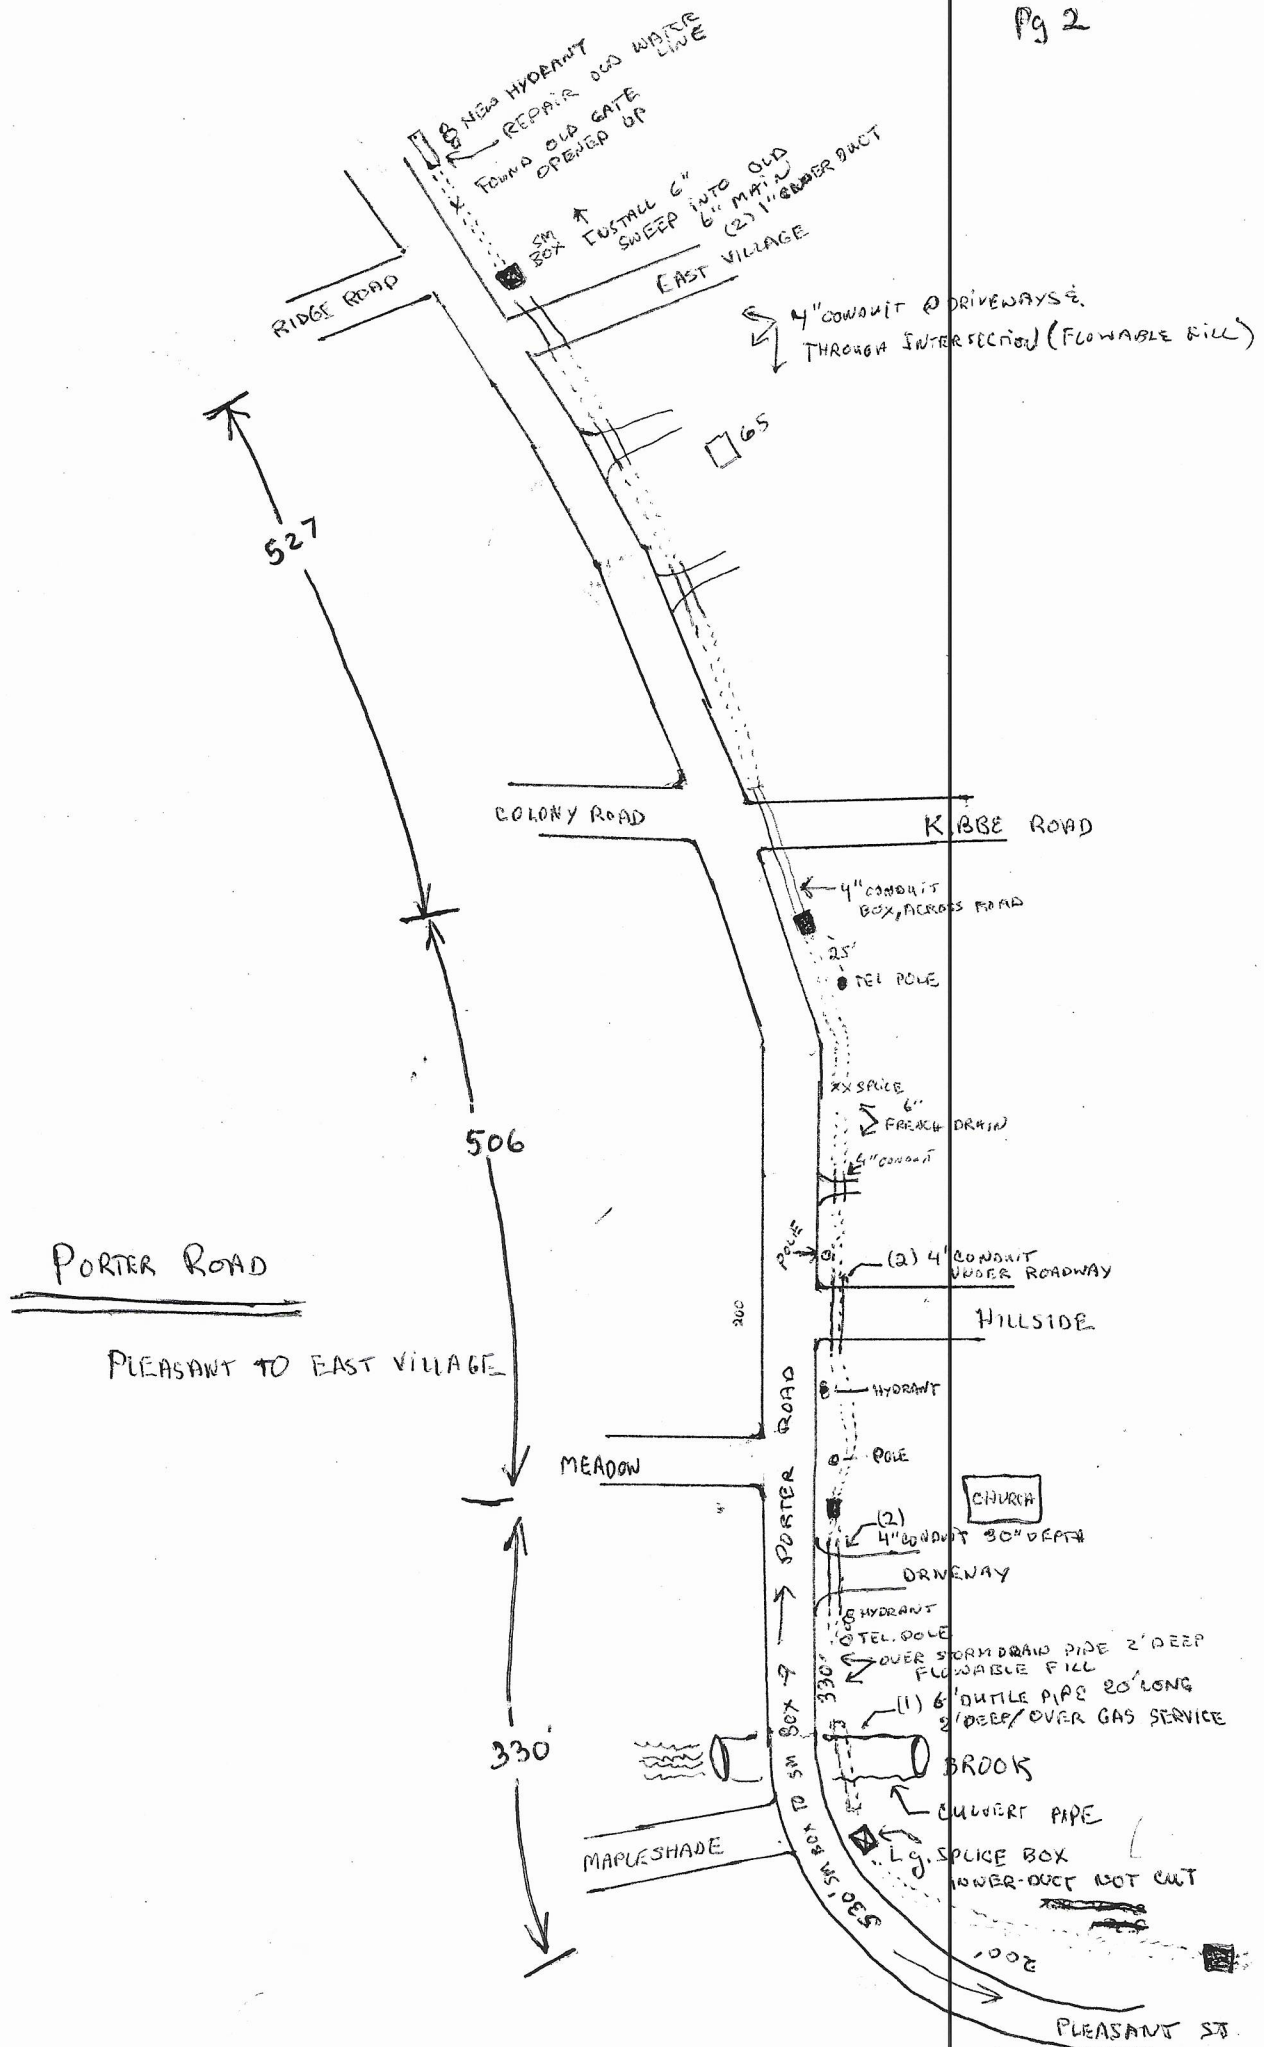


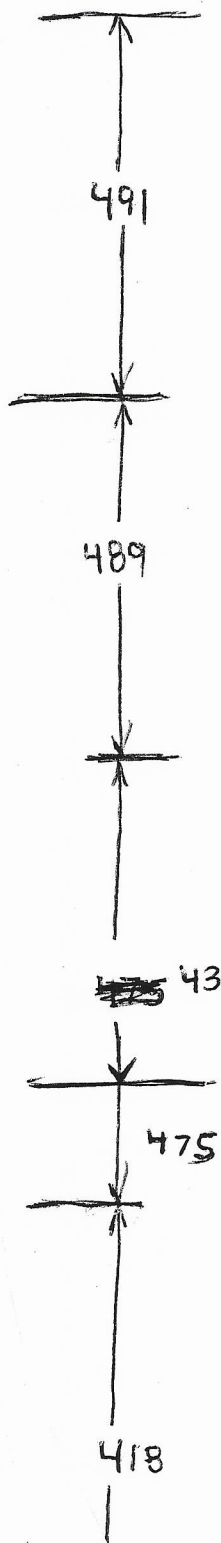

PORTER ROAD


EAST VILLAGE TO SENECA DR.

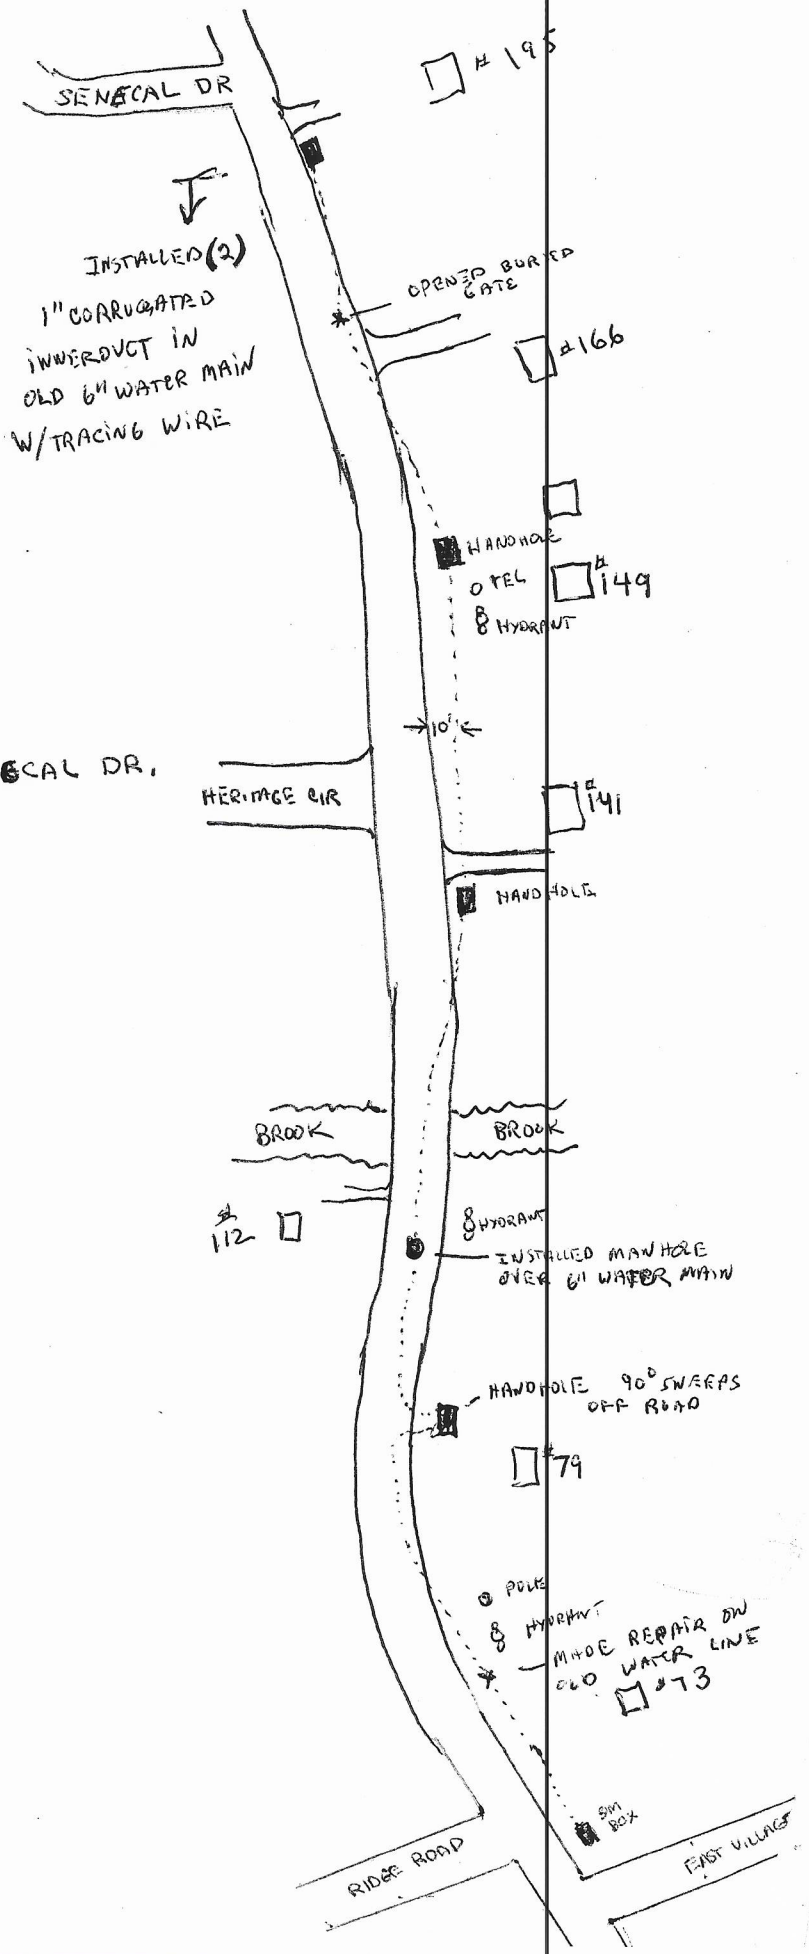


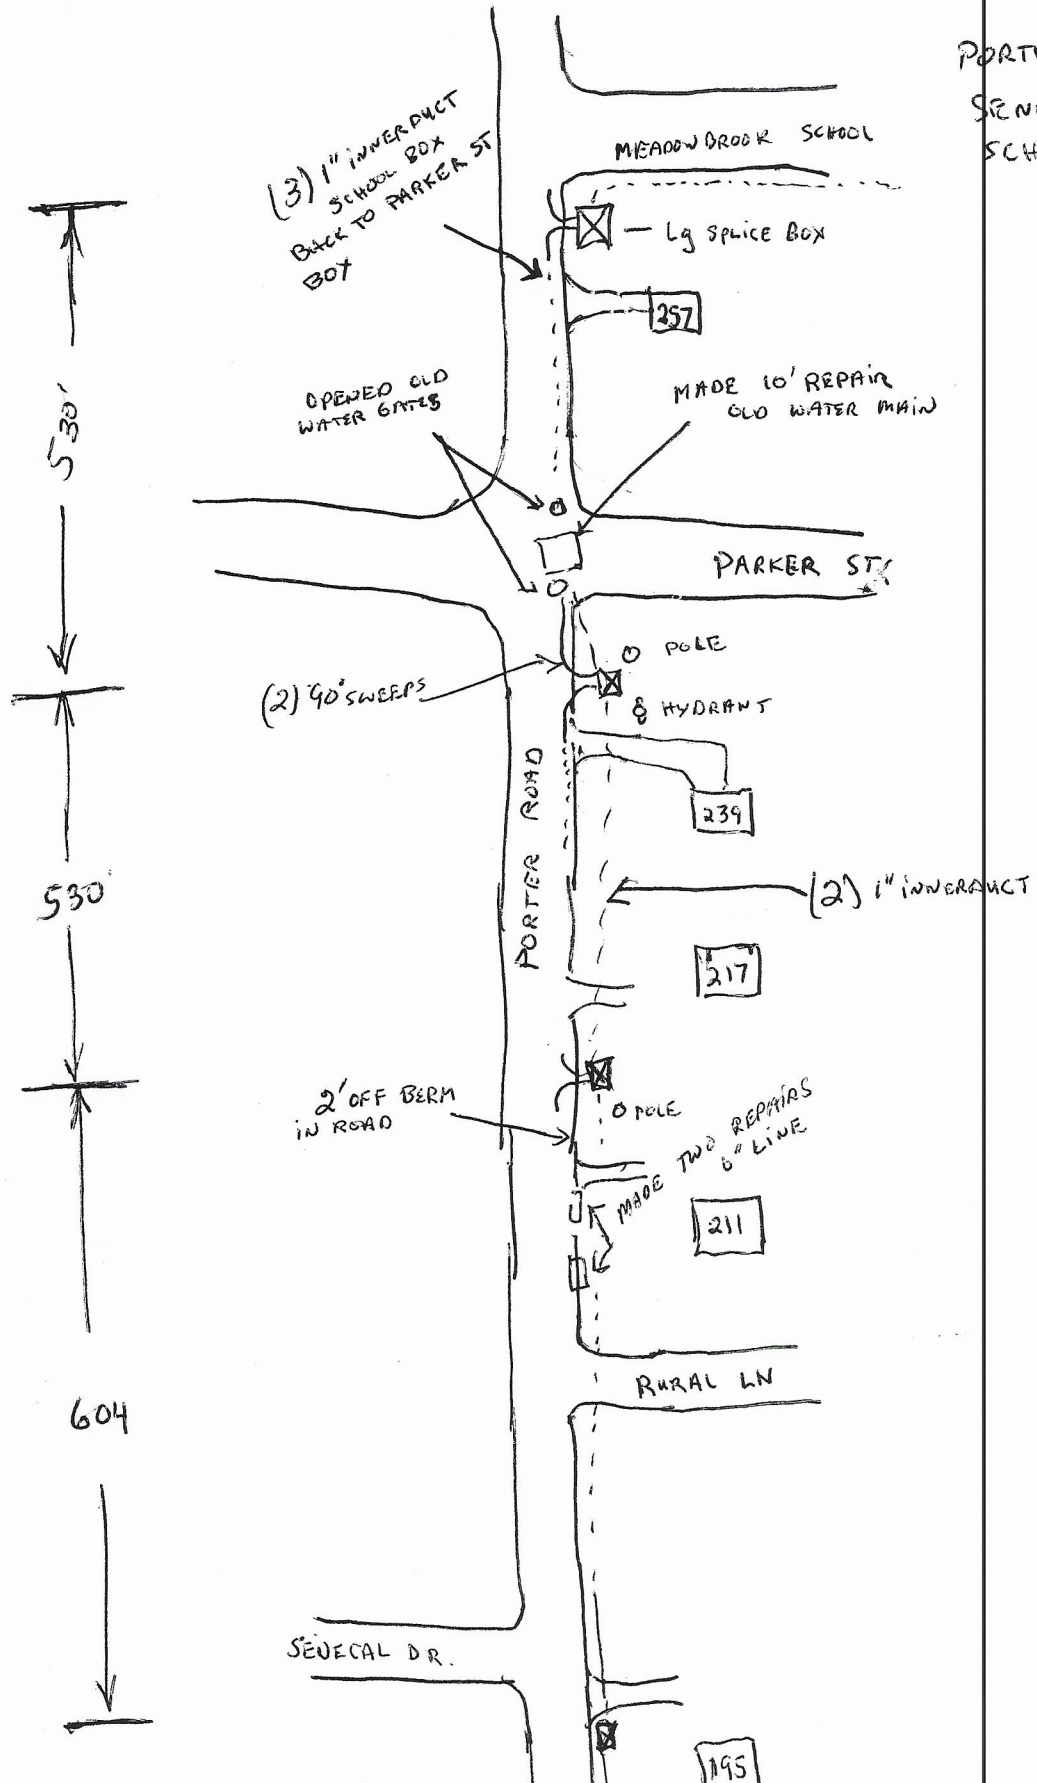

MEADOWSBROOK SCHOOL

Pg 5

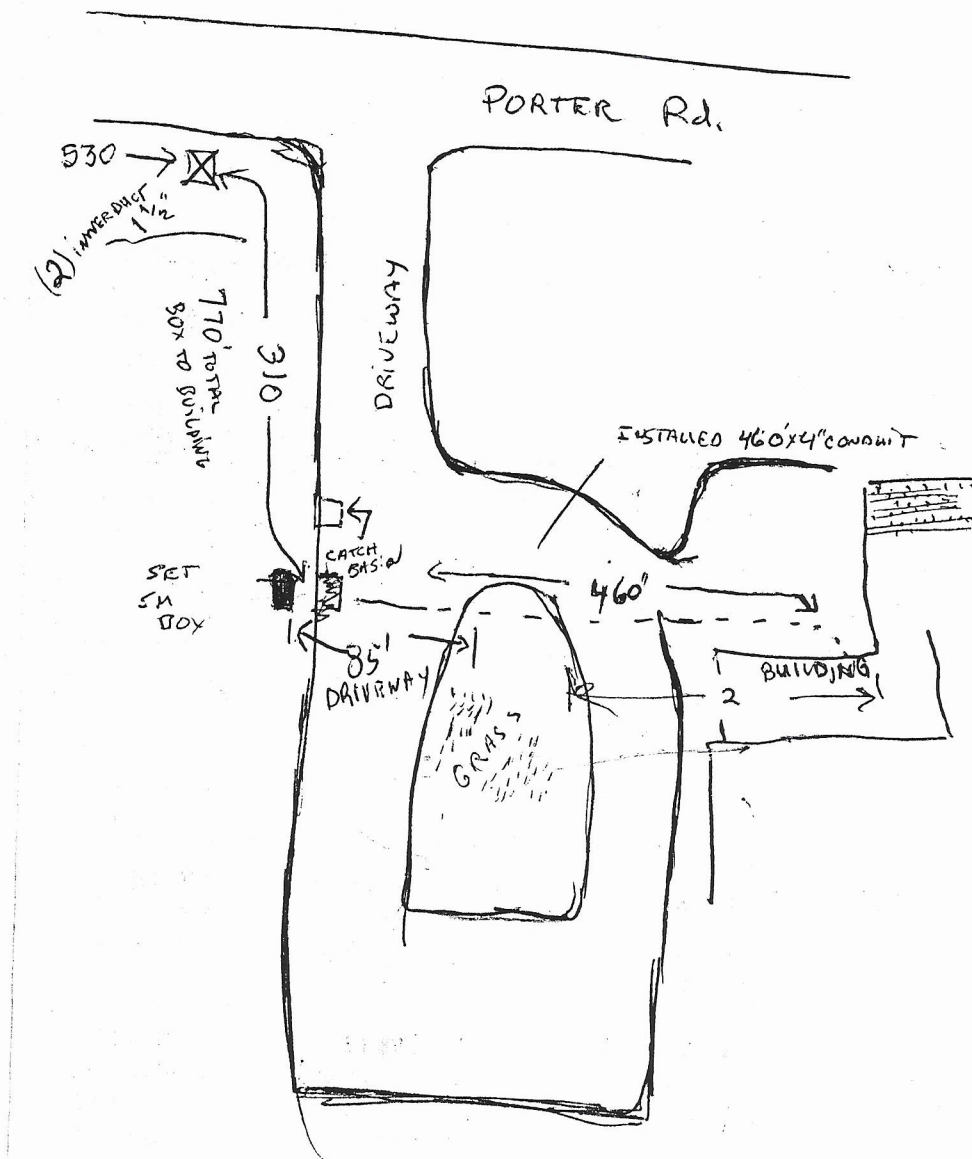

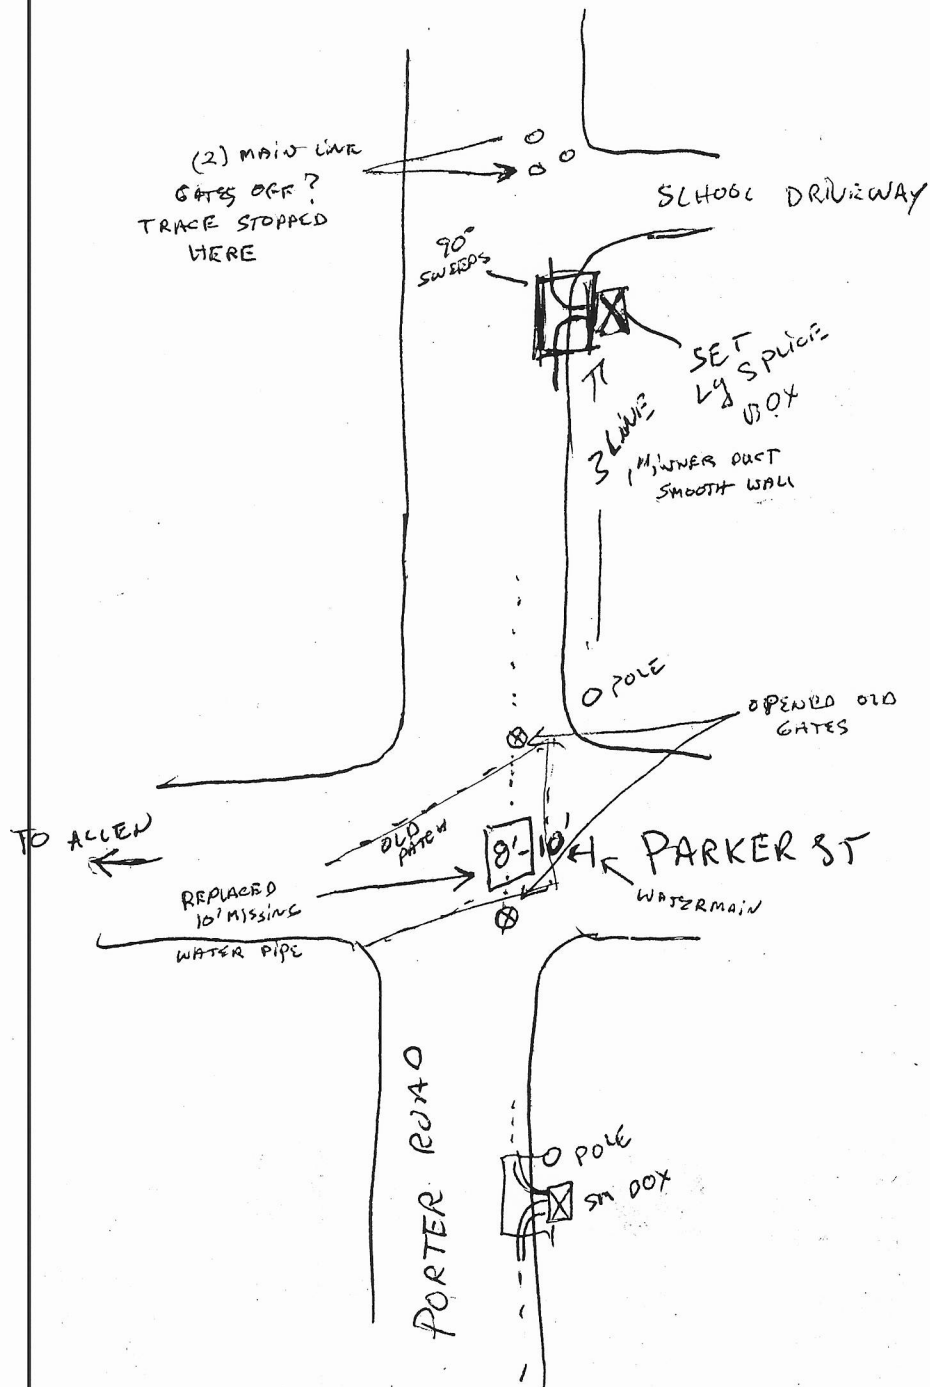



MOUNTAINVIEW
SCHOOL

HAMPDEN ST.