


Serving  
The Northeast &  
Midwest

Pipeline Specialists



Everett J. Prescott, Inc.

24 Hour  
Emergency  
Service

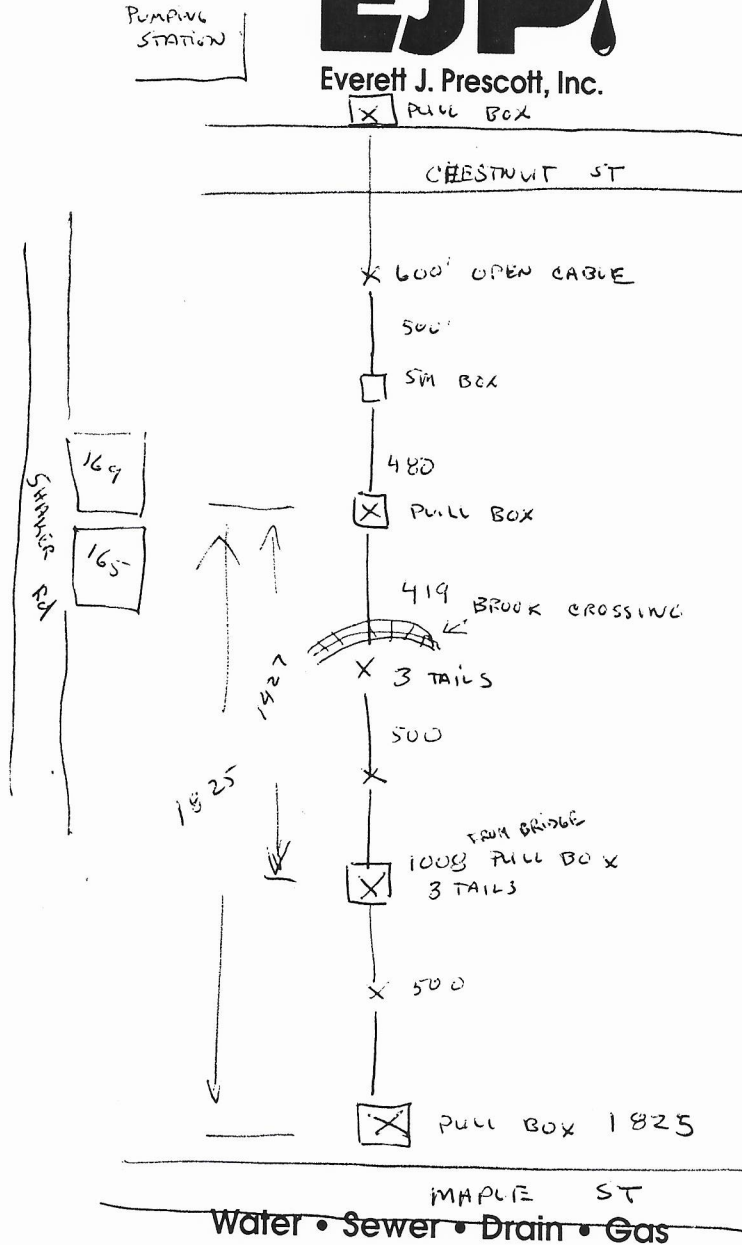

For your nearest EJP office call: **1-800-EJP-24HR**

[www.ejprescott.com](http://www.ejprescott.com)

e-mail: [ejp@ejprescott.com](mailto:ejp@ejprescott.com)

Serving  
The Northeast &  
Midwest

Pipeline Specialists  
**TEAM EJP**  
Everett J. Prescott, Inc.

24 Hour  
Emergency  
Service



Serving  
The Northeast &  
Midwest

Pipeline Specialists  
**TEAM EJP**  
Everett J. Prescott, Inc.

24 Hour  
Emergency  
Service

2480

1886 7072

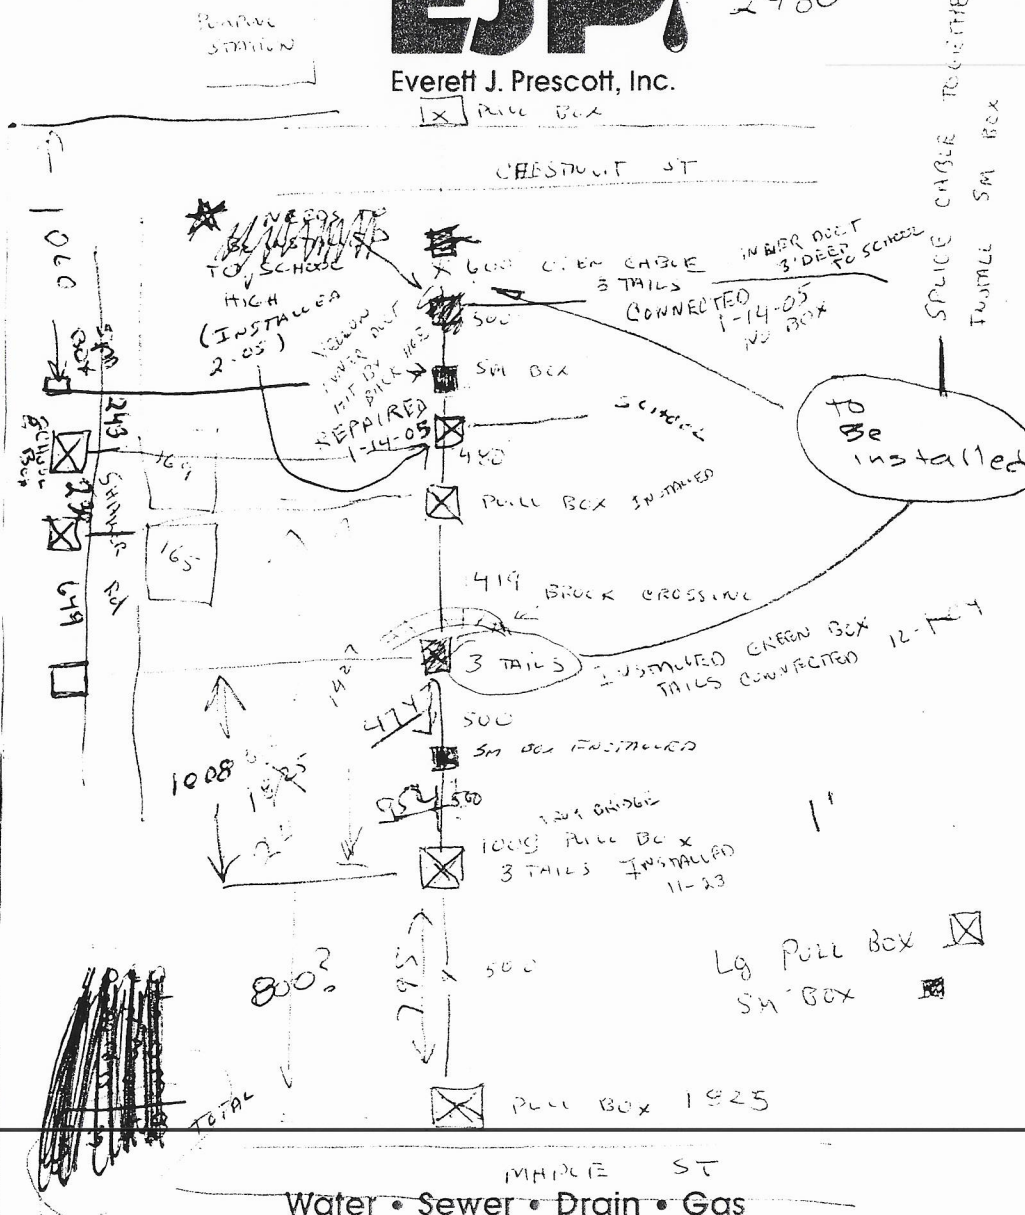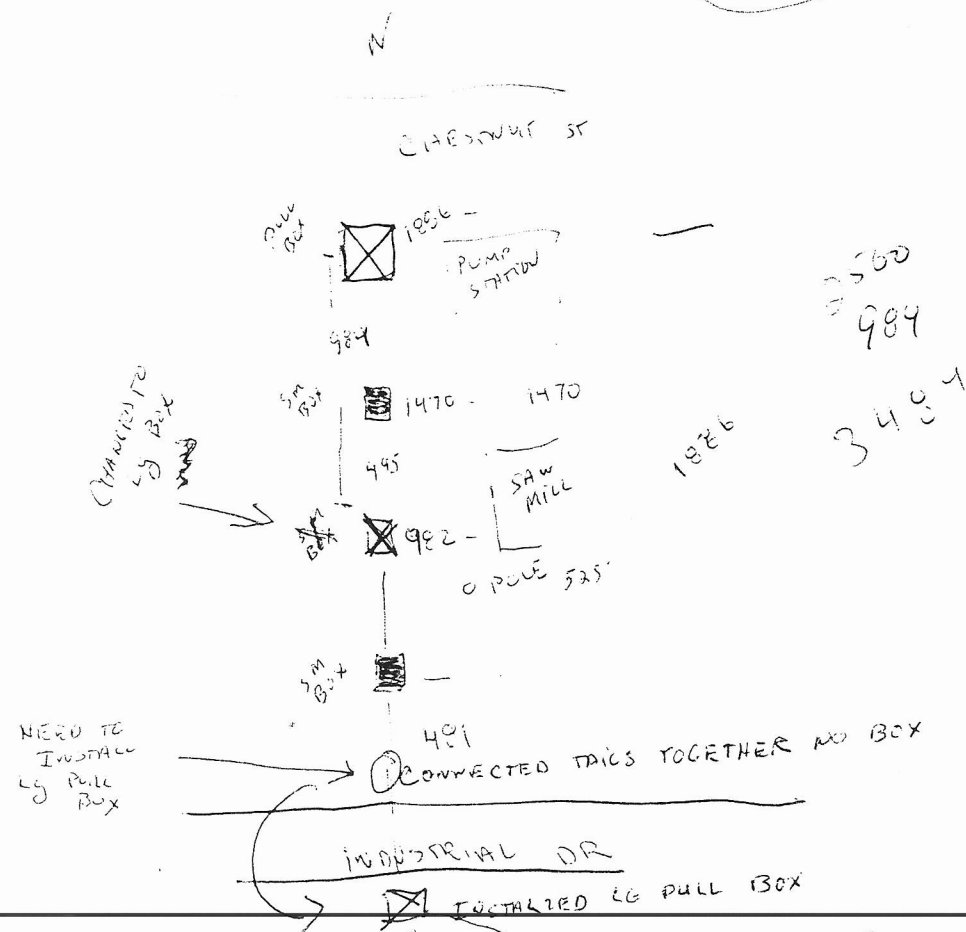

For your nearest EJP office call: 1-800-EJP-24HR

www.ejprescott.com  
BAIL RO BED  
e-mail: ejp@ejprescott.com

For your nearest EJP office call: 1-800-EJP-24HR

www.ejprescott.com  
e-mail: ejp@ejprescott.com

5244 INDUSTRIAL TO MAPLE



## Vellano Bros., Inc.

877-VELLANO (835-5266) [www.vellano.com](http://www.vellano.com)

Your Single Source for Pipe, Equipment, and Supplies for  
Underground Water, Sewer, and Drainage Systems

