


Serving
The Northeast &
Midwest

Pipeline Specialists
TEAM EJP
Everett J. Prescott, Inc.

24 Hou.
Emergency
Service

TRANSFER STATION CAMERA!

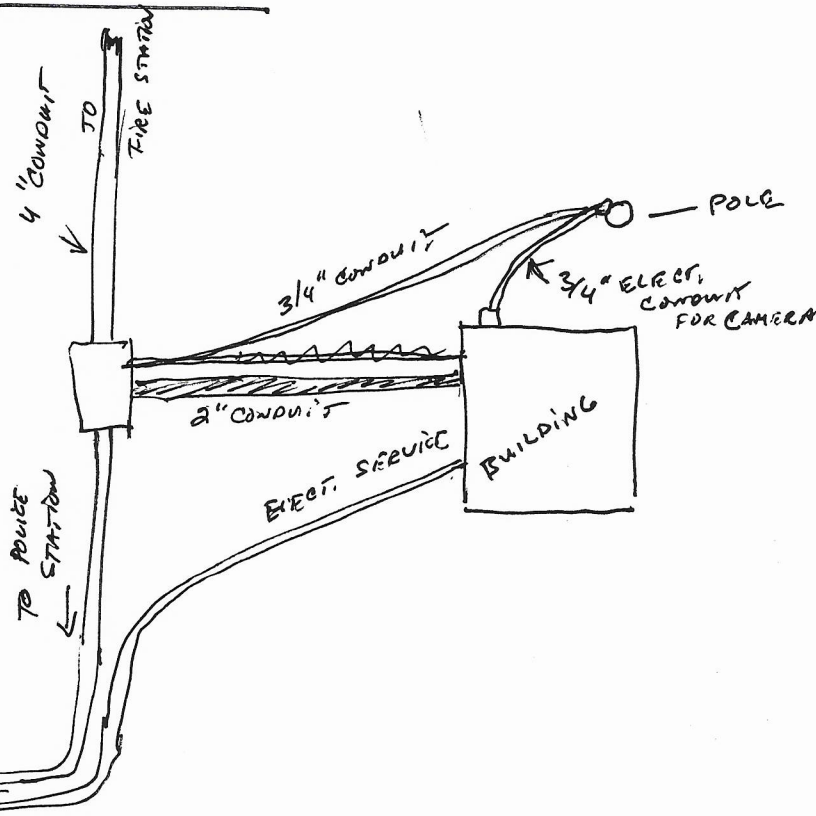

Water • Sewer • Drain • Gas

For your nearest EJP office call: **1-800-EJP-24HR**

www.ejprescott.com

e-mail: ejp@ejprescott.com