

Pipeline Specialists

TEAM



Everett J. Prescott, Inc.

JOB \_\_\_\_\_

SHEET \_\_\_\_\_

NO.: \_\_\_\_\_

CALCULATED \_\_\_\_\_

BY: \_\_\_\_\_


DATE \_\_\_\_\_

SCALE \_\_\_\_\_

285 Allen St

Sera Inspecto

7/28/08

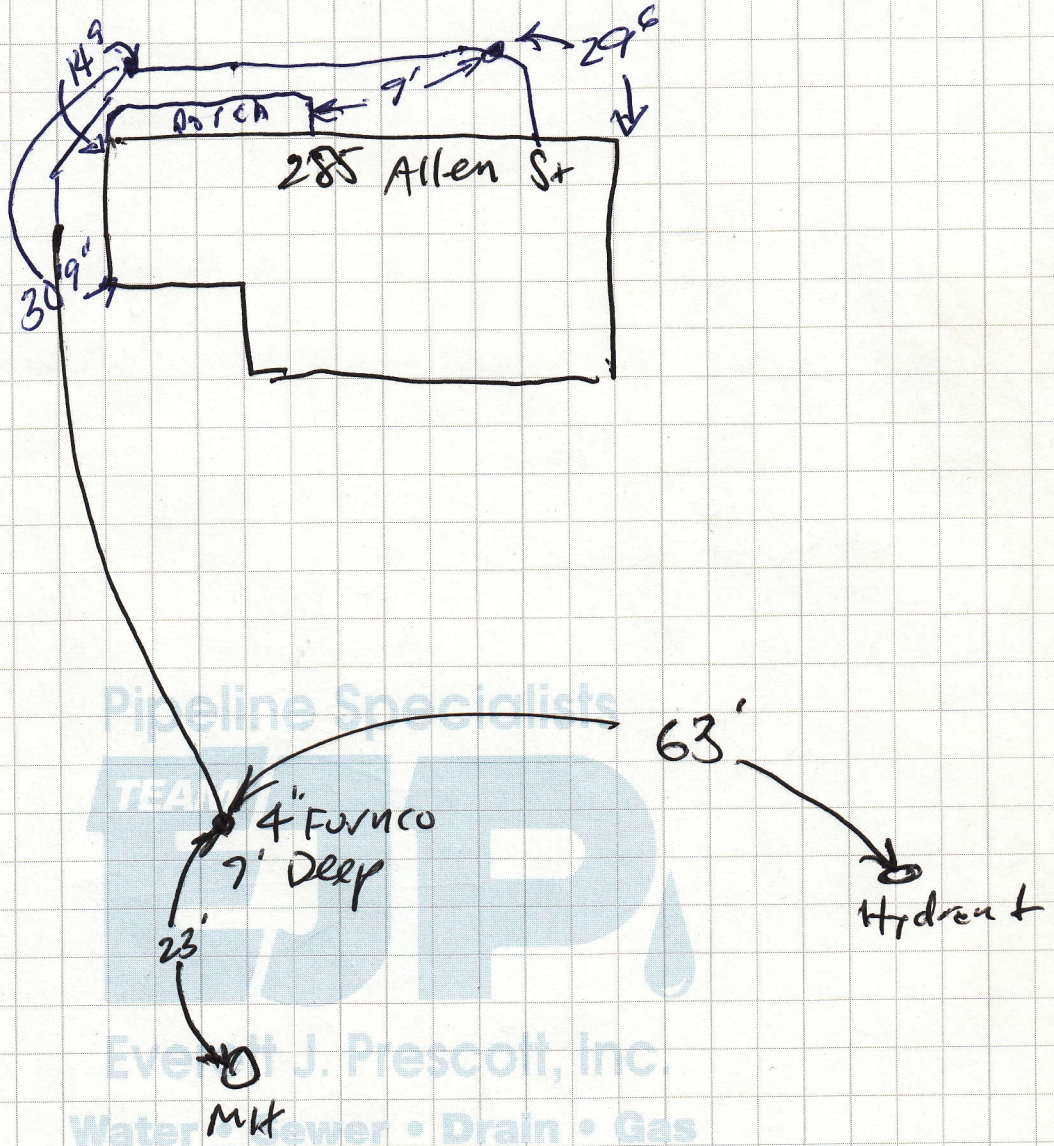

Serving  
The Northeast &  
Midwest

[www.ejprescott.com](http://www.ejprescott.com)  
1-800-EJP-24HR

24 Hour  
Emergency  
Service