


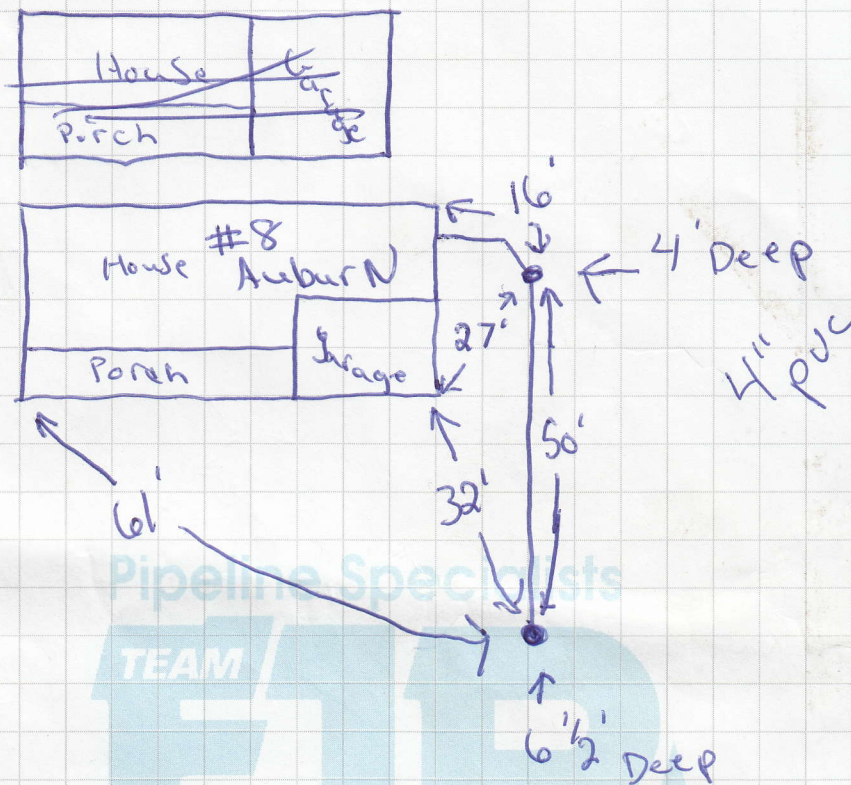

Everett J. Prescott, Inc.
Water • Sewer • Drain • Gas

Serving
The Northeast &
Midwest

24 Hour
Emergency
Service

www.ejprescott.com
1-800-EJP-24HR

7/2/13 Frank M.