


N

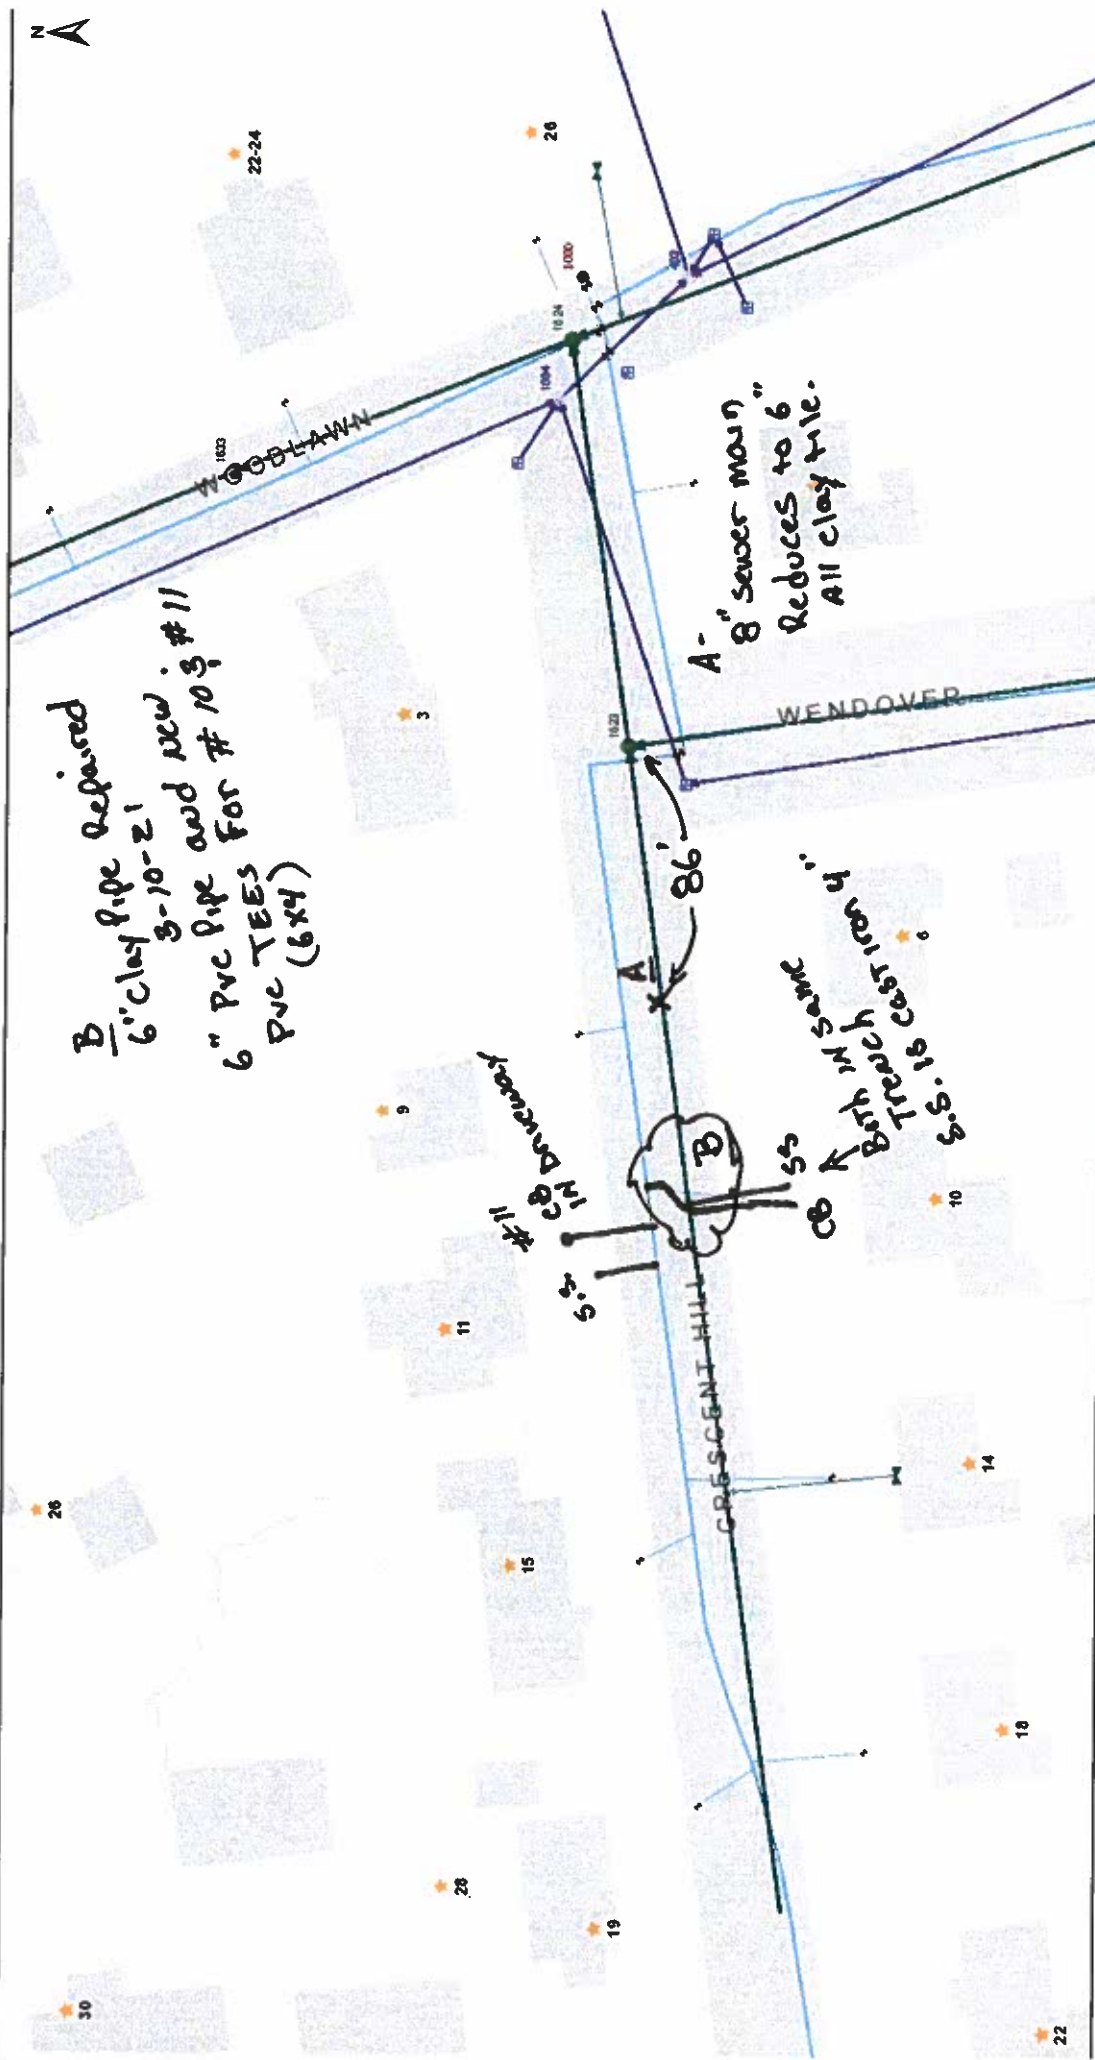

The Town of East Longmeadow and its mapping contractors assume no legal responsibility for the information contained herein.

These data are not suitable for engineering applications or other work nor can the data be used to determine absolute elevation. Instead, the data should be used for general planning and possible risks.

Map created by East Longmeadow Utilities
Cartography Copyright © 2021 by M&GIS.

1 inch = 47 feet
3/12/2021

- Active Sewer Main - Abandoned Sewer Main - Sewer Connection - Other Features - Well Wall - Pump Station - Other Fittings	- Band Fitting - The Wye Tee Sling Wye Sling - Cap Fitting - Chimney Fitting - Reducer - Sewer Lateral - Gravity Sewage Main - Forced Sewage Main	- Abandoned Gravity Sewage Main - Abandoned Forced Sewage Main - Concrete Easement - Shed Slope - Oil Slope - Catch Basin - Undigested Catch Basin - Other Drain Features	- Capped End - Flared End Structure - Manhole End - Rip-up - Drain Markholes - Outfalls - Drain Line - Open Channel - Culvert	- Detention Basin - Drain Easement - Hydrant - Other Water Rising - Band Fitting - Cap Fitting	- Cross Fitting - Plug Fitting - Reducer - Top Fitting - The Fitting - Coupling - Other Water Valve - Gate Valve - Butterfly Valve - Blow Off Valve	- Other Service Valve - Gate Valve - Butterfly Valve - Blow Off Valve - Other Water Feature - Thrust Protection	- Water Meter Pit - Water Pumping Station - Fire Pump - Sample Station - Water Tank - Water Main - Abandoned / Inactive Water Main - Proposed Water Main	- Abandoned Water Lateral - Proposed Water Lateral - Water Lateral - Water Easement - Easement Boundaries - Break Out Taps - UNTs - Pipeline
--	--	--	---	---	--	--	---	---