EAST LONGMEADOW DEPARTMENT OF PUBLIC WORKS

Job: 34 Halon Terr. But located on Pease Rd. (Sewer)

Sheet No: _____ of _____

Calculated By: Pope Date 7-3-2019
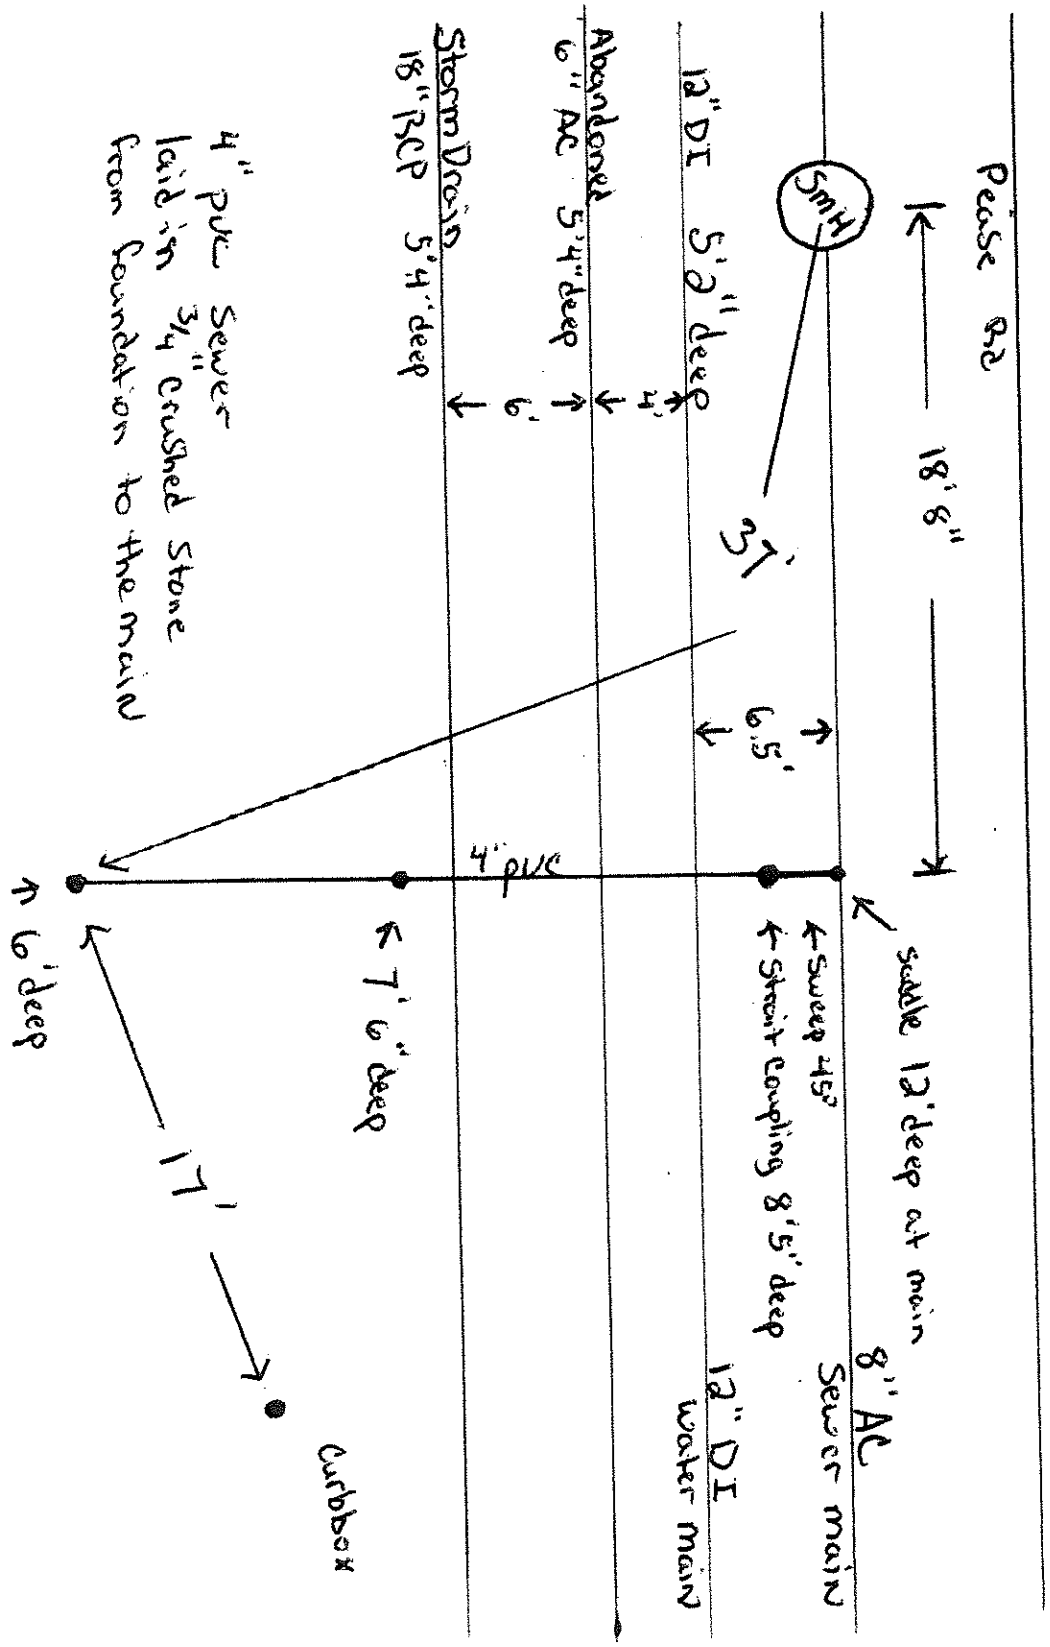
Scale: _____