




Page 5

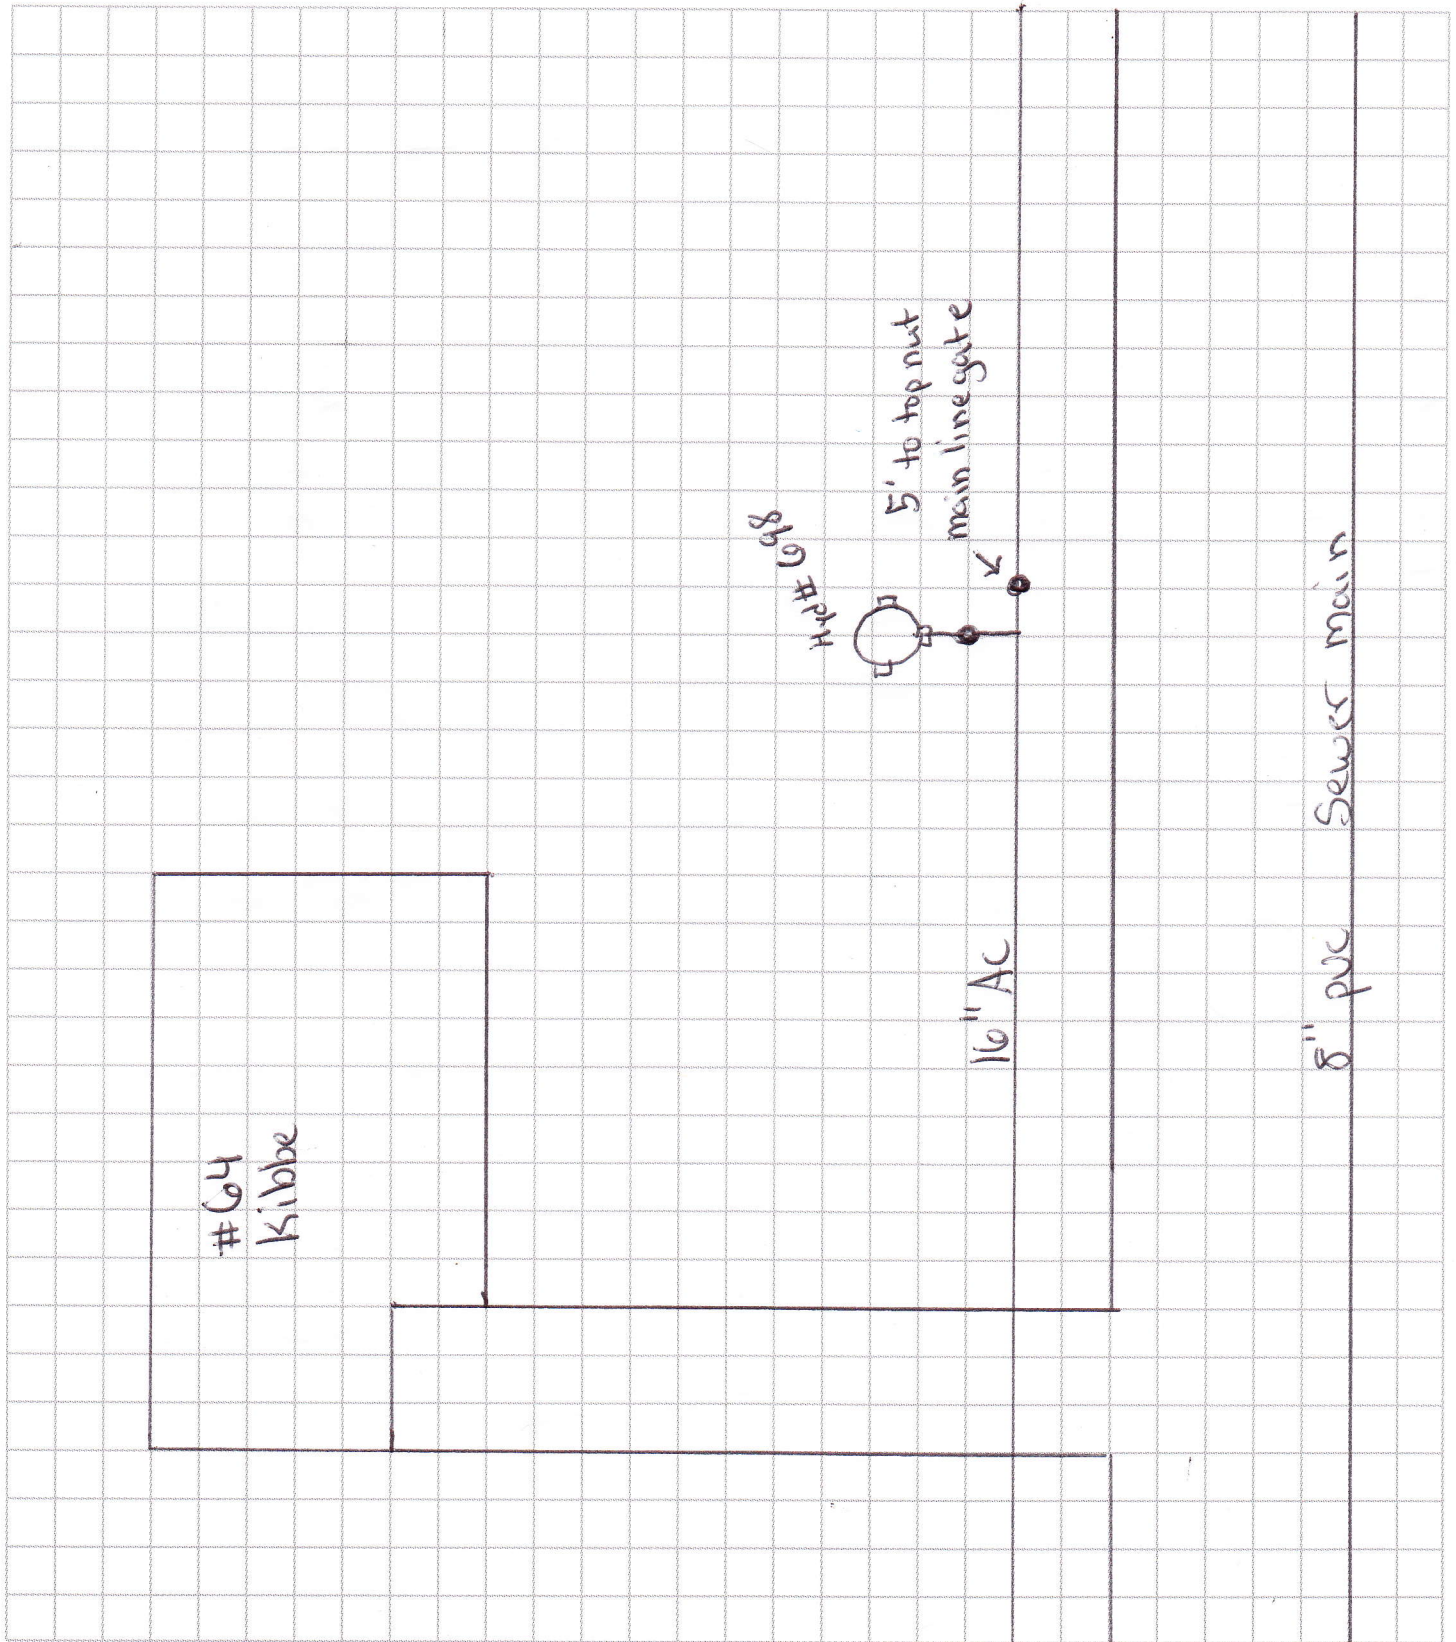


Page 4

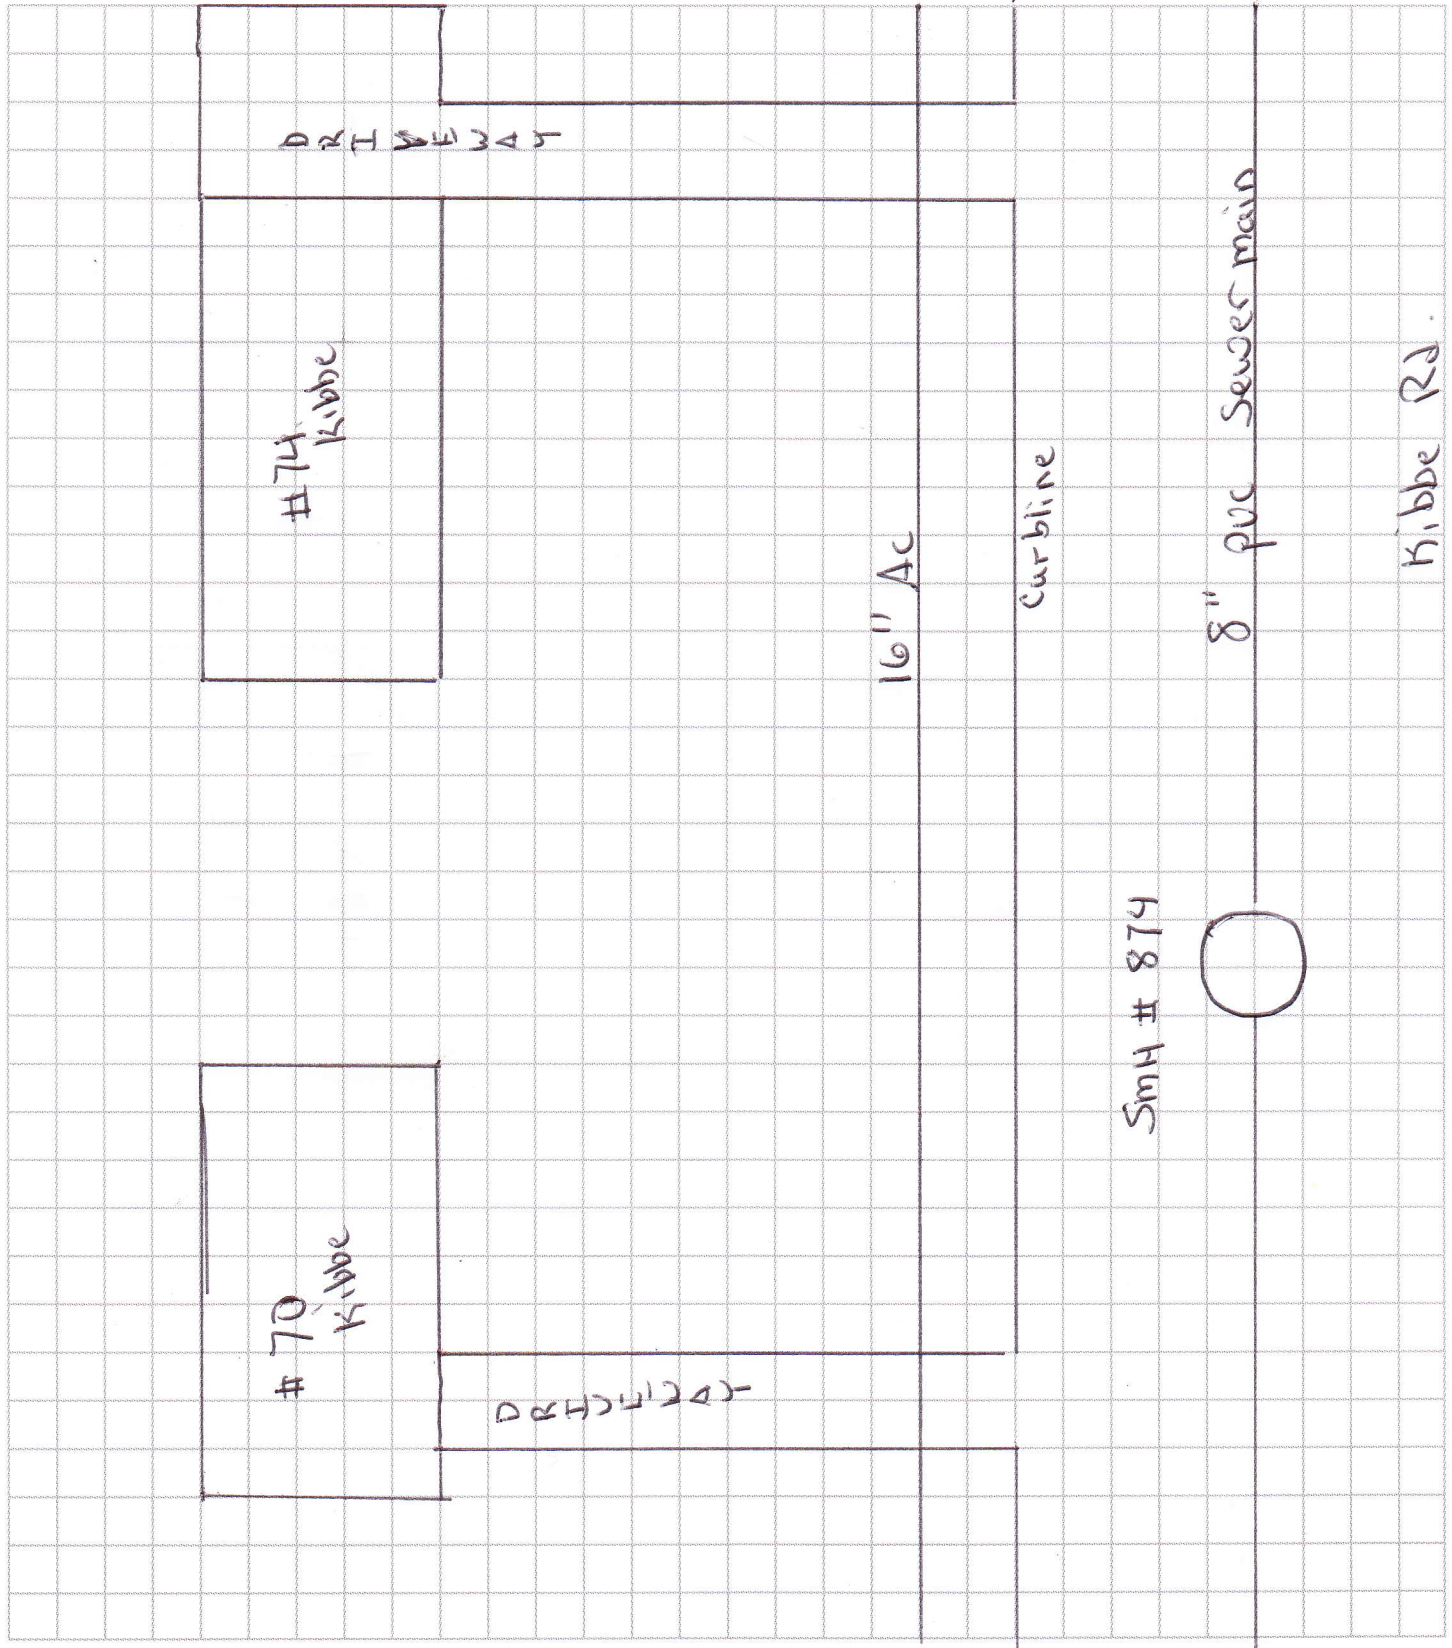

Page 3

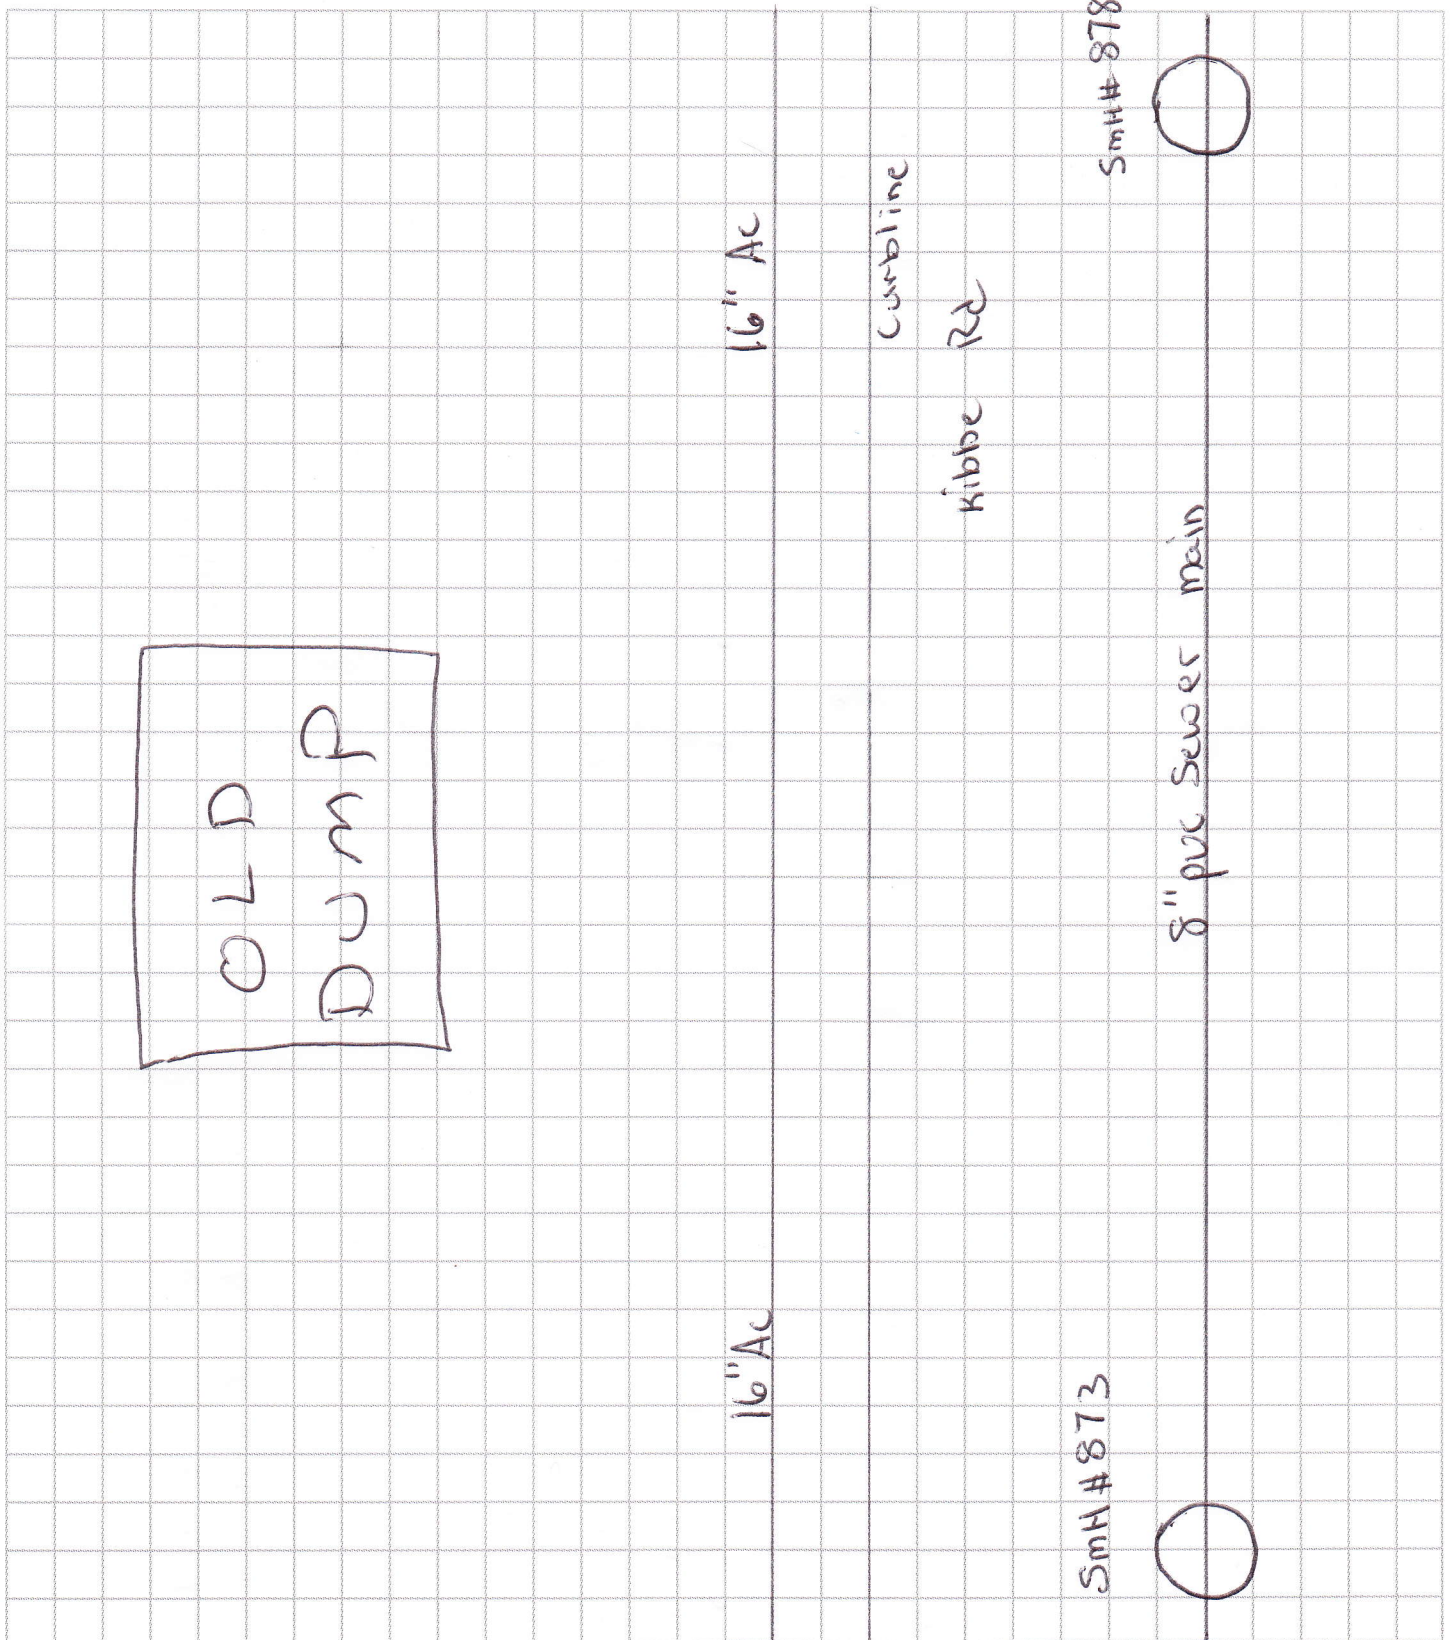

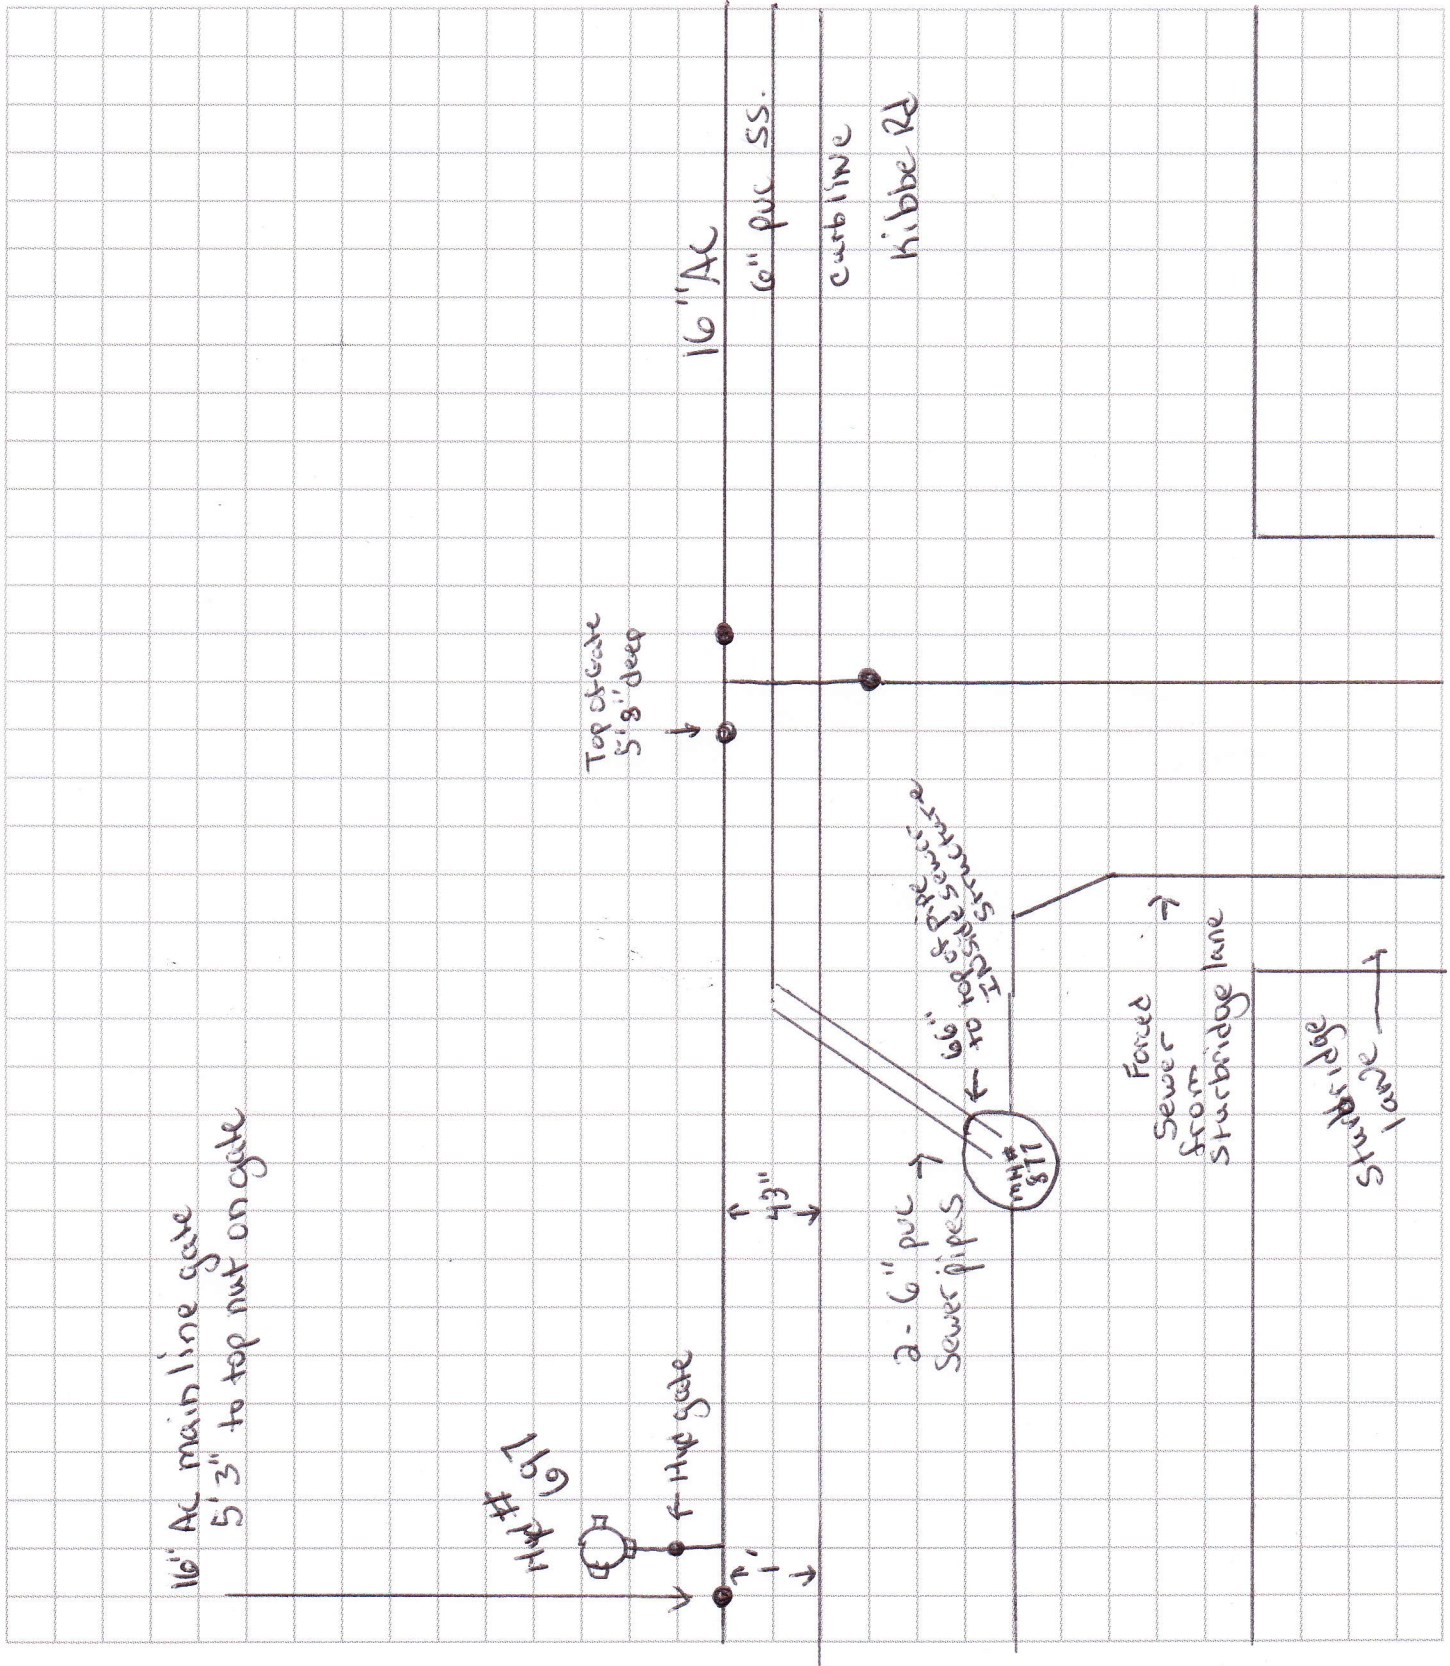

KAMAN

Automation, Control & Energy

MINNESOTA ZELLER

Kibbe Rd

5-8-17

#124 - #64

KIT Zeller, Inc.

1000 University Ave

Suite 800

Rochester, NY 14607

P: 585.254.8840

F: 585.254.0002

www.kamanac.com

Page 21

