No. Street (San. Sewer) Lot No.
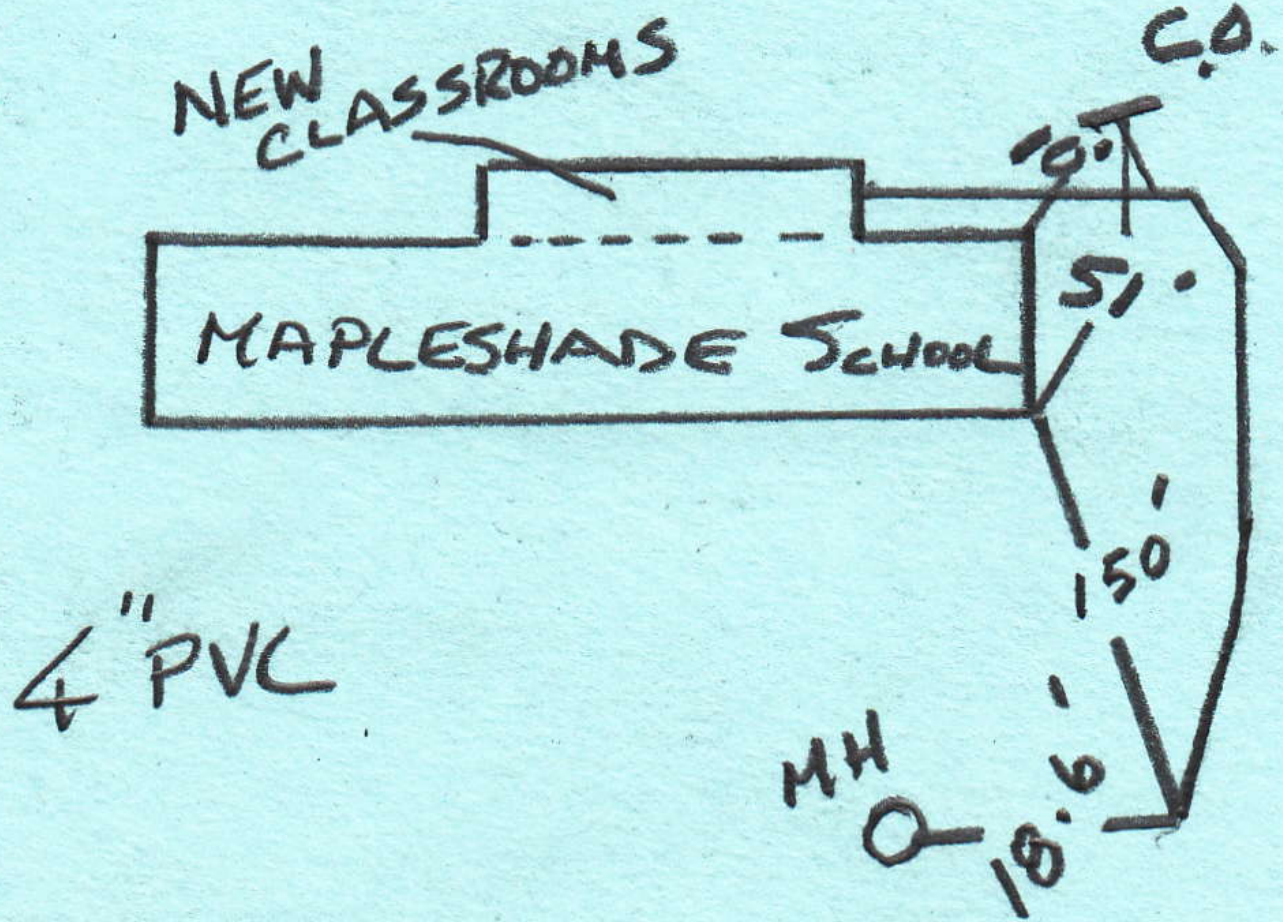
175 MAPLESHADE AVE Inspected 8-7-07