EAST LONGMEADOW DEPARTMENT OF PUBLIC WORKS

Job: 329 Pease Rd. (Sewer) Repair

Sheet No: Repair Done by Skinner of

Calculated By: Pope Date 2-17-21

Scale:

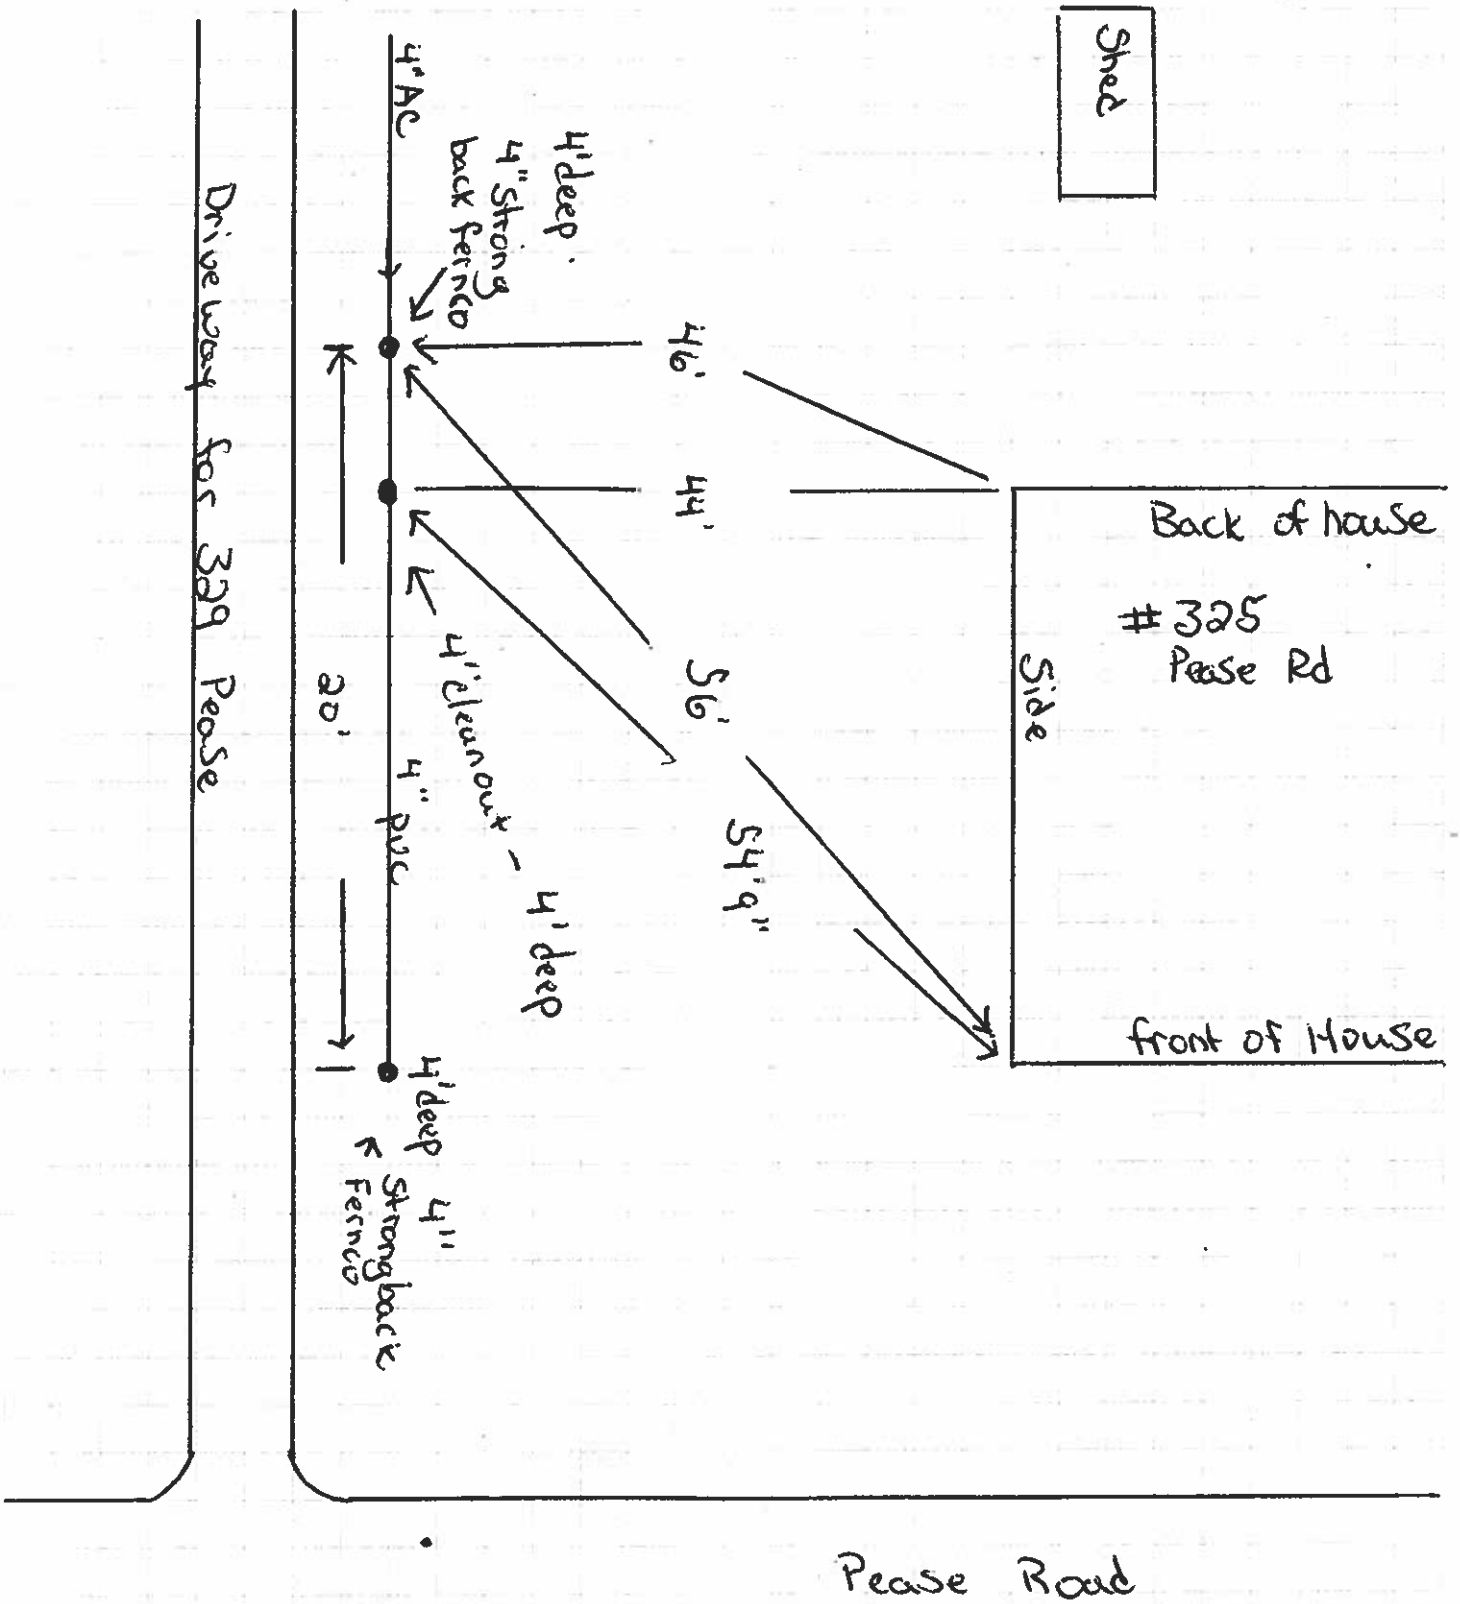

POS Reorder # 1923506