EAST LONGMEADOW DEPARTMENT OF PUBLIC WORKS

Job: 134 Shaker Rd (Sewer)

Sheet No: Sewer Repair - Gary Turnbury of

Calculated By: Date

Scale:

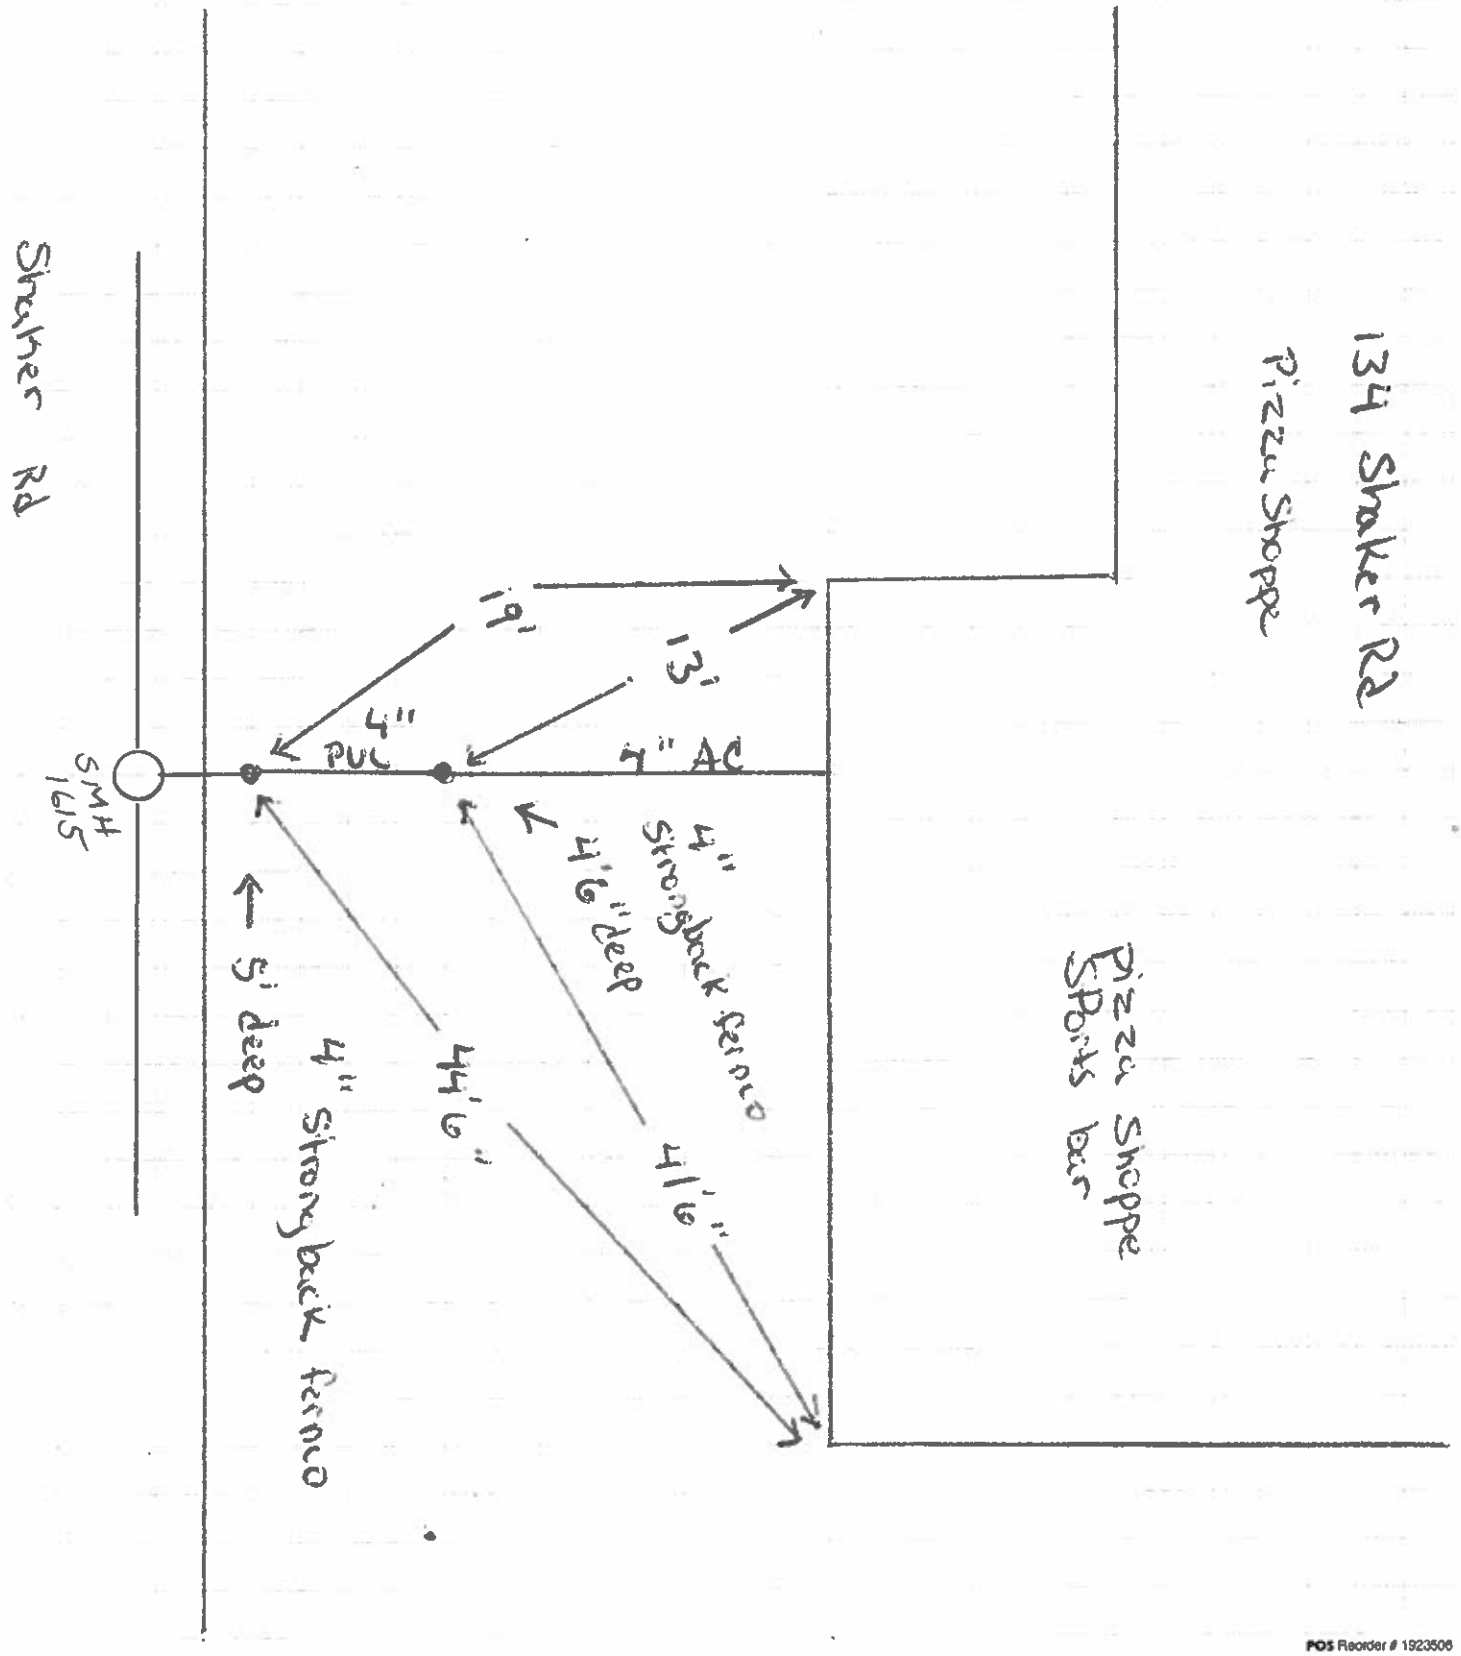

POS Reorder # 1923506