EAST LONGMEADOW DEPARTMENT OF PUBLIC WORKS

Job: 32 Speight Arden

Sheet No: _____ of _____

Calculated By: Crochetiere Date 10-6-2021
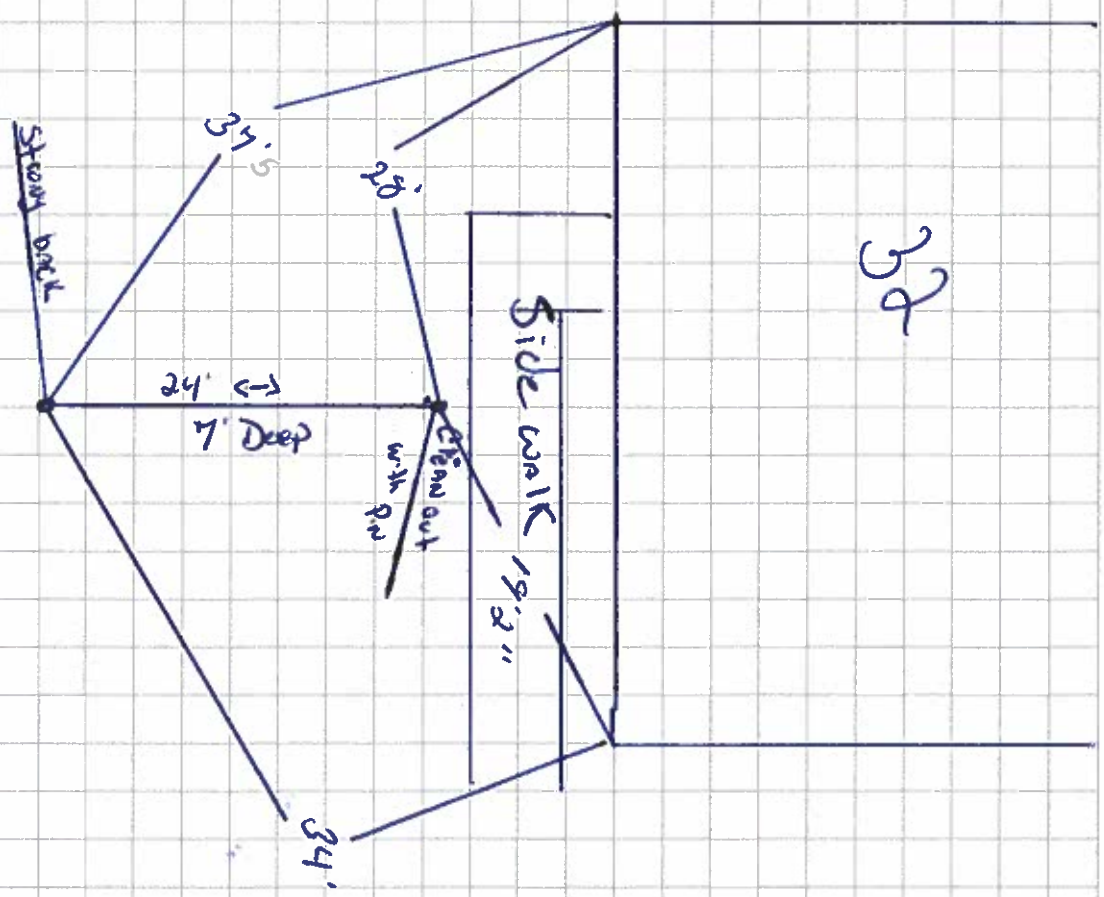
Scale: Sewer Repair Ties.