Pipeline Specialists

TEAM EJP

Everett J. Prescott, Inc.

JOB

SHEET NO.: WATER CURB Box ties OF

CALCULATED BY: RJC DATE 10/24/14

SCALE

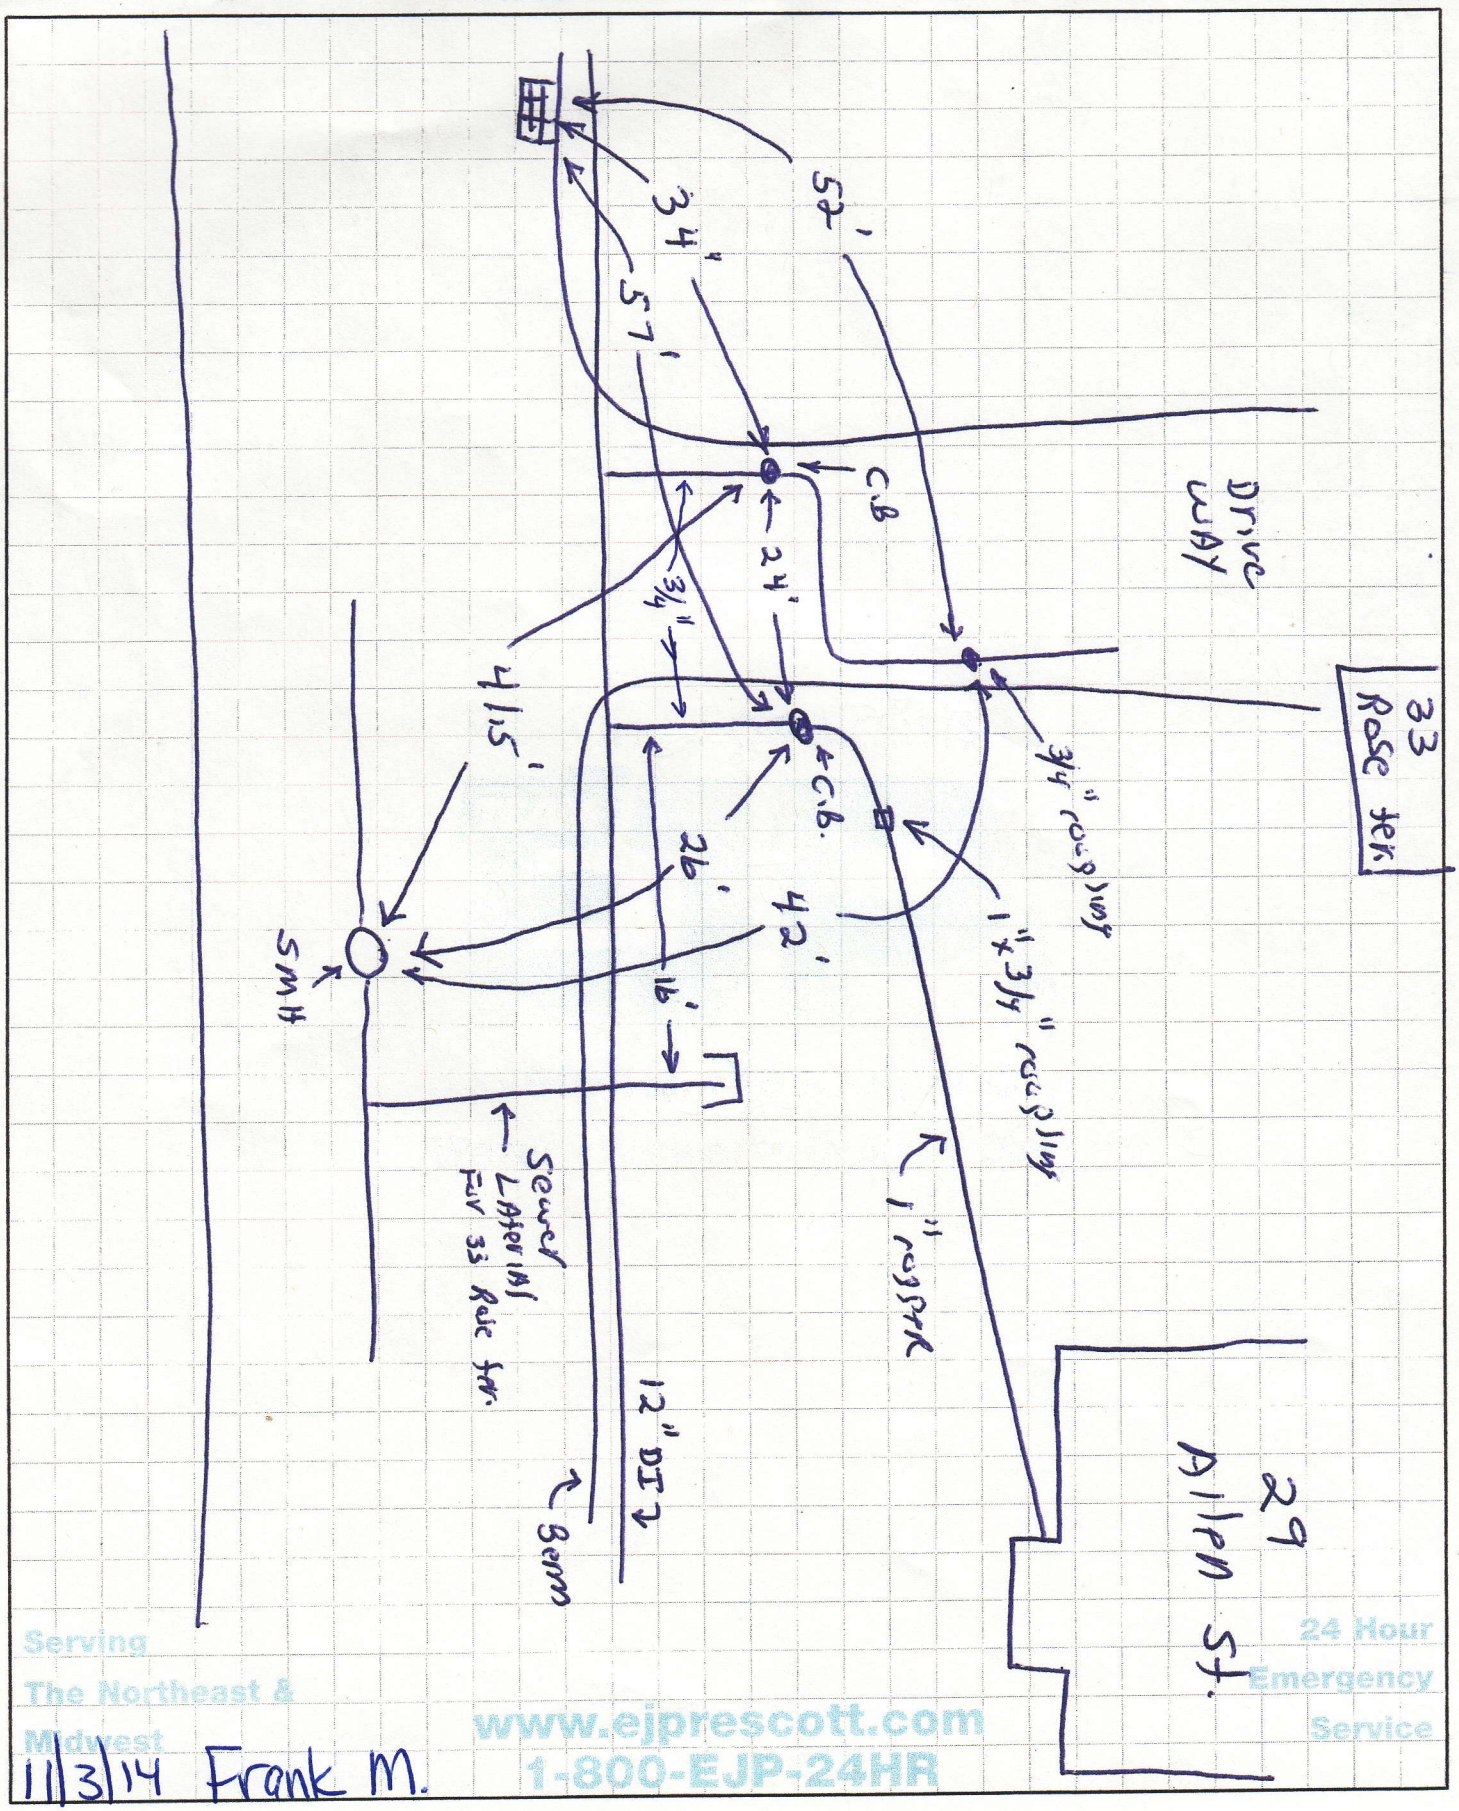

11/3/14 Frank M.

Serving The Northeast & Midwest

www.ejprescott.com

1-800-EJP-24HR

24 Hour Emergency Service