


7 Auburn Street

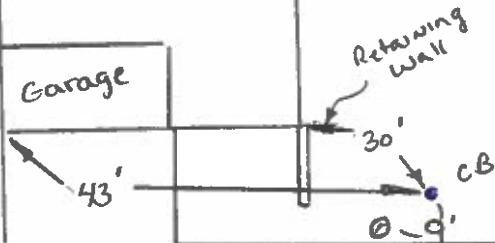

Auburn Street