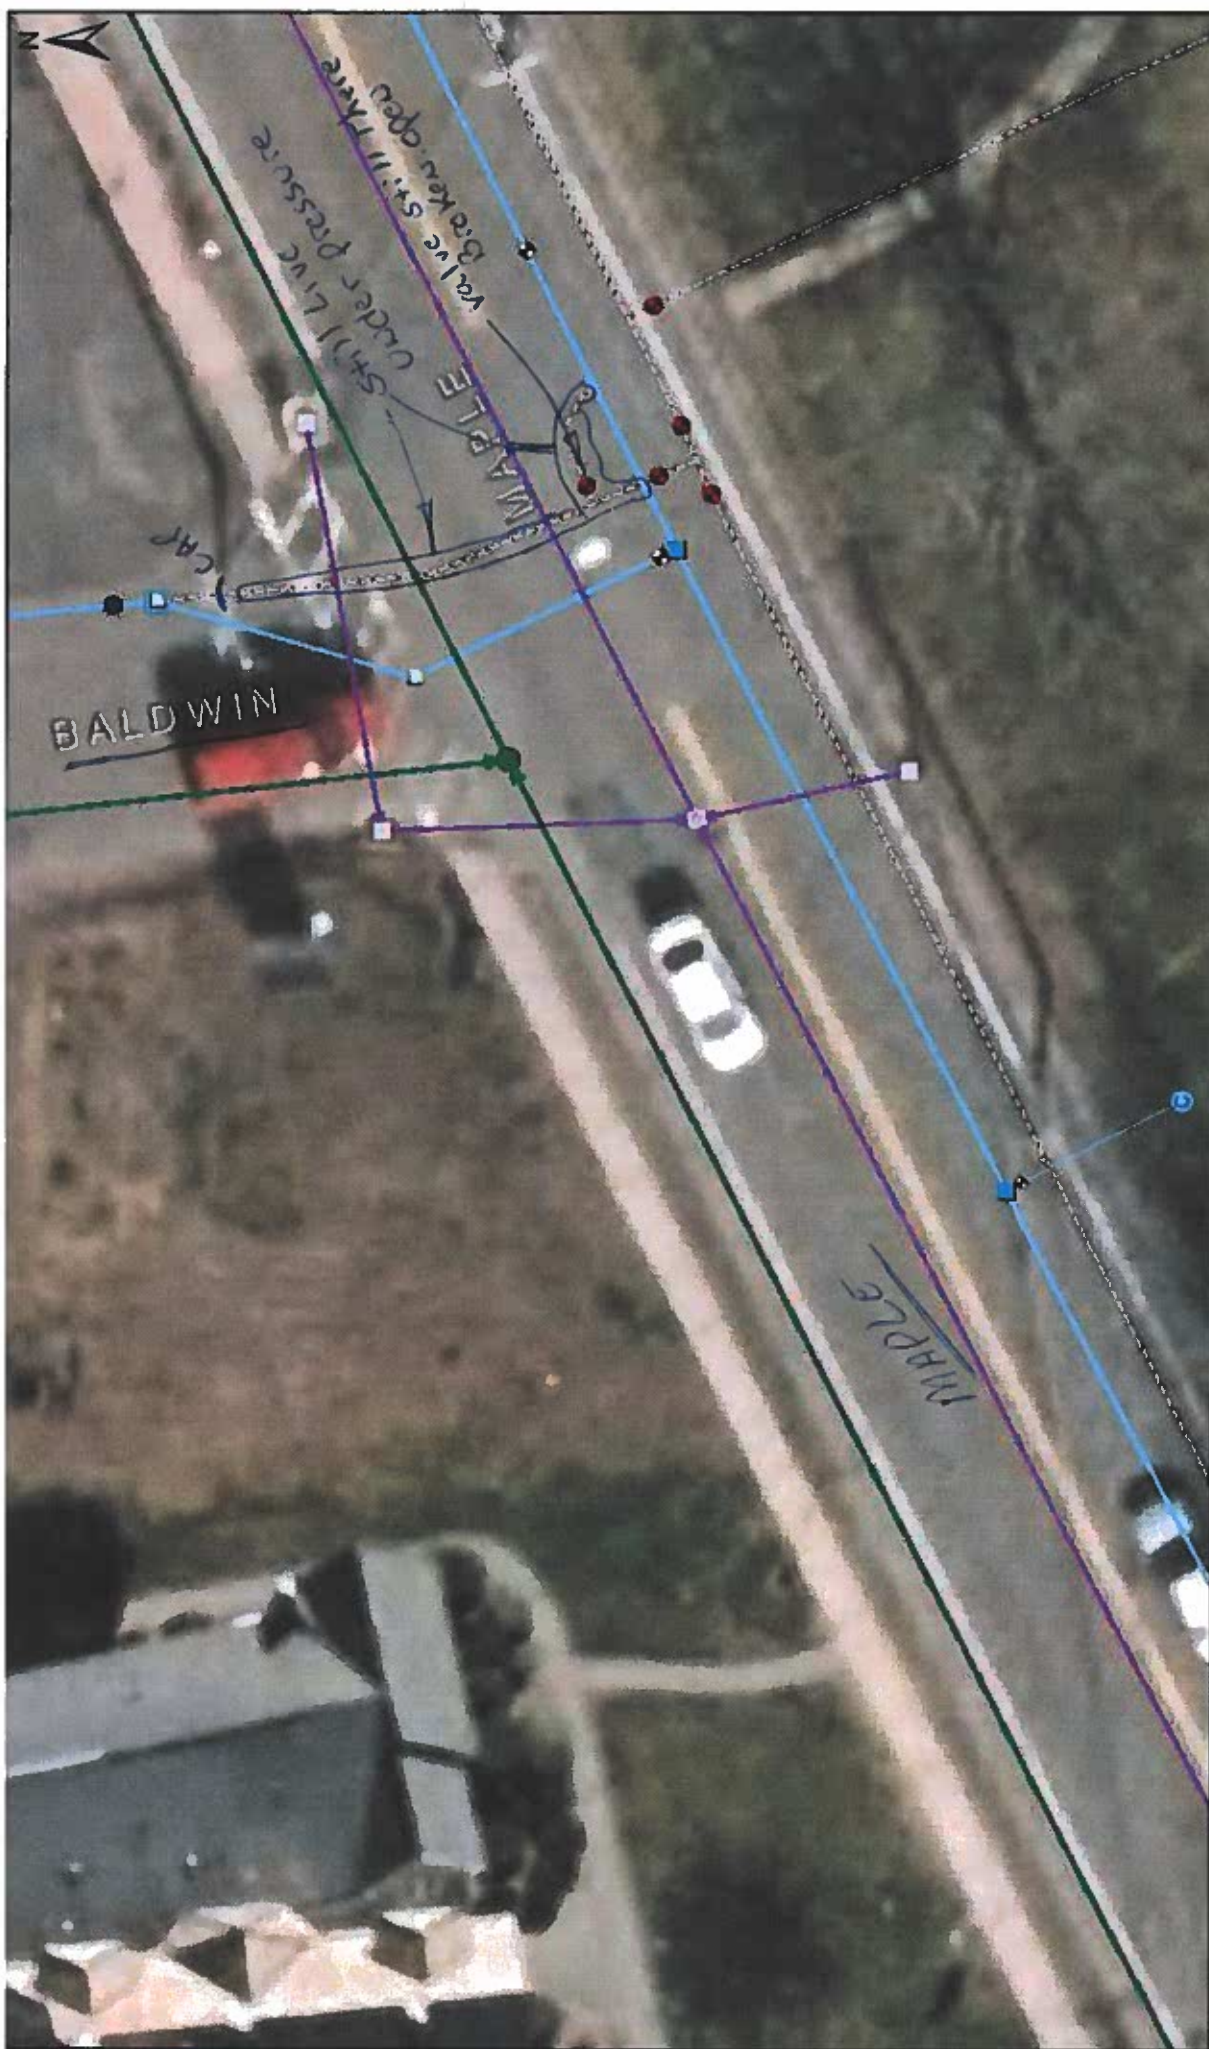


1 inch = 24 feet
9/23/2020

- Active Sewer Manhole - Abandoned Sewer Manhole - Sewer Connection - Other Features - Wet Well - Pump Station - Other Fittings - Band Fitting - Tea Wye, Tee fitting, Wye fitting - Cap fitting - Clean-out fitting	- Chimney fitting - Reducer - Sewer Lateral - Gravity Sewage Main - Forced Sewage Main - Abandoned Gravity Sewage Main - Abandoned Forced Sewage Main - Concrete Encasement - Steel Sleeve - DI Sleeve - Catch Basin	- Undigested Catch Basin - Other Drain Features - Capped End - Flood End Structure - Headwall, Endwall - Rip-rap - Drain Manholes - Outlets - Drain Line - Open Channel - Culvert	- Detention Basin - Drain Encasement - Hydrant - Other Water Fitting - Band Fitting - Cap Fitting - Cross Fitting - Plug Fitting - Reducer - Tap Fitting - Tee Fitting	- Coupling - Other Water Valve - Gate Valve - Butterfly Valve - Blow Off Valve - Other Service Valve - Gate Valve - Butterfly Valve - Blow Off Valve - Other Water Feature - Thrust Protection	- Water Meter Pit - Water Pumping Station - Fire Pump - Sample Station - Water tank - Water Main - Abandoned / Inactive Water Main - Proposed Water Main - Abandoned Water Lateral - Proposed Water Lateral	- Water Lateral - Water Encasement - Encasement Boundaries - Break Out Tees - LNG's - Pipelines
--	--	---	--	--	--	--