EAST LONGMEADOW DEPARTMENT OF PUBLIC WORKS

Job: Lot #7 Bella Vista Water Service

Sheet No: 1 of 2

Calculated By: Fois Date 9/9/20
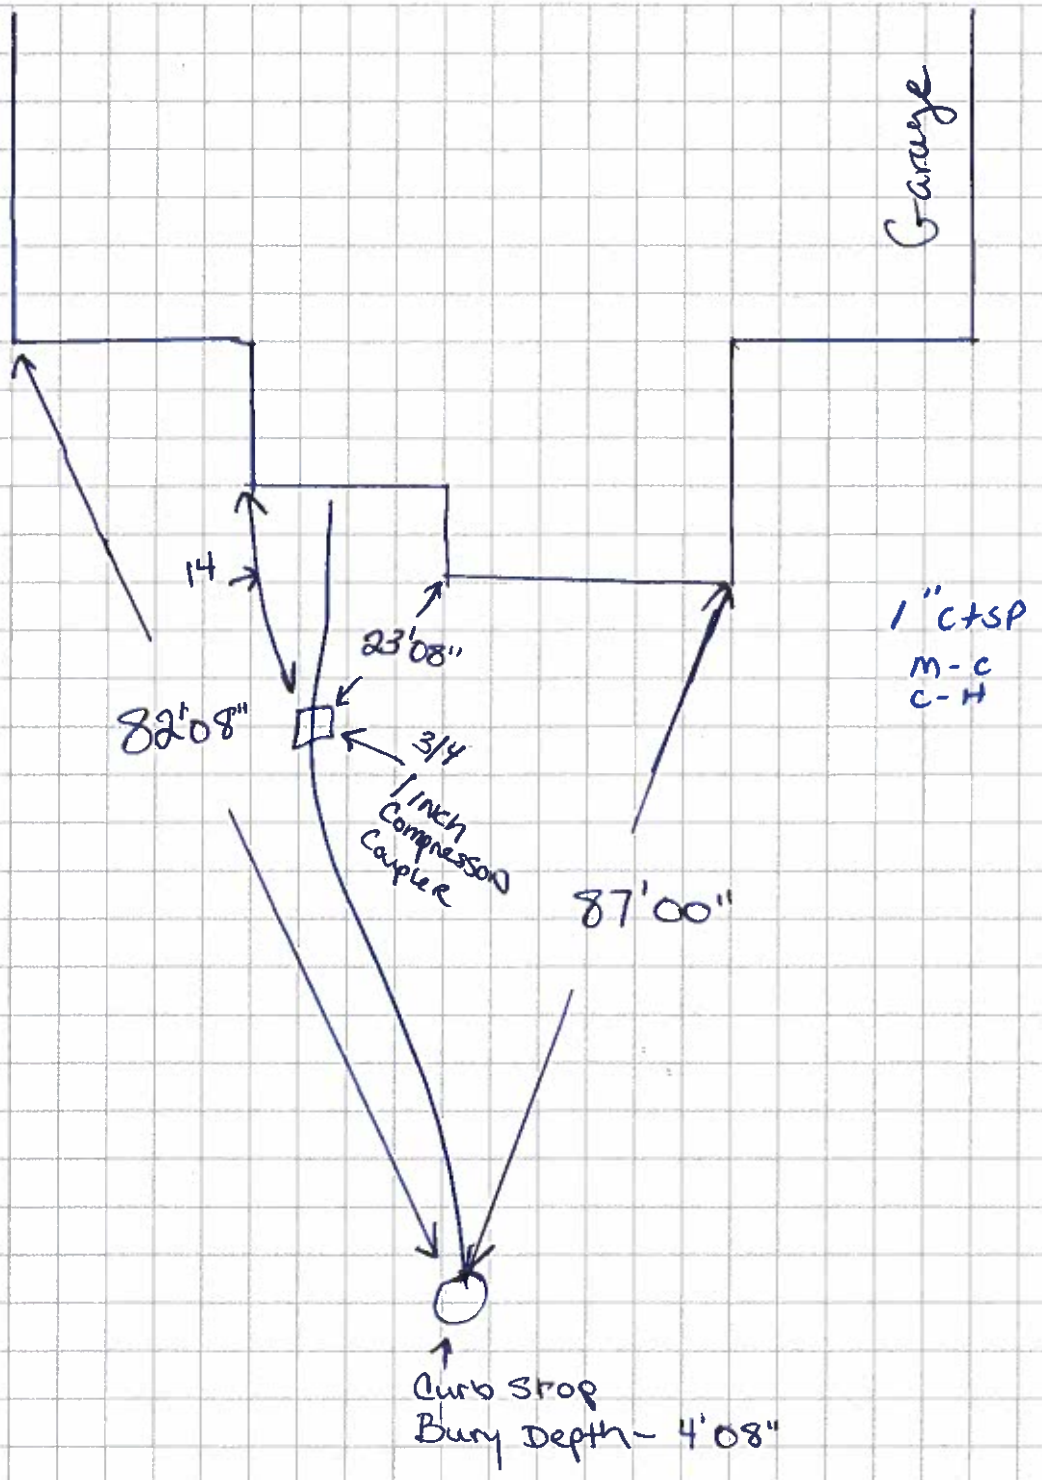
Scale: Feet.