EAST LONGMEADOW DEPARTMENT OF PUBLIC WORKS

Job: 31 Benton Dr. (water).

Sheet No: _____ of _____

Calculated By: Pope Date 11-18-2022

Scale: Excavator - Skinner Excavation

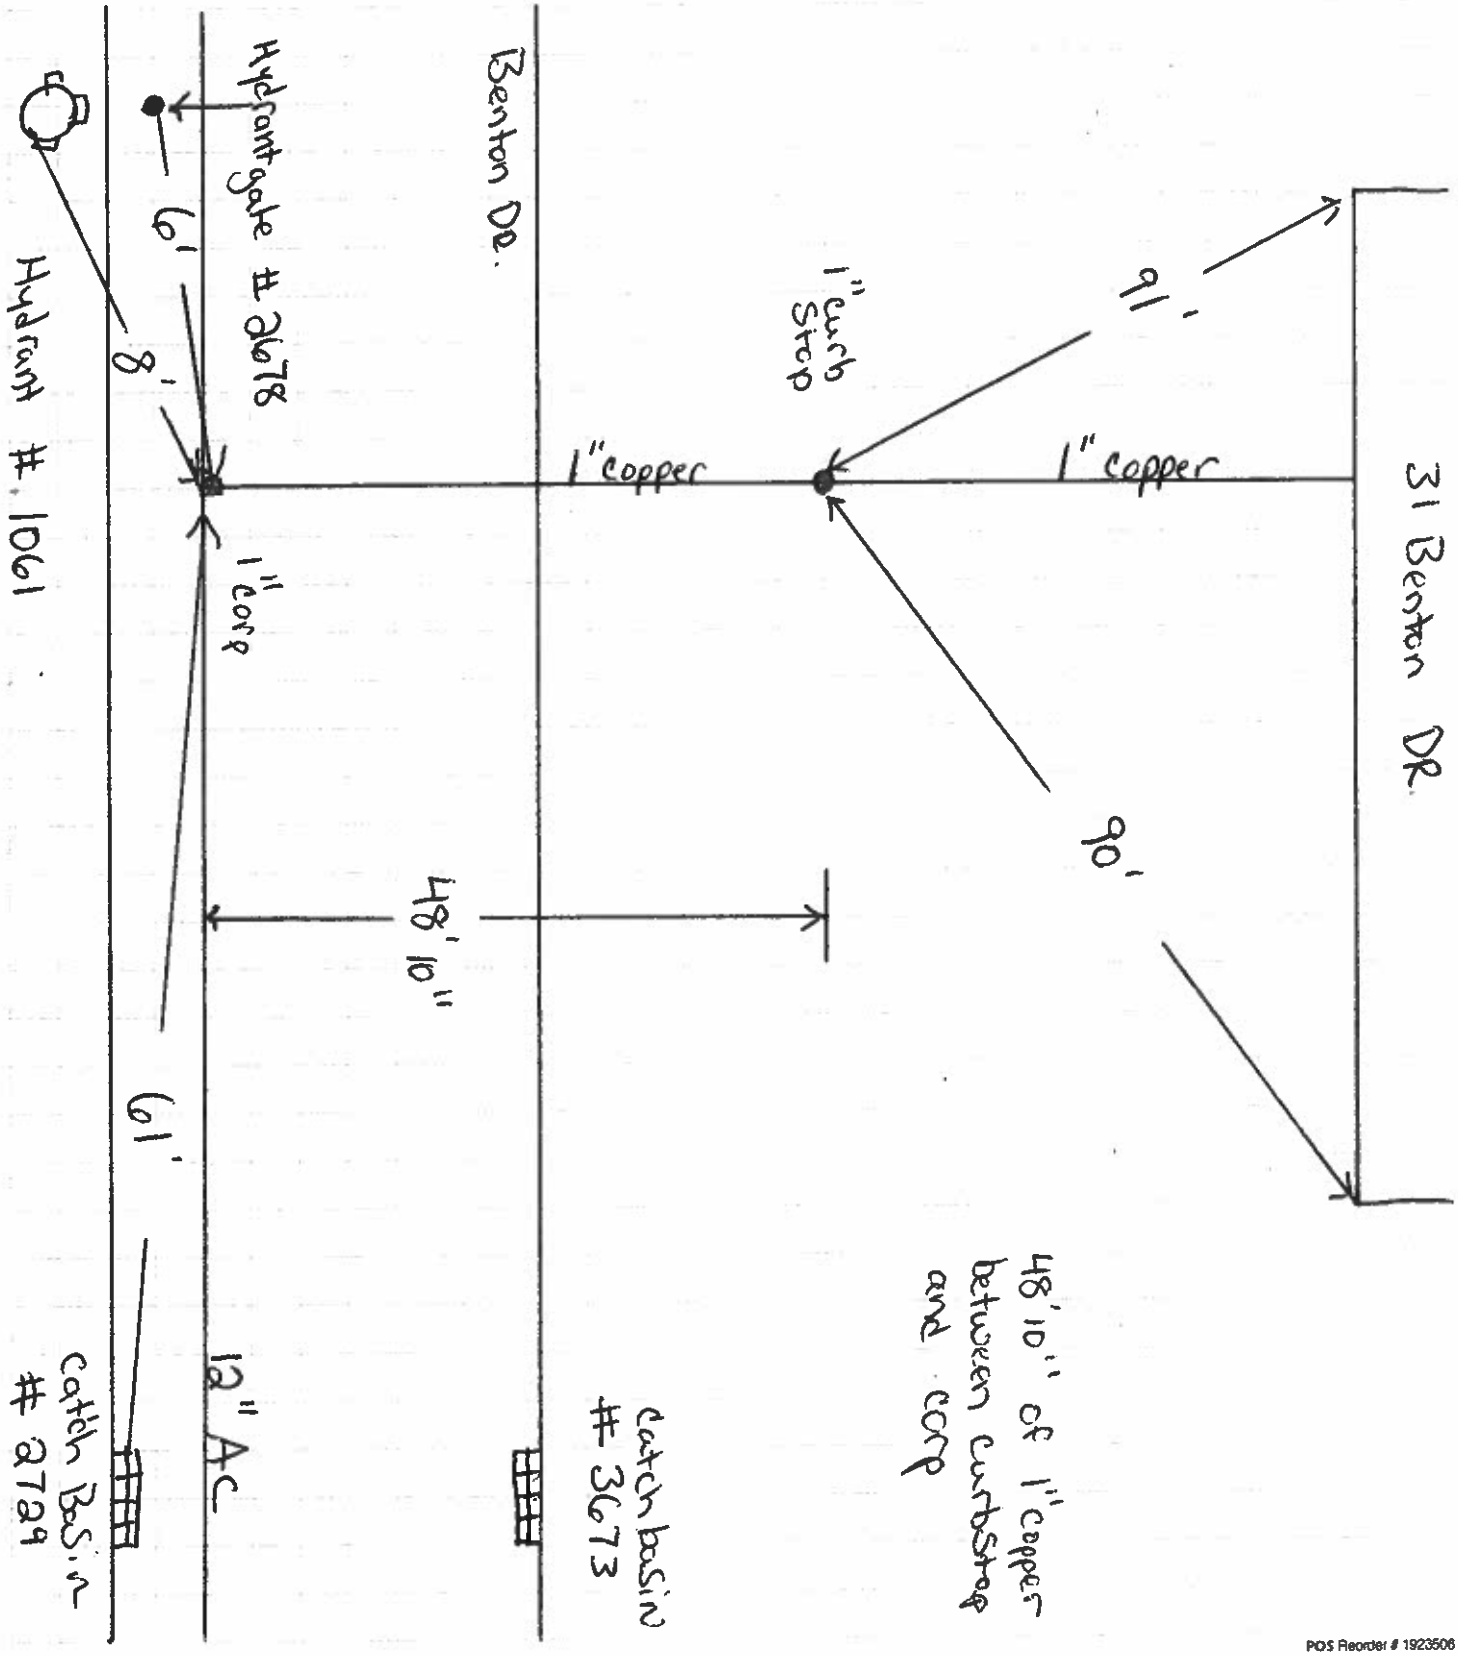

POS Reorder # 1923506