

No. 54 Carol Ann

Street

Owner Premium Homes Inc.

S. R. 710401

Date


6-26-71

Work Done

Service pipe laid by M. Cunningham

Buffalo box in st. over 1" IK made onto 3/4" corp.,
59'0" out from house, 3'4" N of S line of house,
36'5" S of N line of house, 10'9" SW of hydt.

60'0" 3/4" C.T. BY DEPT.

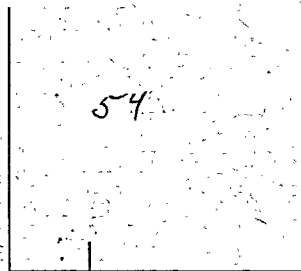

65'

3'-4"

36'-5"

1" I.K.

8" MAIN

3" CORP.

10'-9"

HYD.

CAROL ANN

STREET.