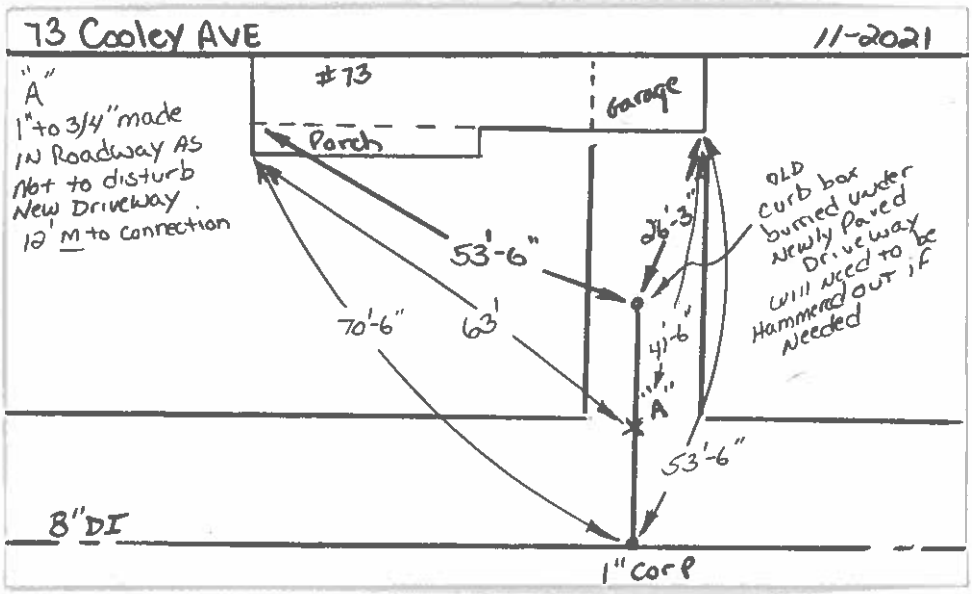
73 Cooley AVE
11-2021
"A"
1" to 3/4" made
IN Roadway AS
Not to disturb
New Driveway.
#73
Garage
Porch
53'-6"
26'-3"
OLD
curb box
buried under
Newly Paved
Driveway
Will need to be
Hammered OUT if
Needed
70'-6"
63'
41'-6"
"A"
53'-6"
8" DI
1" Corp